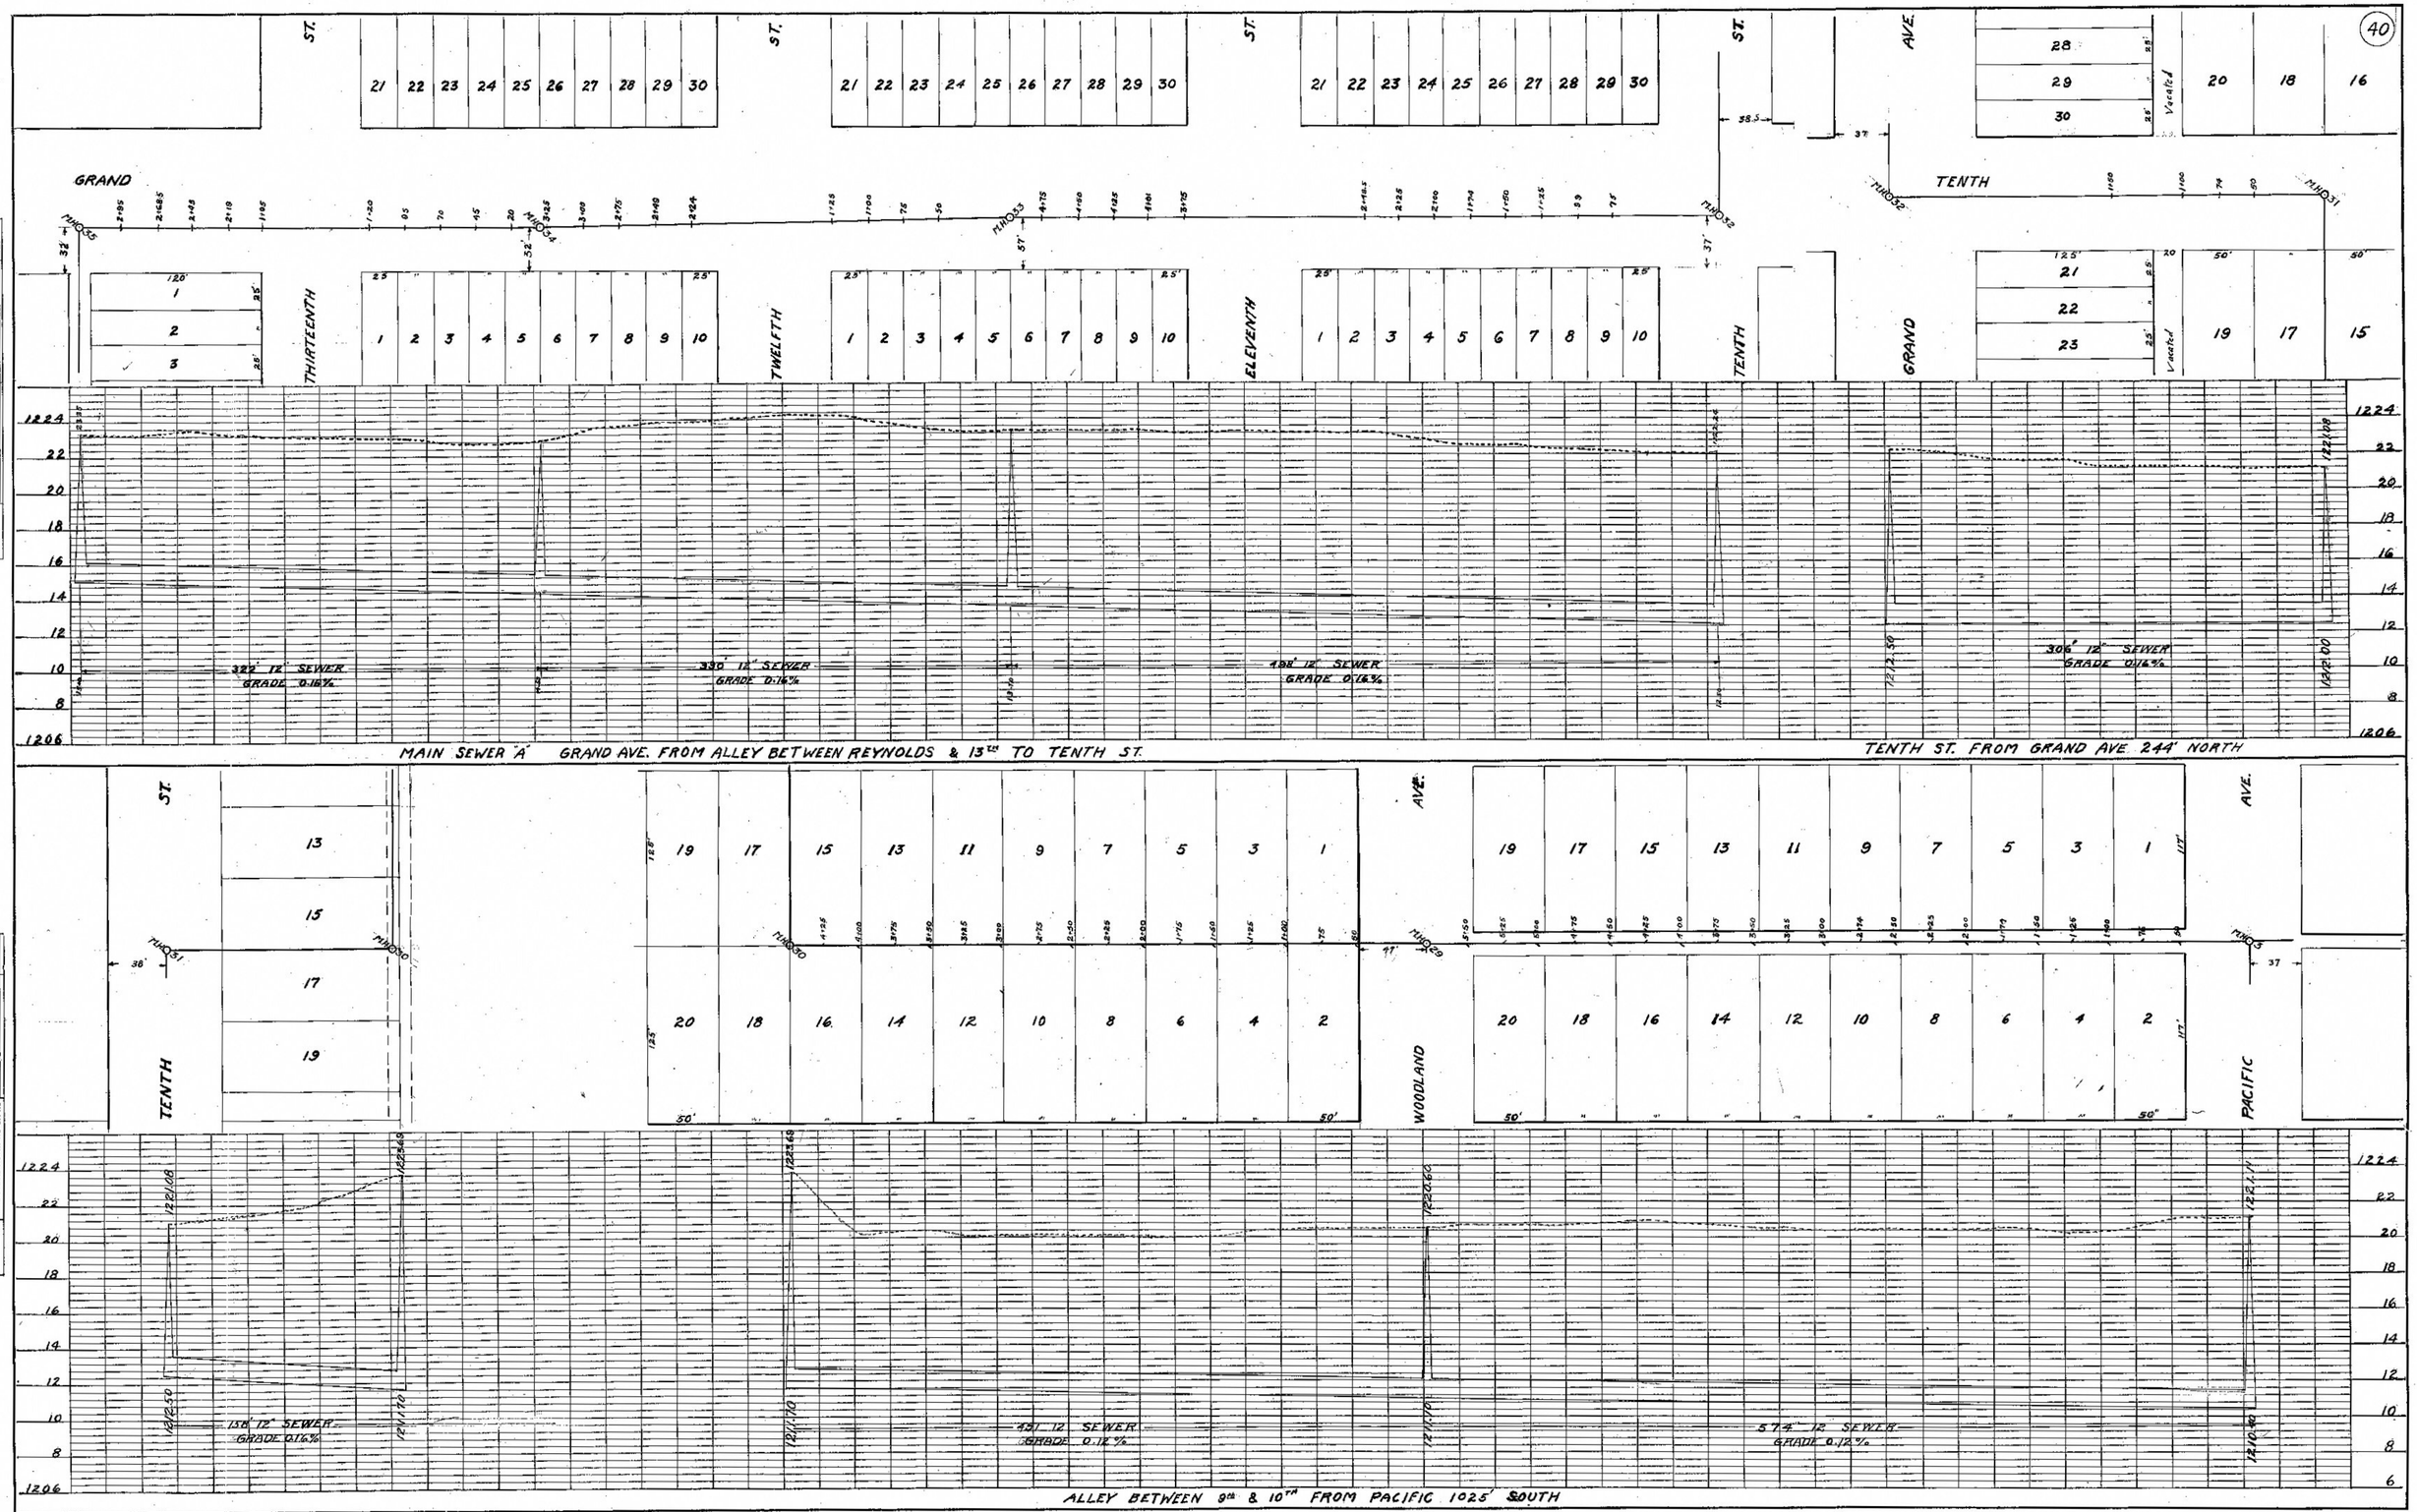
40
GRAND
TENTH
THIRTEENTH
TWELFTH
ELEVENTH
TENTH
GRAND
AVE.
ST.
Vacated
322' 12" SEWER GRADE 0.16%
330' 12" SEWER GRADE 0.16%
198' 12" SEWER GRADE 0.16%
306' 12" SEWER GRADE 0.16%
MAIN SEWER "A" GRAND AVE. FROM ALLEY BETWEEN REYNOLDS & 13TH TO TENTH ST.
TENTH ST. FROM GRAND AVE. 244' NORTH
TENTH
WOODLAND
PACIFIC
150' 12" SEWER GRADE 0.16%
431' 12" SEWER GRADE 0.12%
574' 12" SEWER GRADE 0.12%
ALLEY BETWEEN 8TH & 10TH FROM PACIFIC 1025' SOUTH
PLAN
NOTE BOOK
SURVEYED
PLOTTED
ALIGNMENT CHECKED
RT. OF WAY CHECKED
NO.
DATE
BY
PROFILE
GRADES CHECKED
B. M. NOTED
STRUCTURE NOTATIONS CK'KD
H.E. WURST
A.A. CAMPBELL
PLATE 2-PLAN-PROFILE B. P. N. STANDARD
MAIN SEWER "A"
EUGENE DIETZGEN CO., CHICO., N.Y.