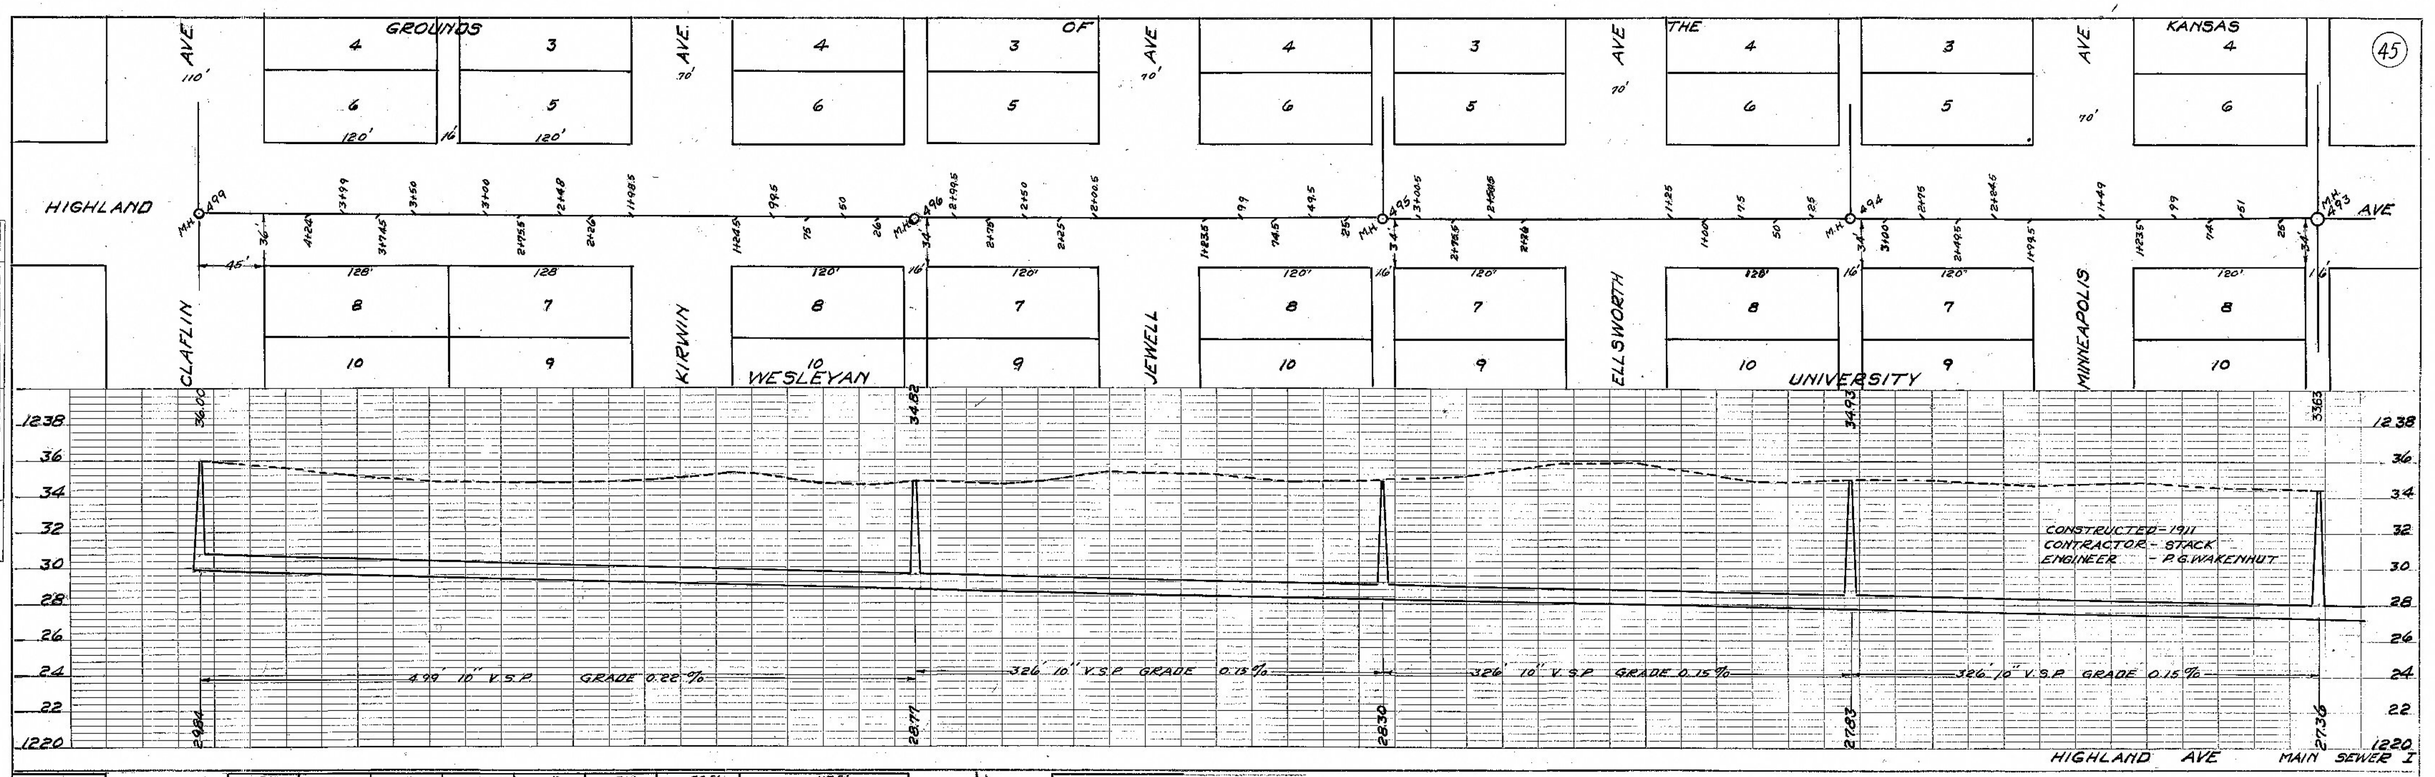

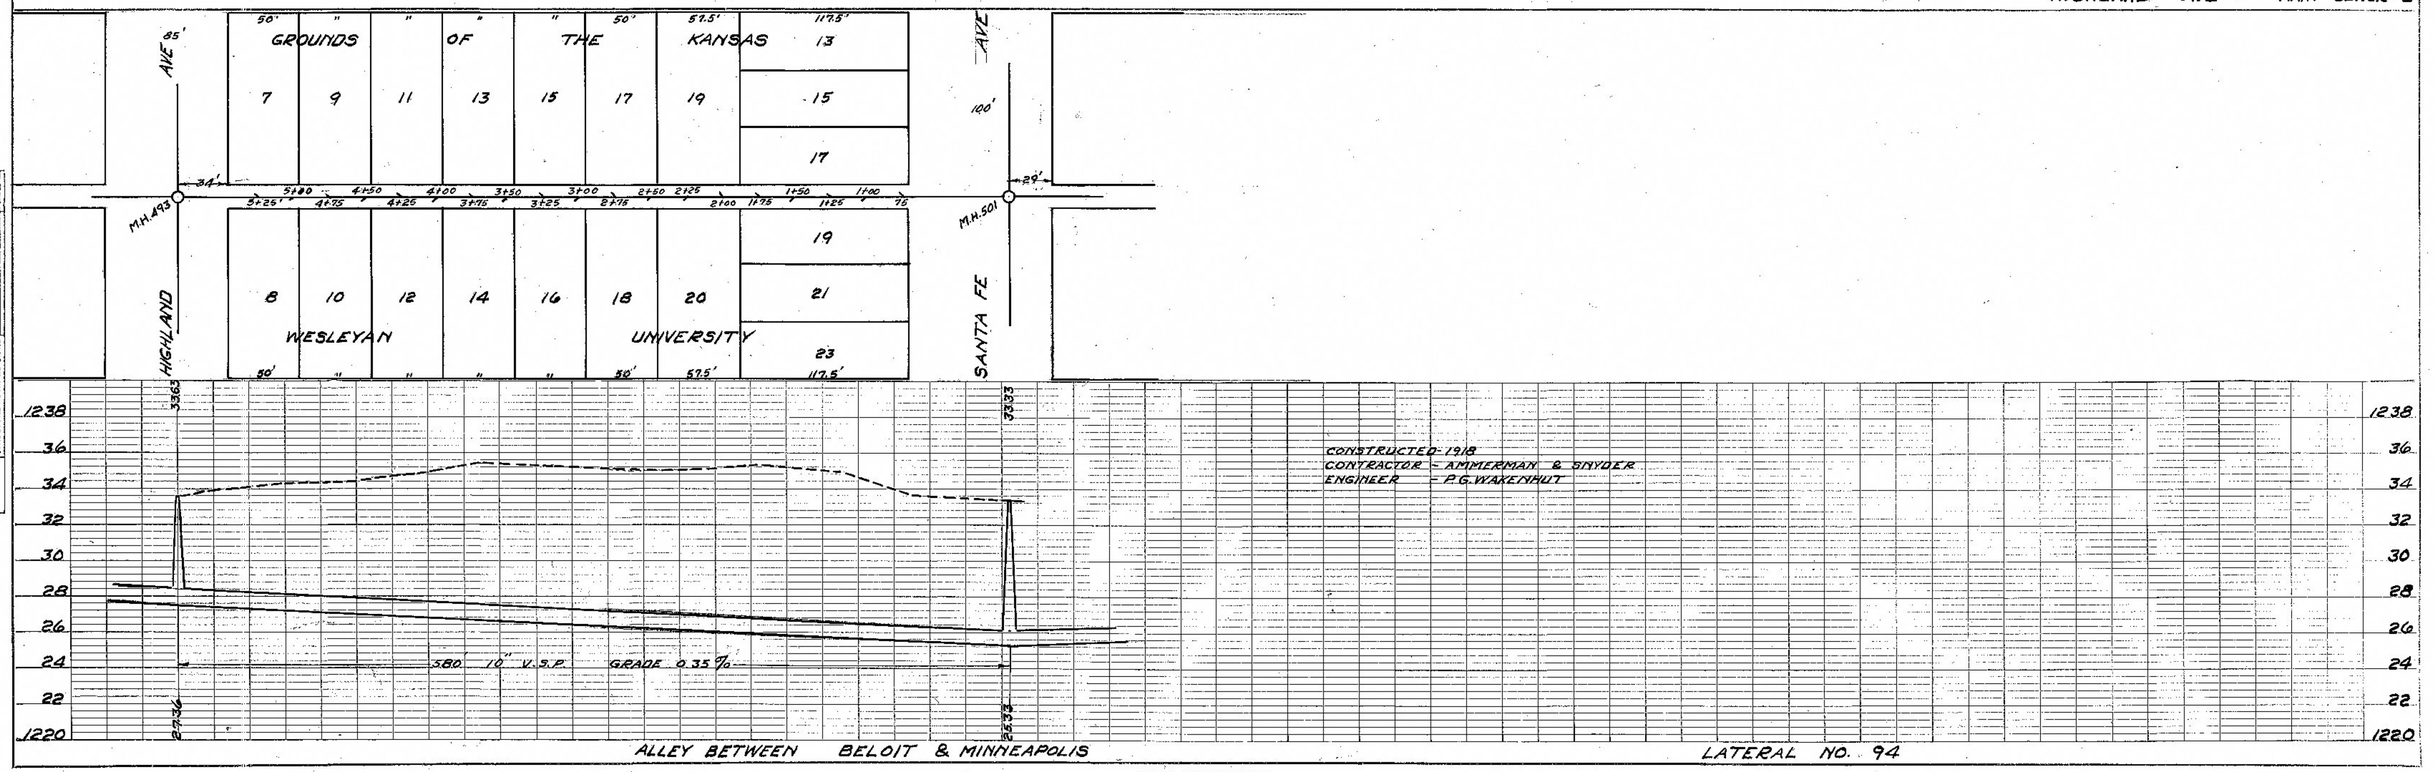

PLATE 2-PLAN-PROFILE B. P. R. STANDARD

EUGENE DIETZGEN CO. CHICAGO, N.Y.