


PLAN	SURVEYED	DATE
	PLOTTED	
	NOTE BOOK	
	ALIGNMENT CHECKED	
	RET. OF WAY CHECKED	
	NO.	

PROFILE	SURVEYED	DATE
	NOTE BOOK	
	GRADES CHECKED	
	B.M. NOTED	
	STRUCTURE NOTATIONS CHECKED	
	NO.	

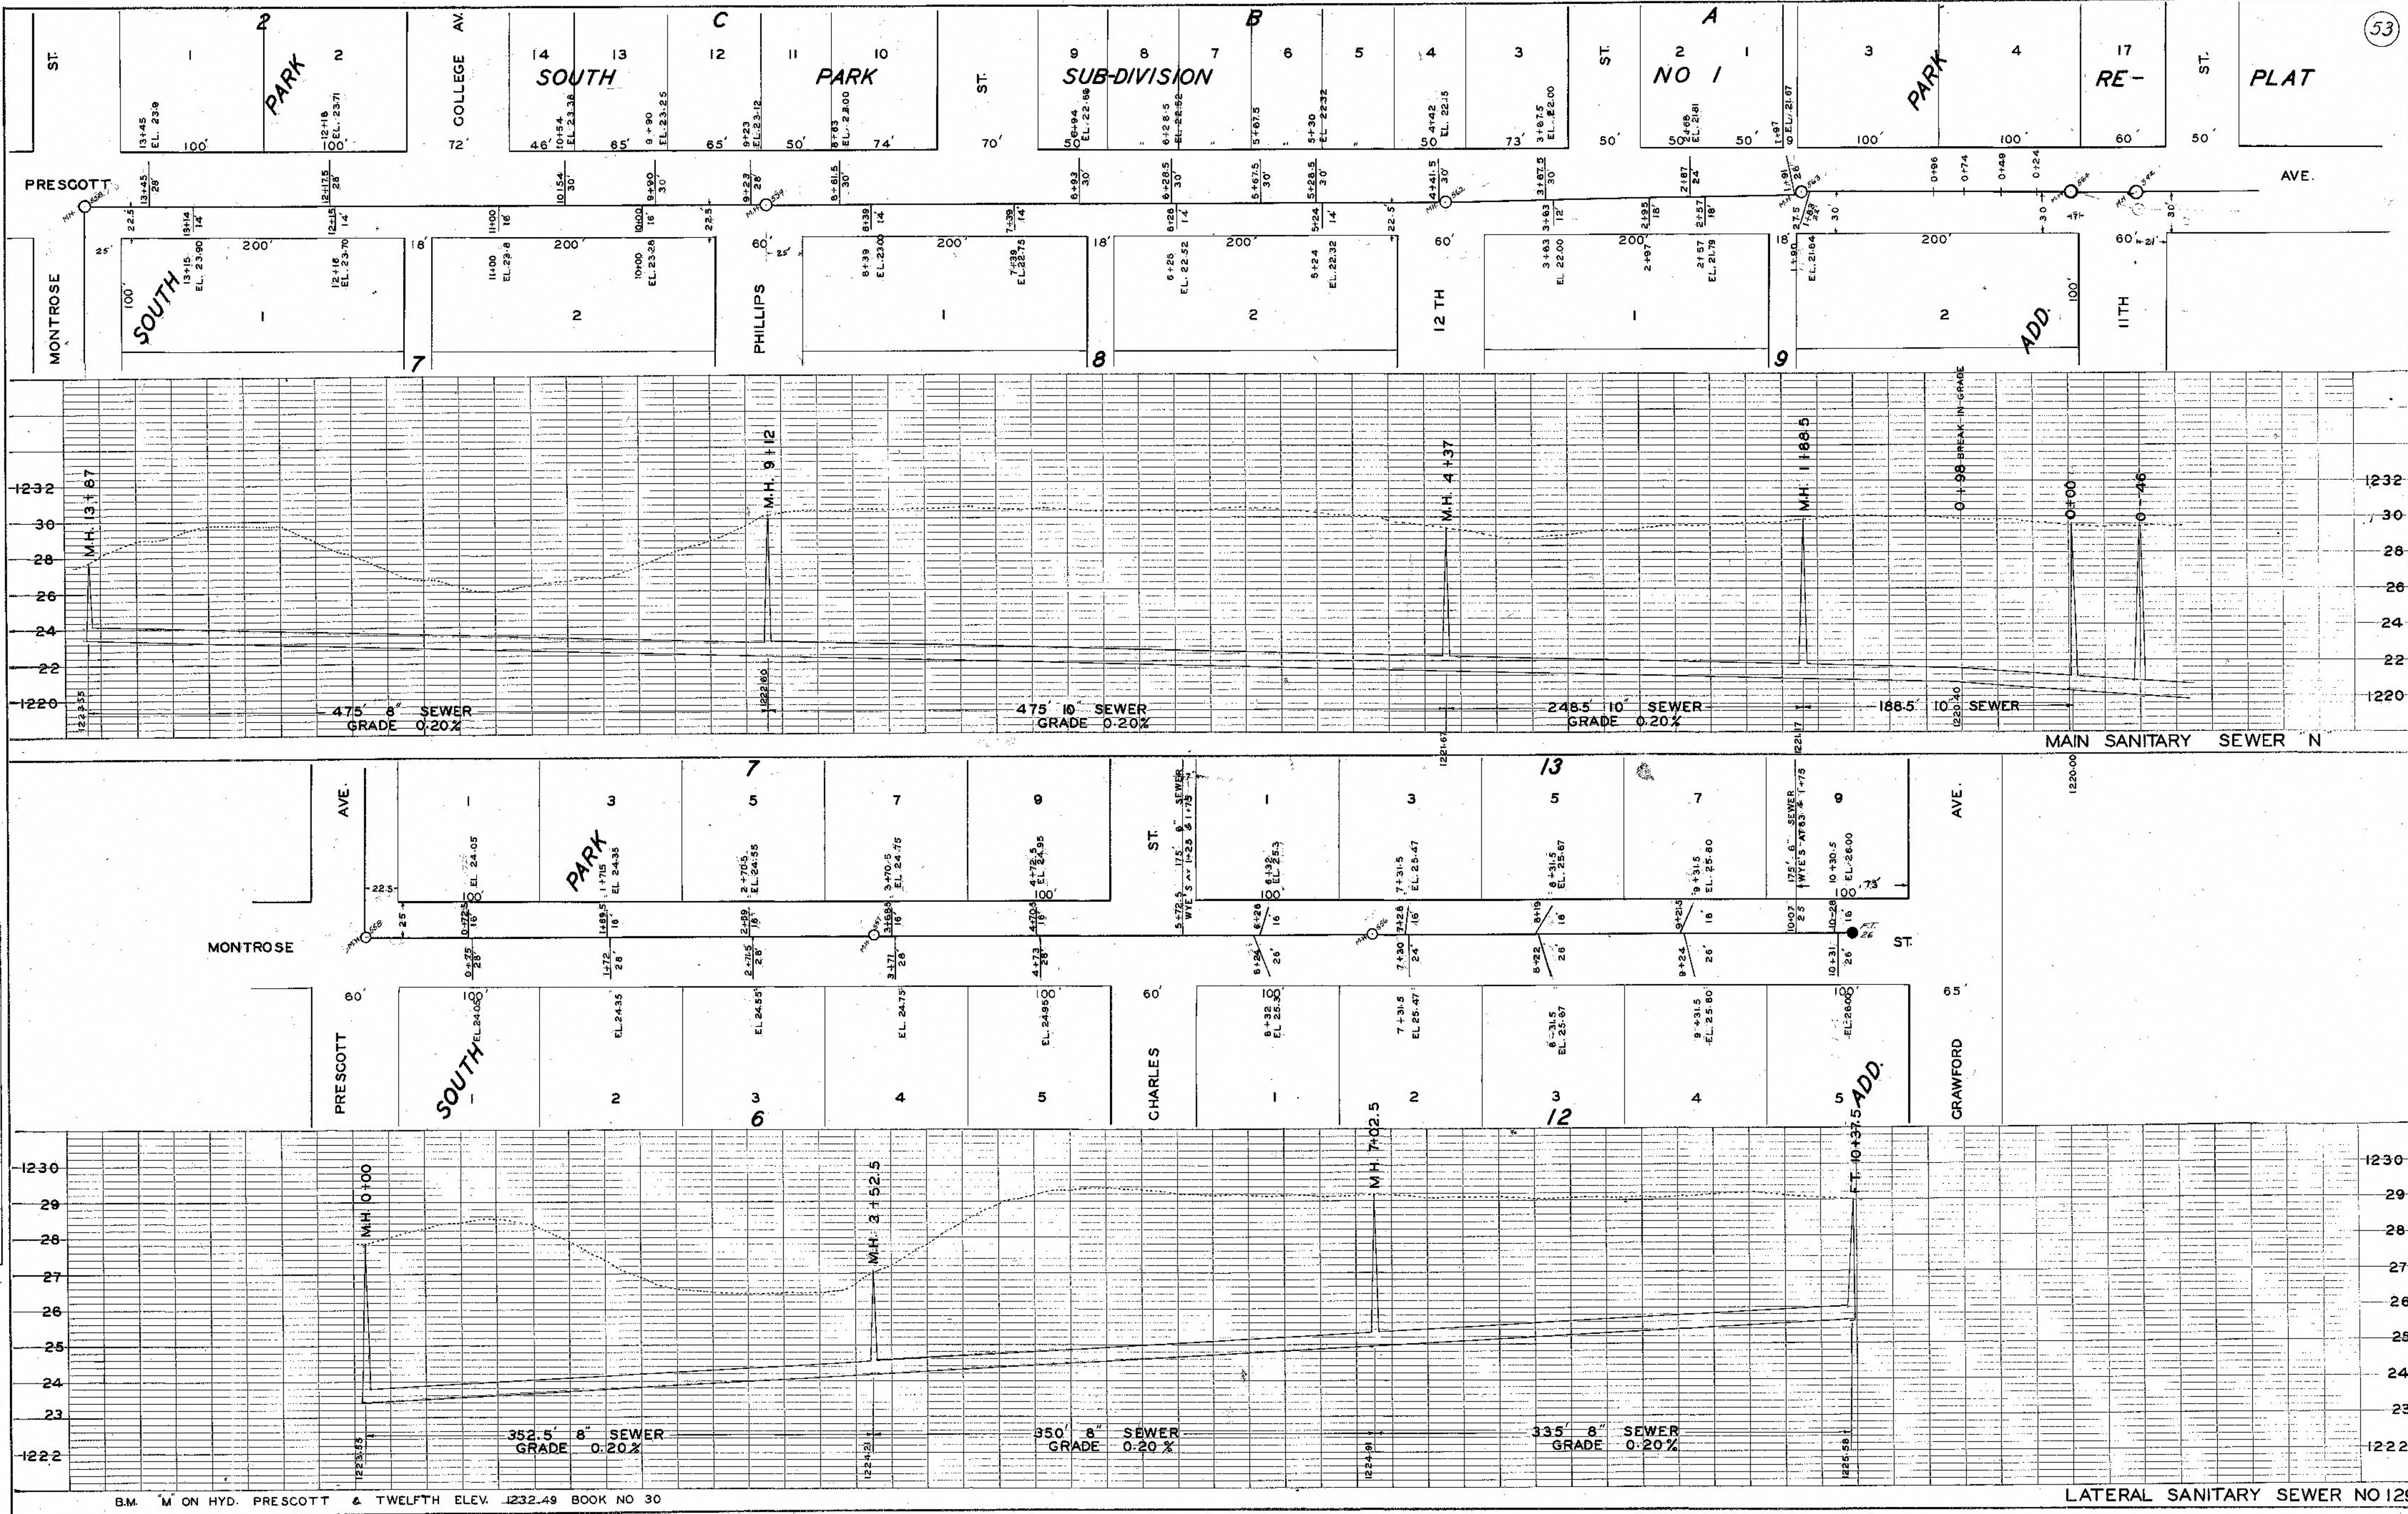

B.M. M ON HYD. PRESCOTT & TWELFTH ELEV. 1232.49 BOOK NO 30

LATERAL SANITARY SEWER NO 129