(55)

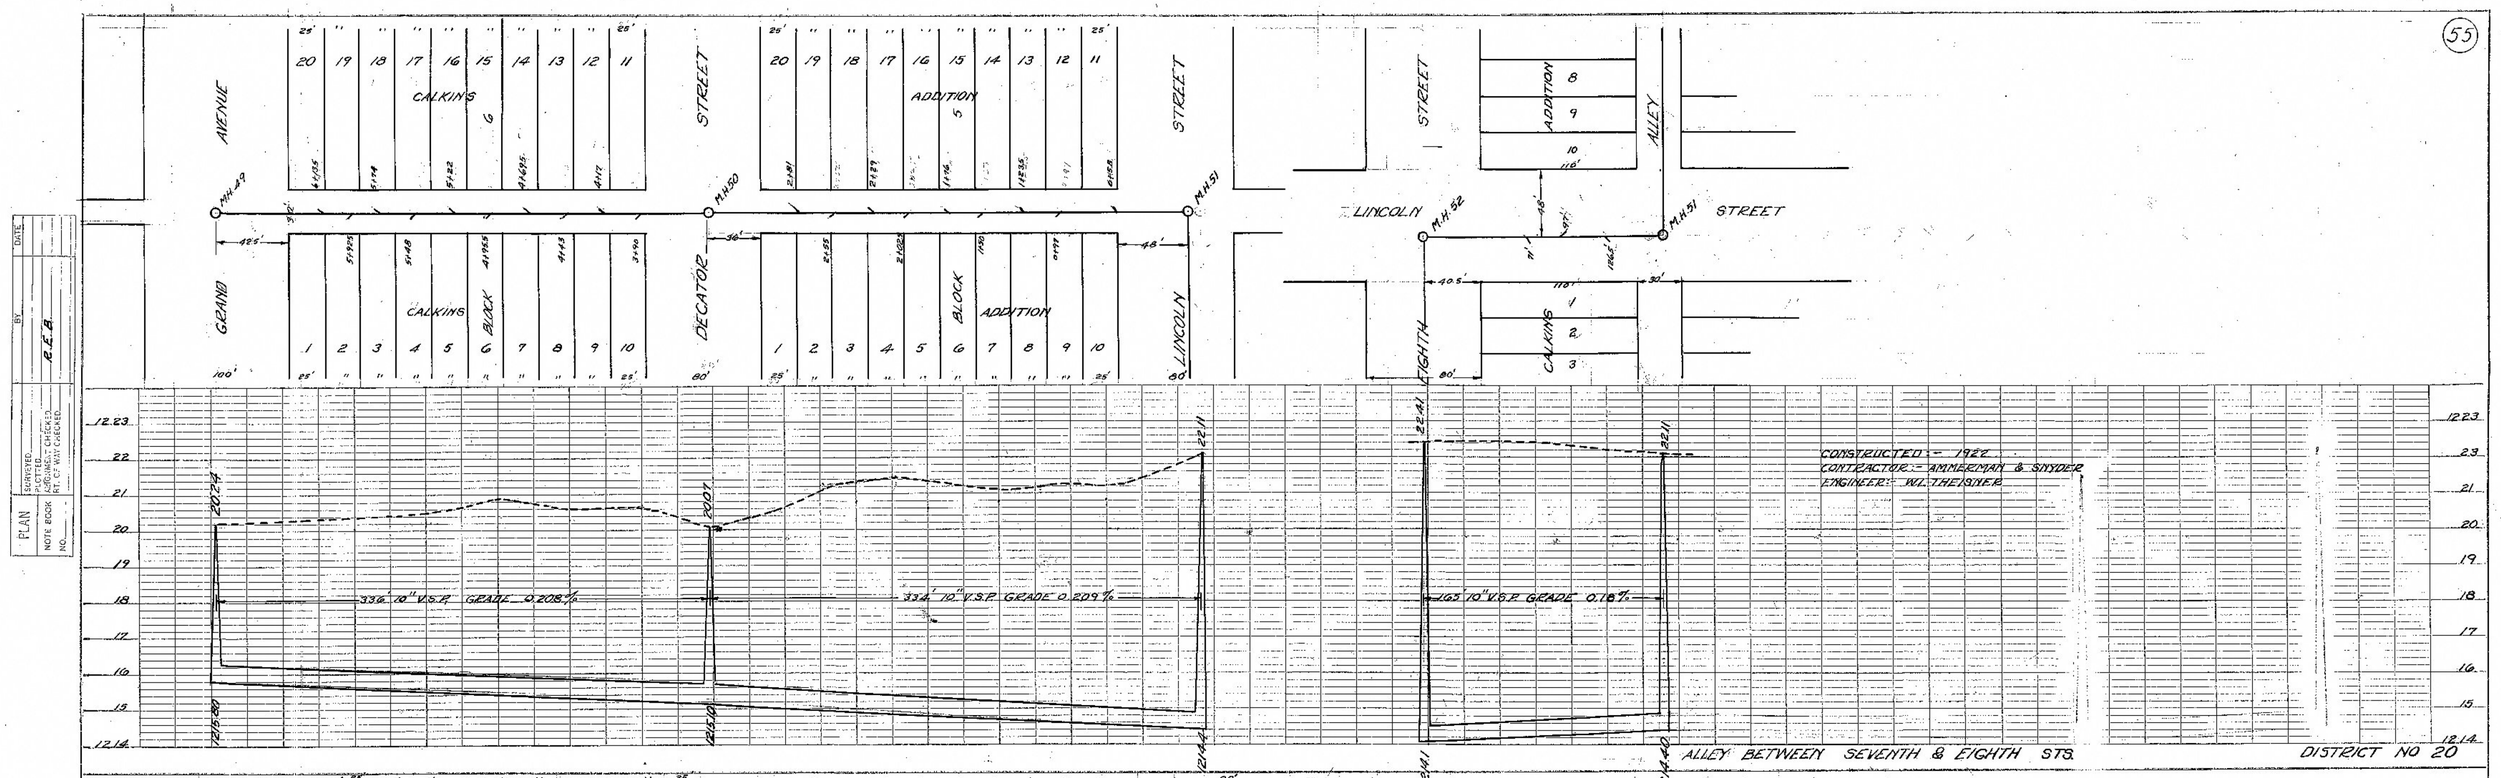

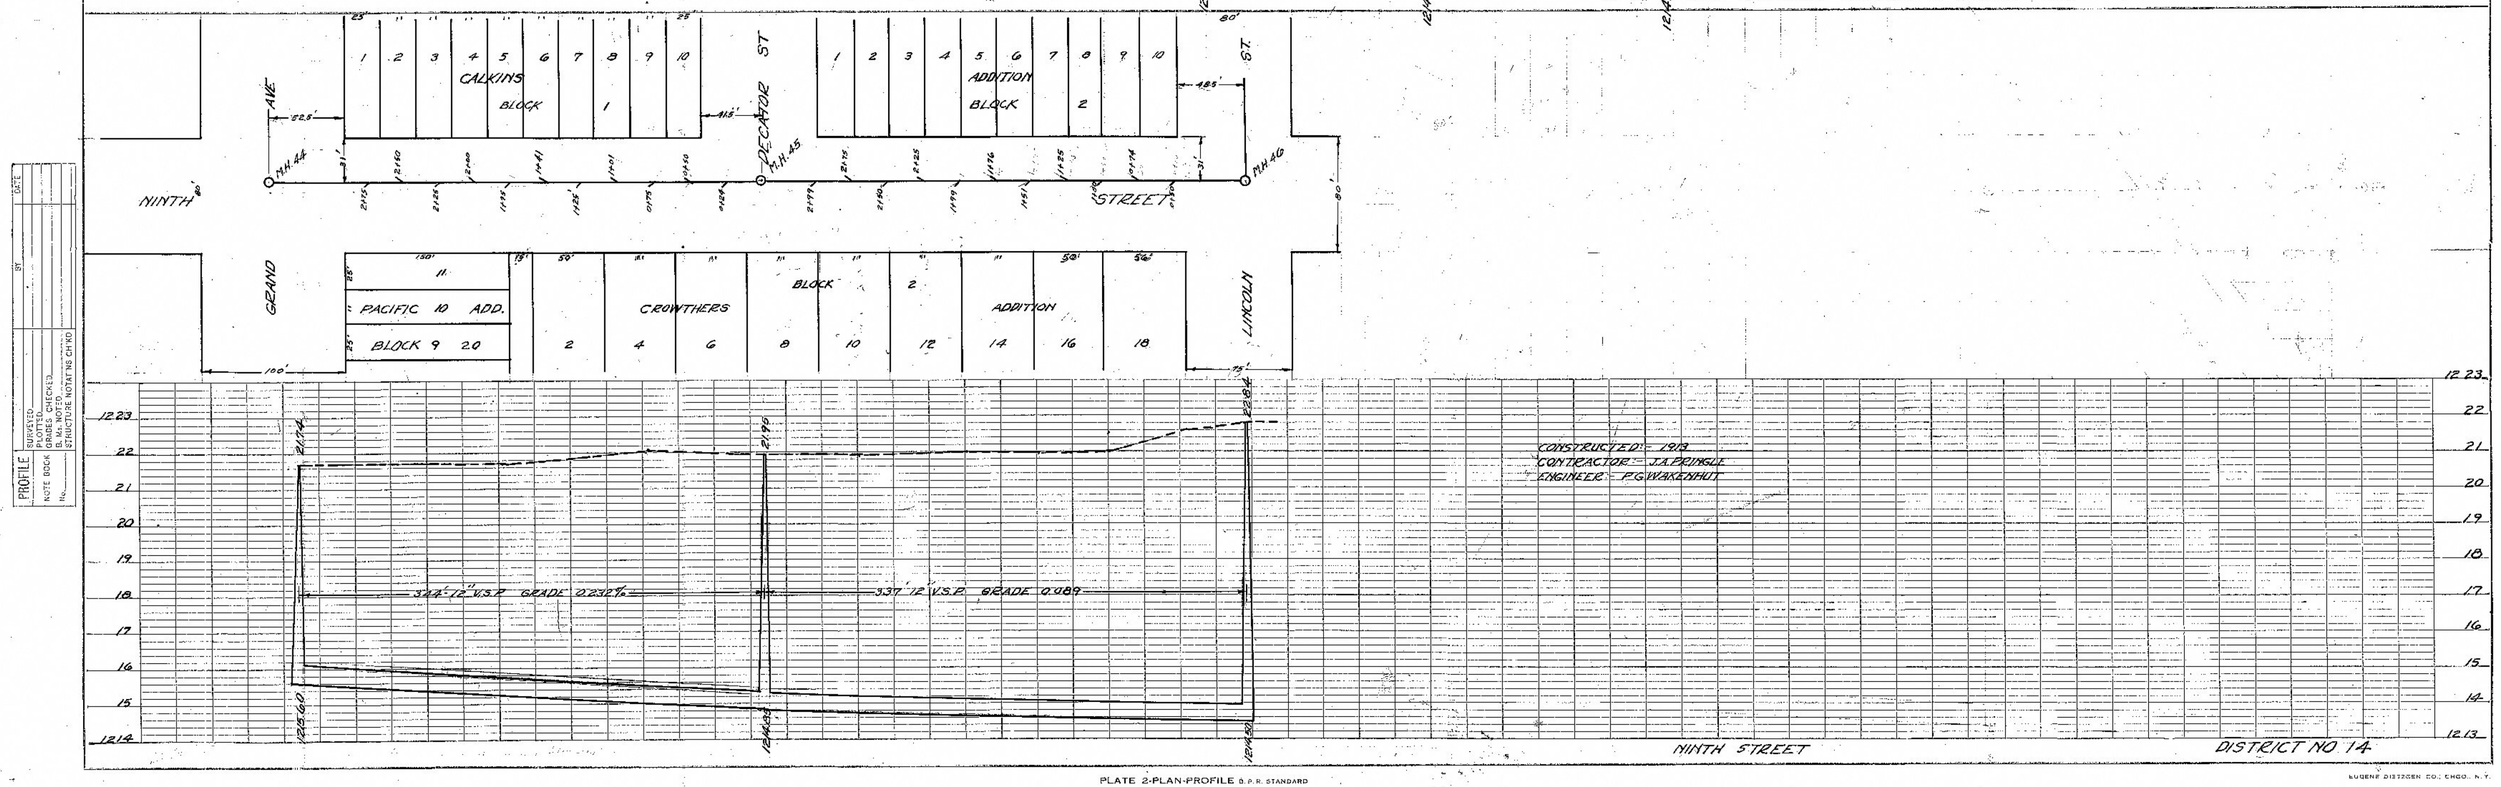

PLATE 2-PLAN-PROFILE D.P.R. STANDARD

EUGENE DIETZGEN CO. CHICAGO, N.Y.