60

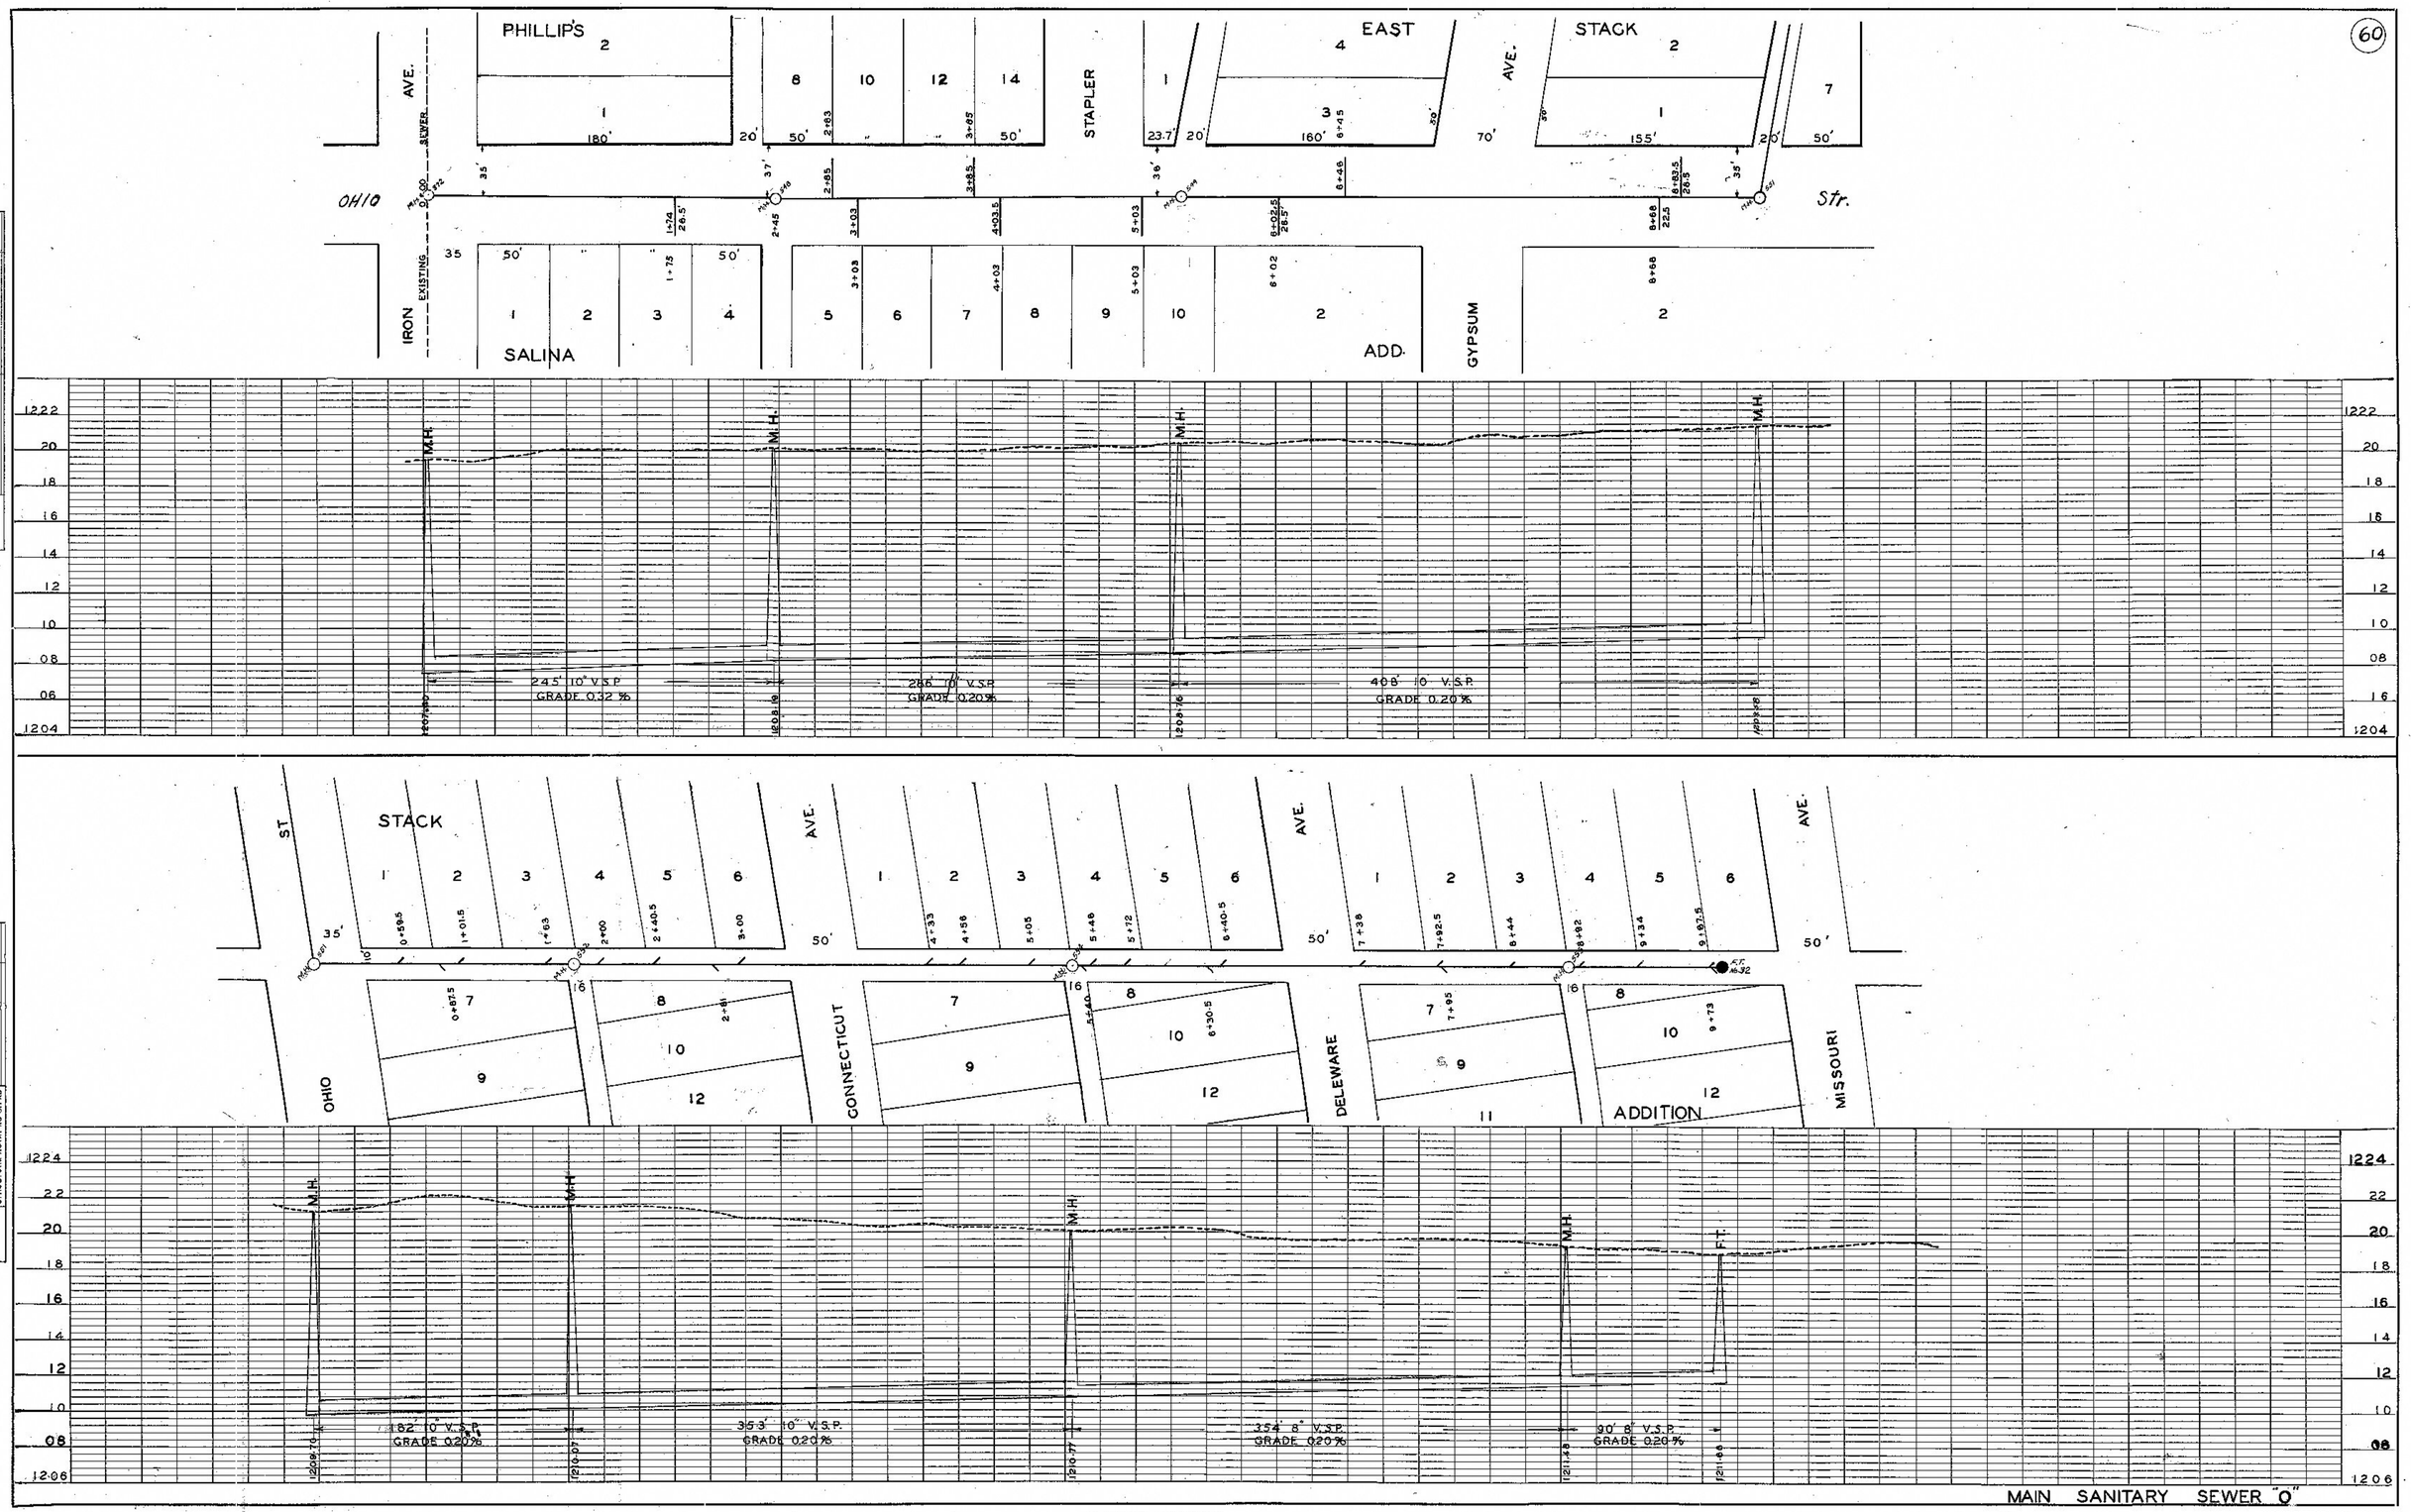

MAIN SANITARY SEWER "O"

PLATE 2-PLAN-PROFILE B. P. R. STANDARD

EUGENE DIETZGEN CO., CHGO., N. Y.