(69)

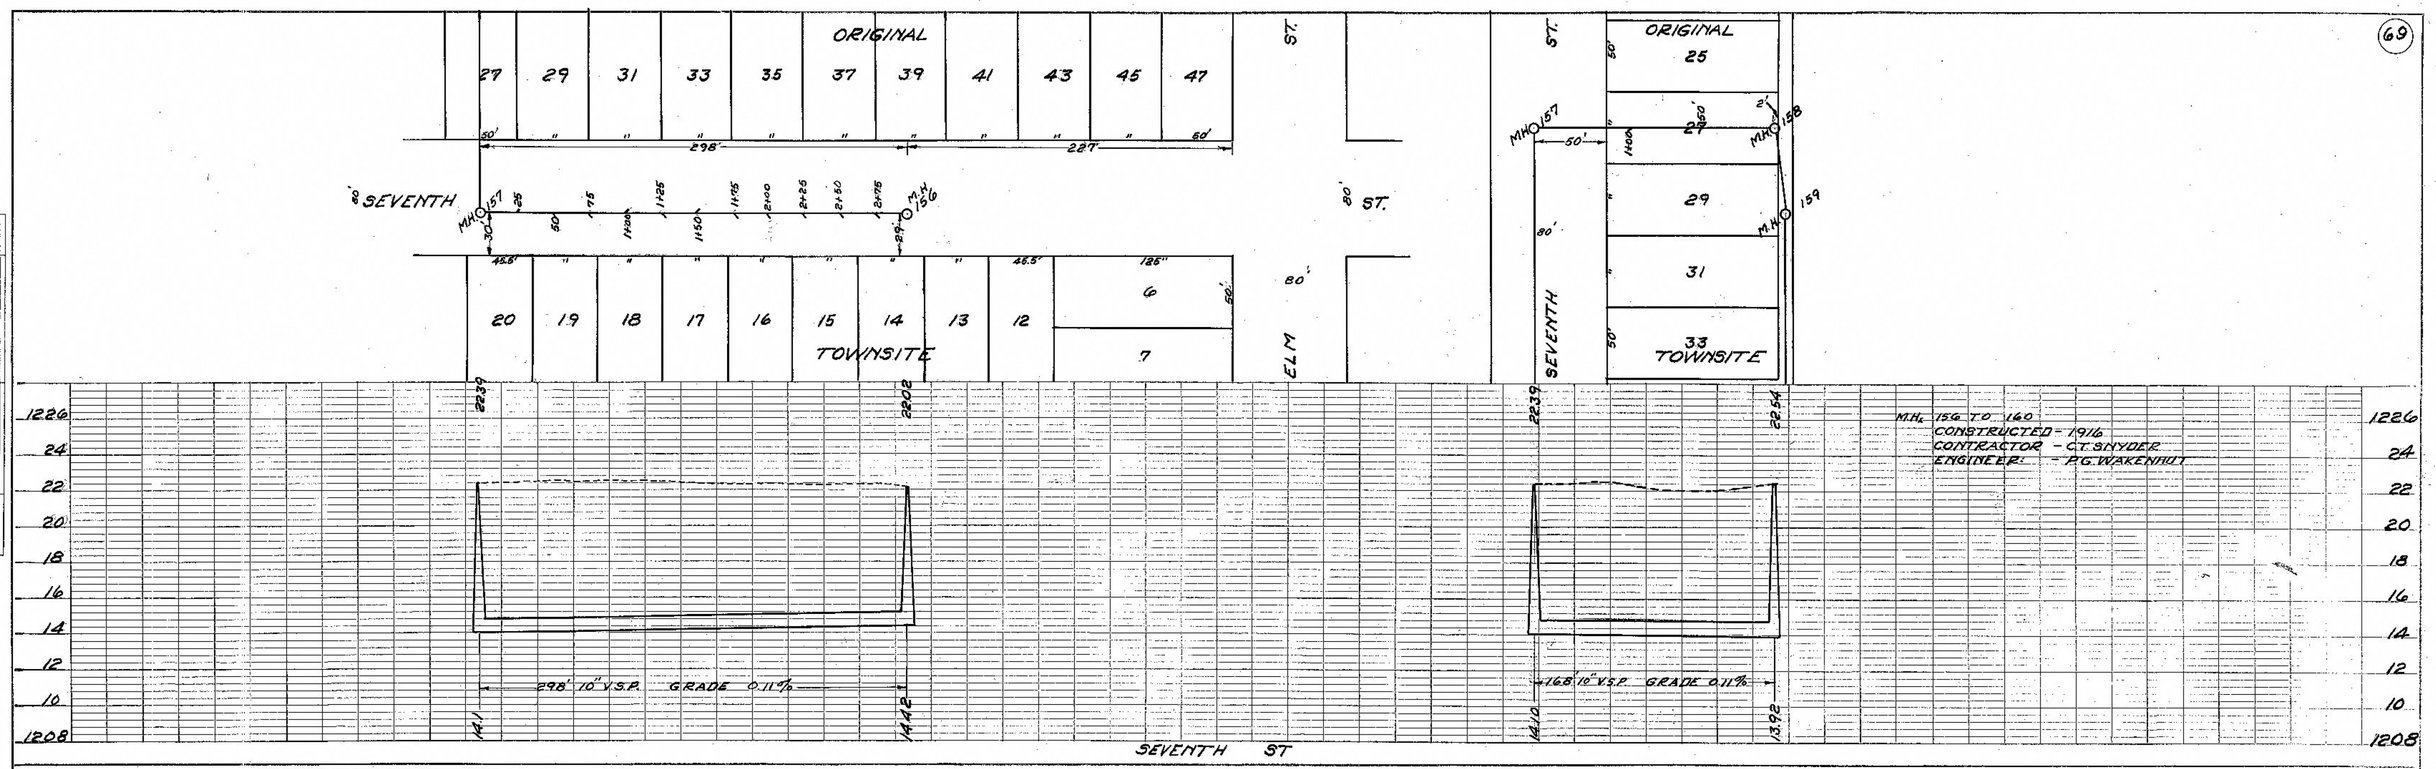

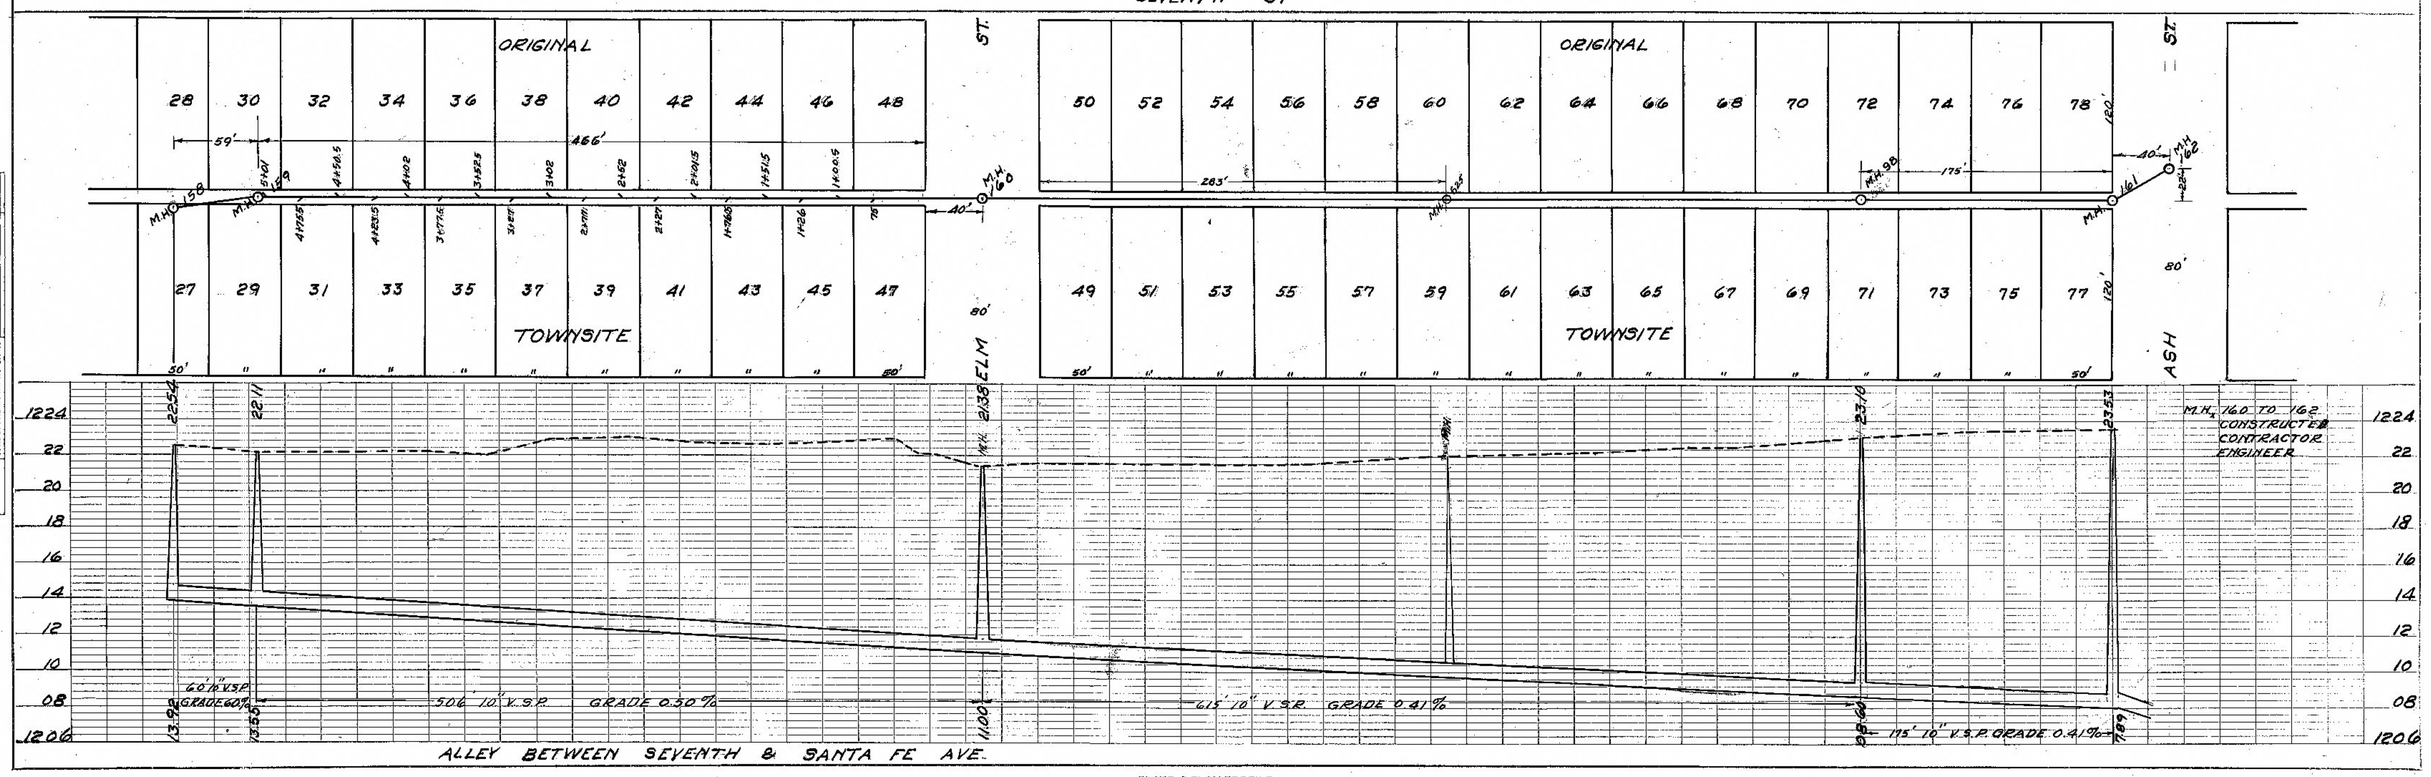

PLAN — DATE — BY — NEW ALTA. — SURVEYED — PLOTTED — ALLOTMENT CHECKED — RT. OF WAY CHECKED — NOTE BOOK — NO.

PROFILE — DATE — BY — NEW ALTA. — SURVEYED — PLOTTED — GRADES CHECKED — R. M's NOTED — STRUCTURE NOTATIONS CH'KD — NOTE BOOK — No.

PLATE 2-PLAN-PROFILE B. P. R. STANDARD

LATERAL NO. 39

EUGENE DIETZGEN CO., CHICAGO