


PLAN SURVEYED BY
 NOTE BOOK ADJUSTMENT CHECKED BY
 RT. OF WY CHECKED BY
 NO.

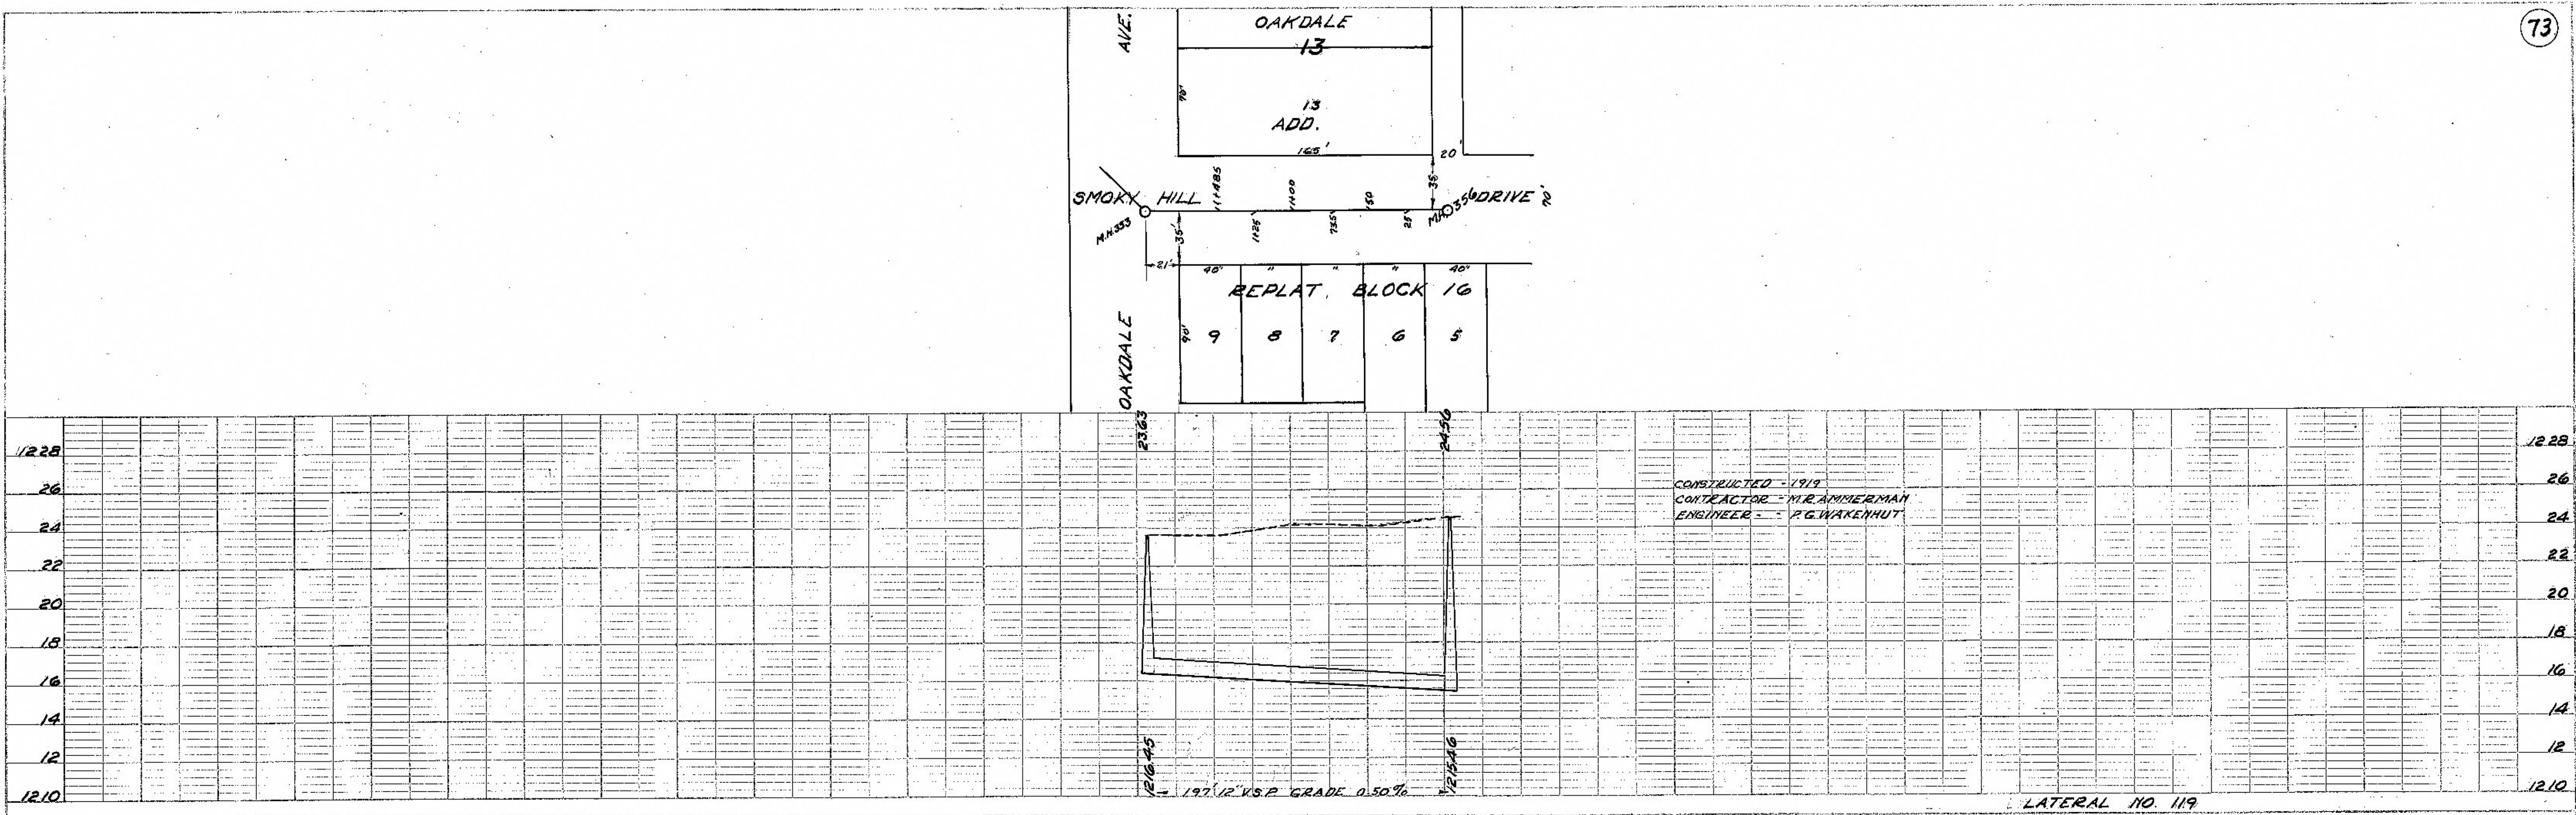

PROFILE SURVEYED BY
 NOTE BOOK ADJUSTMENT CHECKED BY
 5 M.E. NOTED BY
 STRENGTH NOTAS BY
 NO.

