


PLAN  
 DRAWN BY  
 H.E.W.  
 L.R.C.  
 DATE 1937  
 NO. OF SHEETS 10  
 SHEET NO. 77

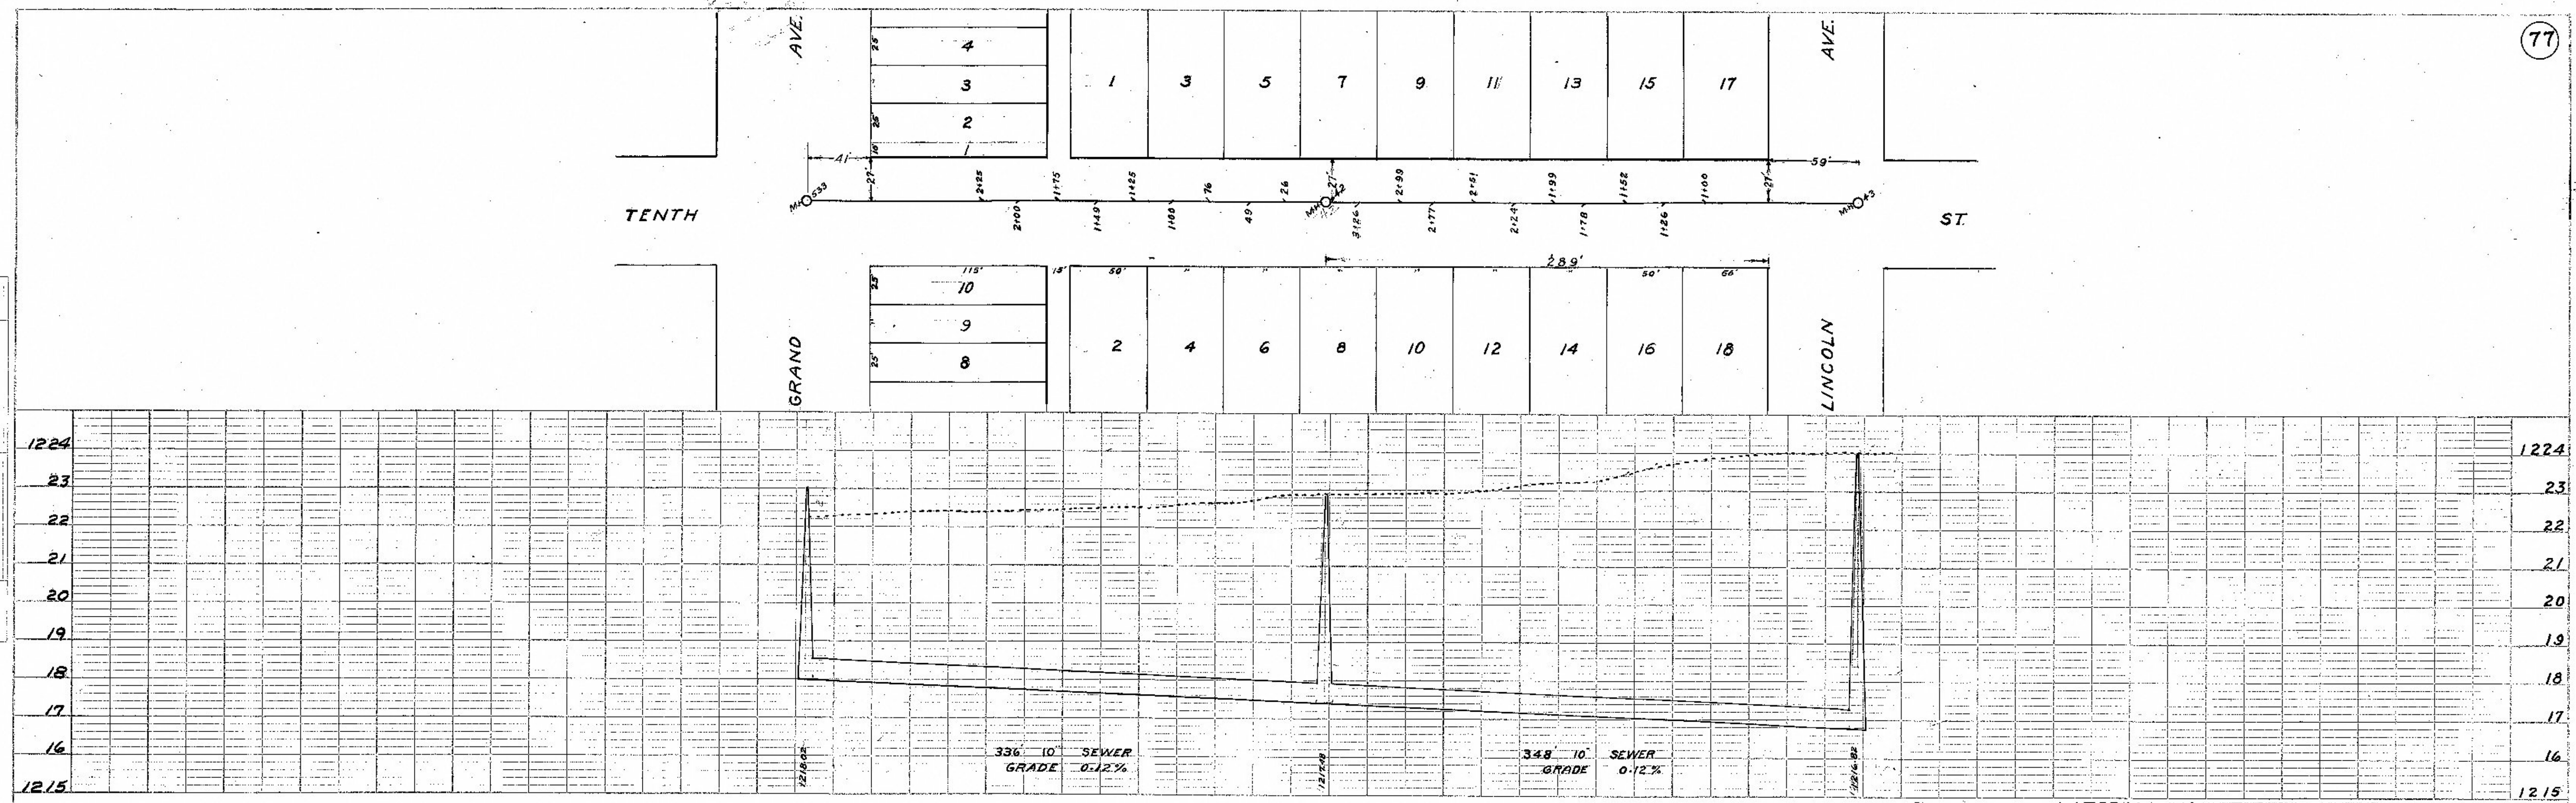

PROFILE  
 DRAWN BY  
 H.E.W.  
 L.R.C.  
 DATE 1937  
 NO. OF SHEETS 10  
 SHEET NO. 77

