


78

DATE	
BY	H.E.W. R.E.B.
PLAN	SURVEYED
	NOTE BOOK
	PLOTTED
	ALIGNMENT CHECKED
	RT. OF WAY CHECKED
NO.	

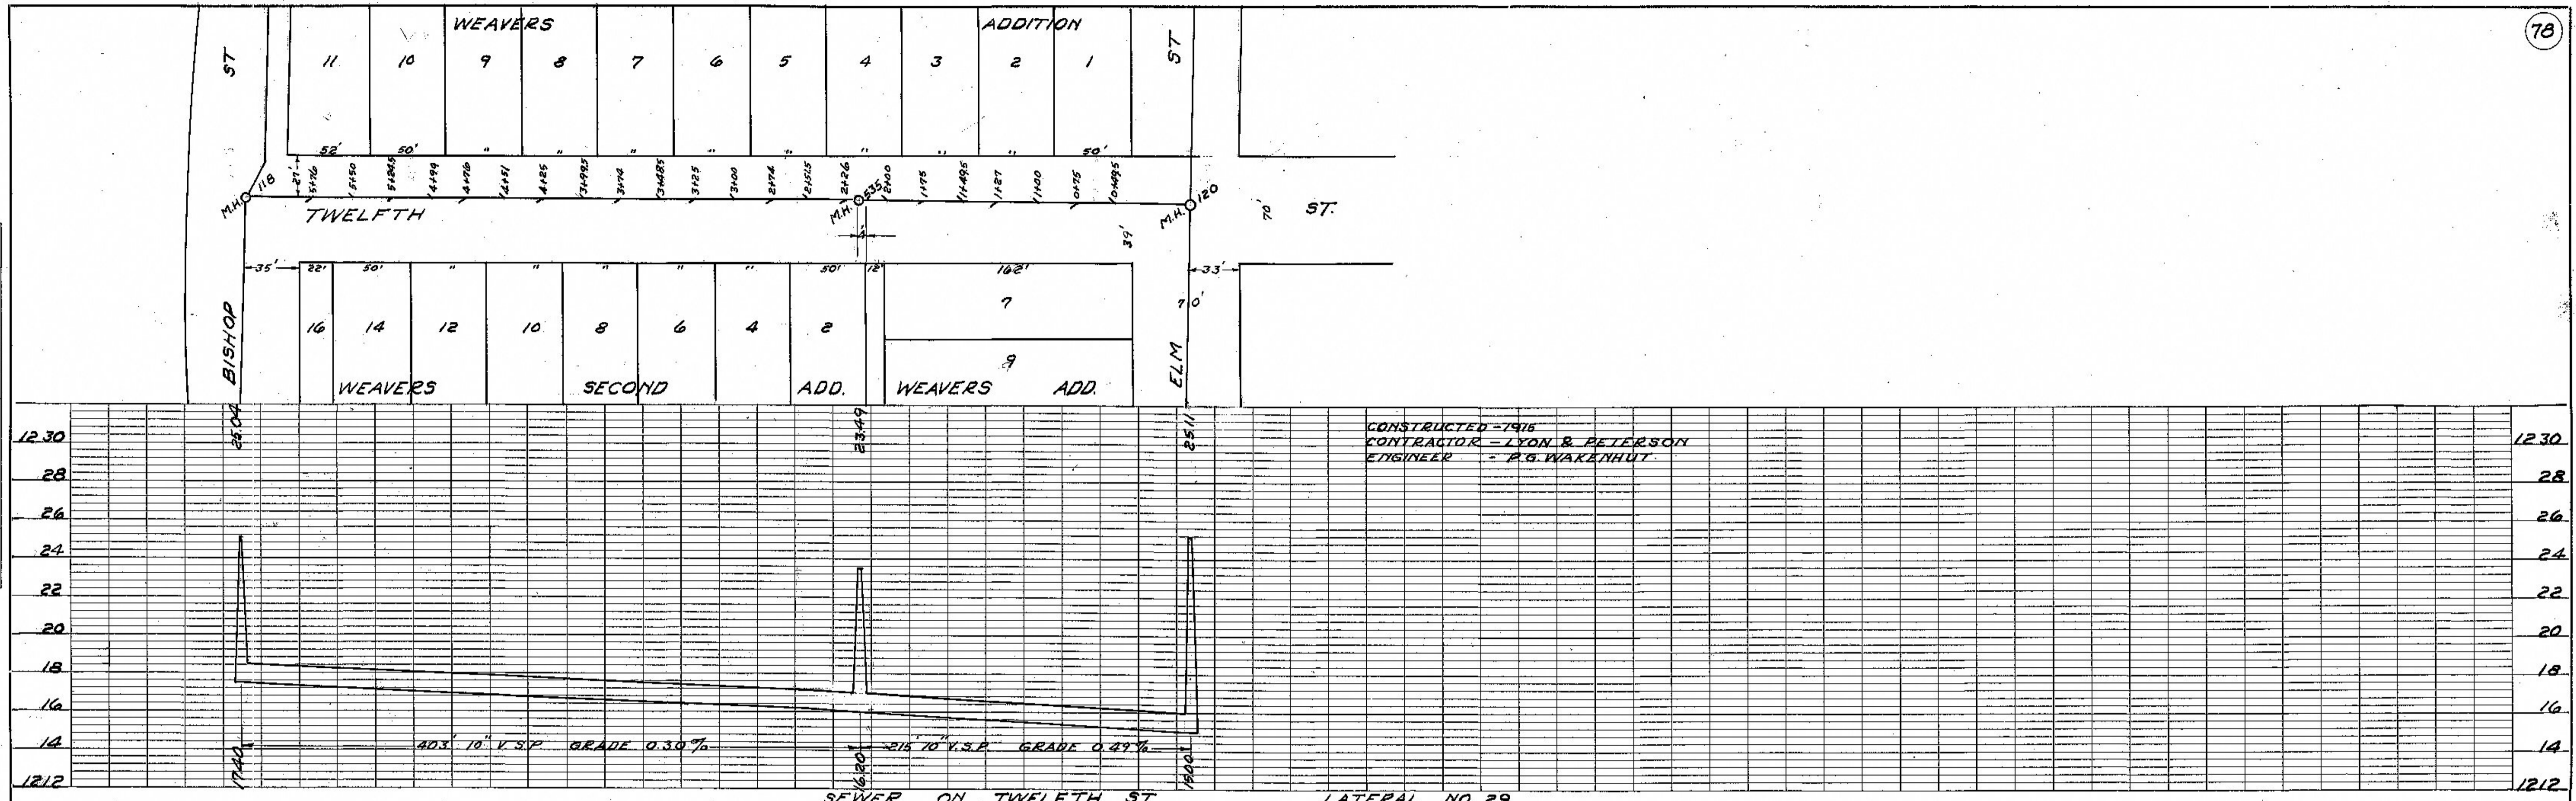

DATE	
BY	H.E.W. R.E.B.
PROFILE	SURVEYED
	NOTE BOOK
	PLOTTED
	GRADES CHECKED
	E.M. NOTE CHECKED
	STREETS & LOTS CHECKED
NO.	

