79

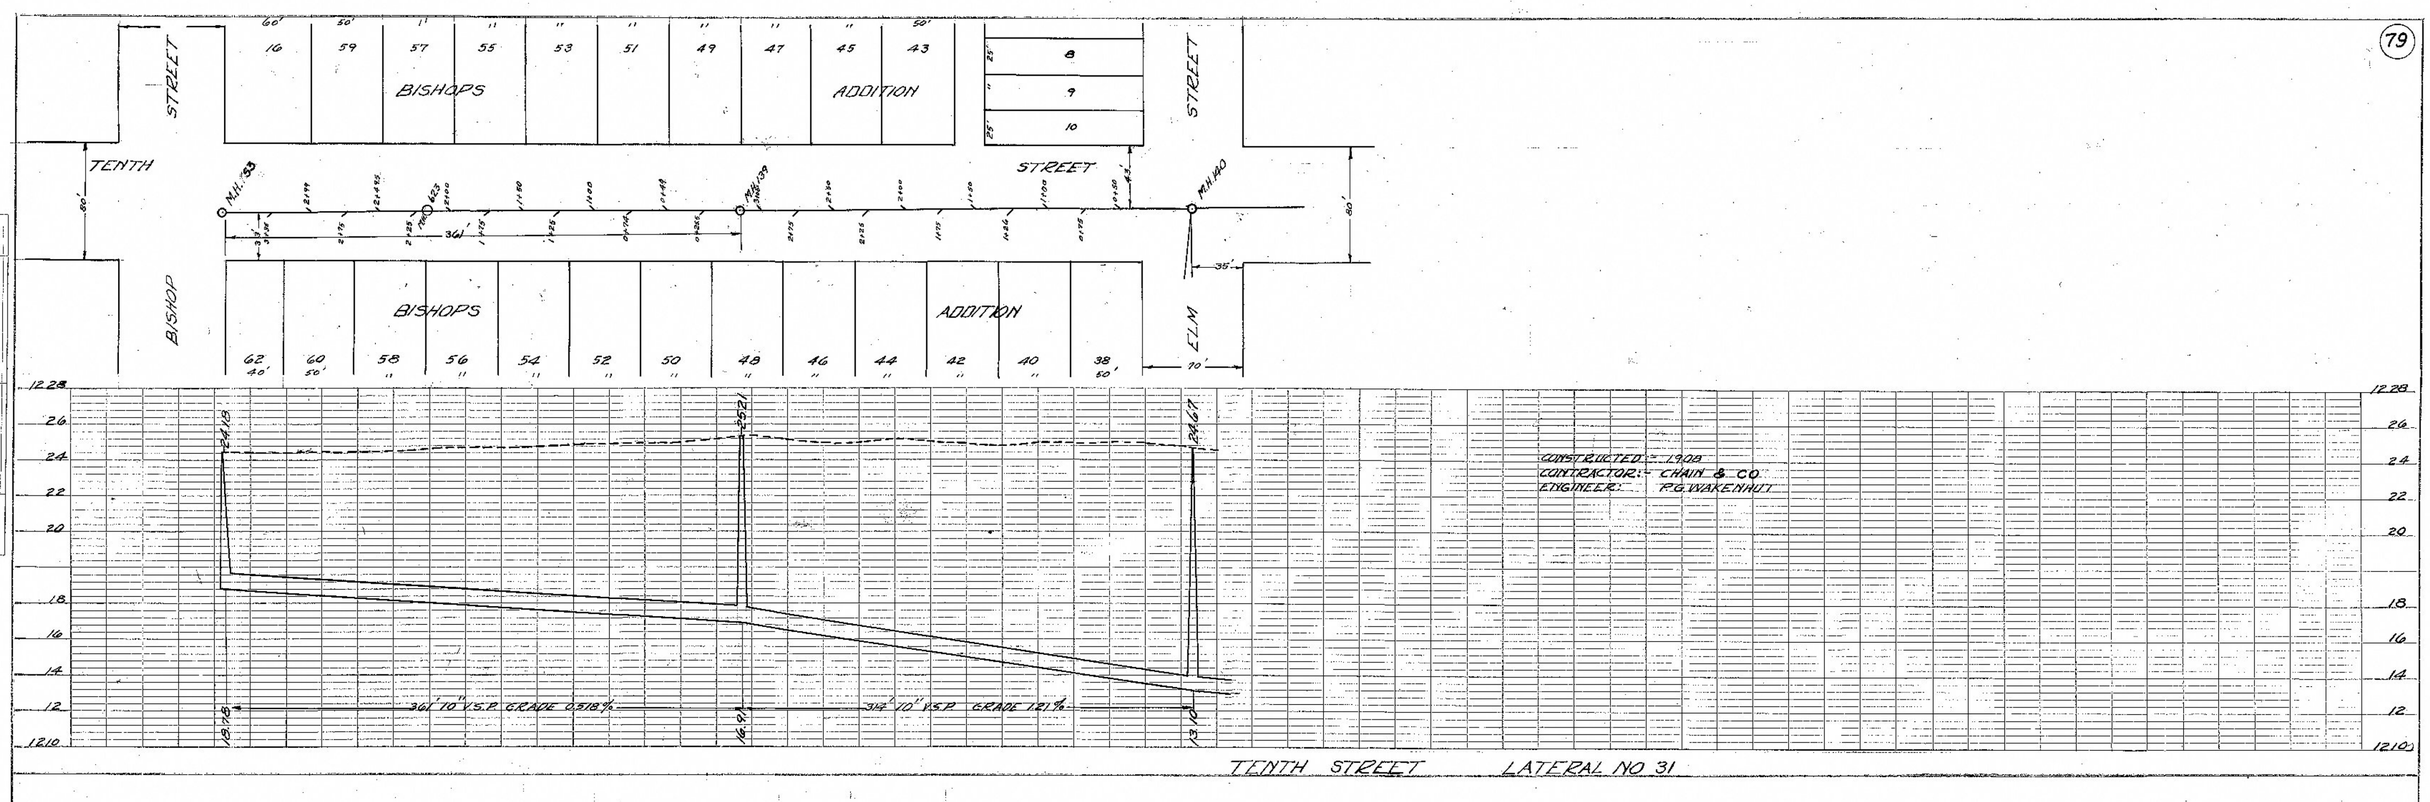

TENTH STREET LATERAL NO 31

PLAN — SURVEYED ___ PLOTTED ___ NOTE BOOK ___ ALIGNMENT CHECKED ___ FIT OF WAY CHECKED ___ NO. ___ BY R.E.B. DATE

PROFILE — SURVEYED ___ PLOTTED ___ GRADES CHECKED ___ NOTE BOOK ___ BL. BK. NOTES ___ No. ___ STRUCTURE NOTATIONS CHK'D ___ BY ___ DATE ___

EUGENE DIETZGEN CO. CHGO., N.Y.