G-97 456

(93)

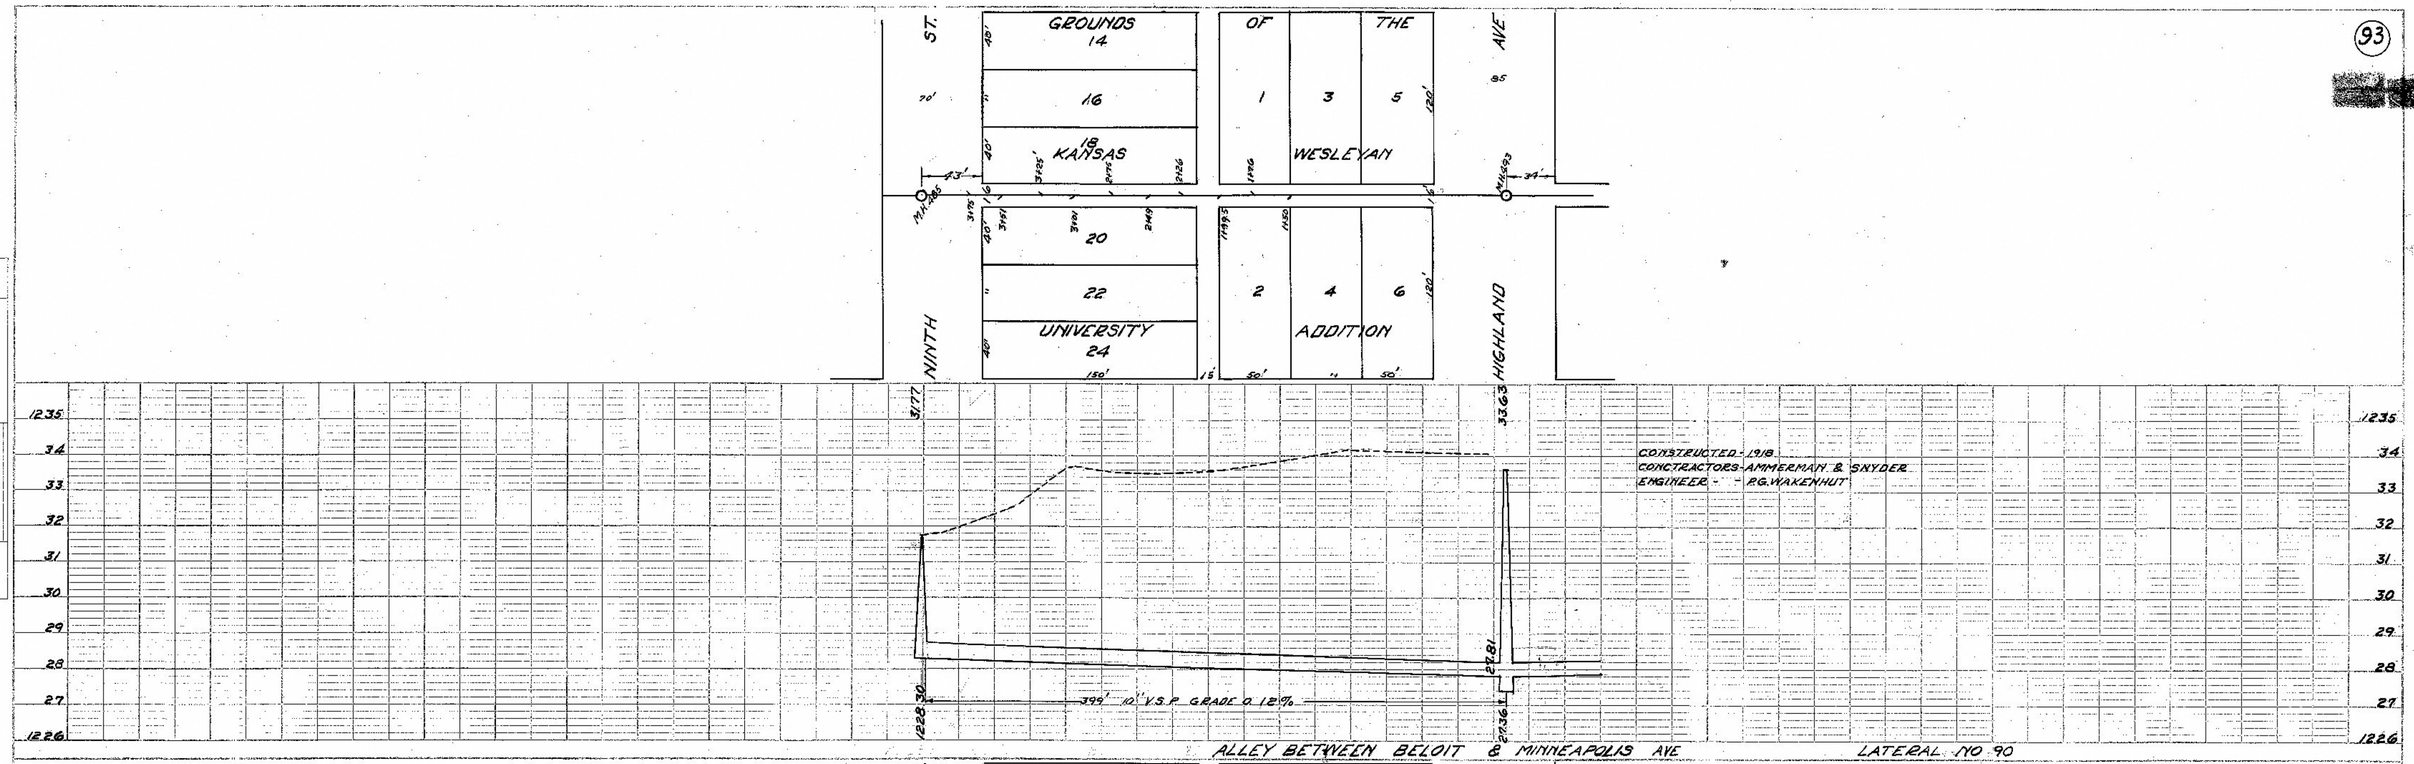

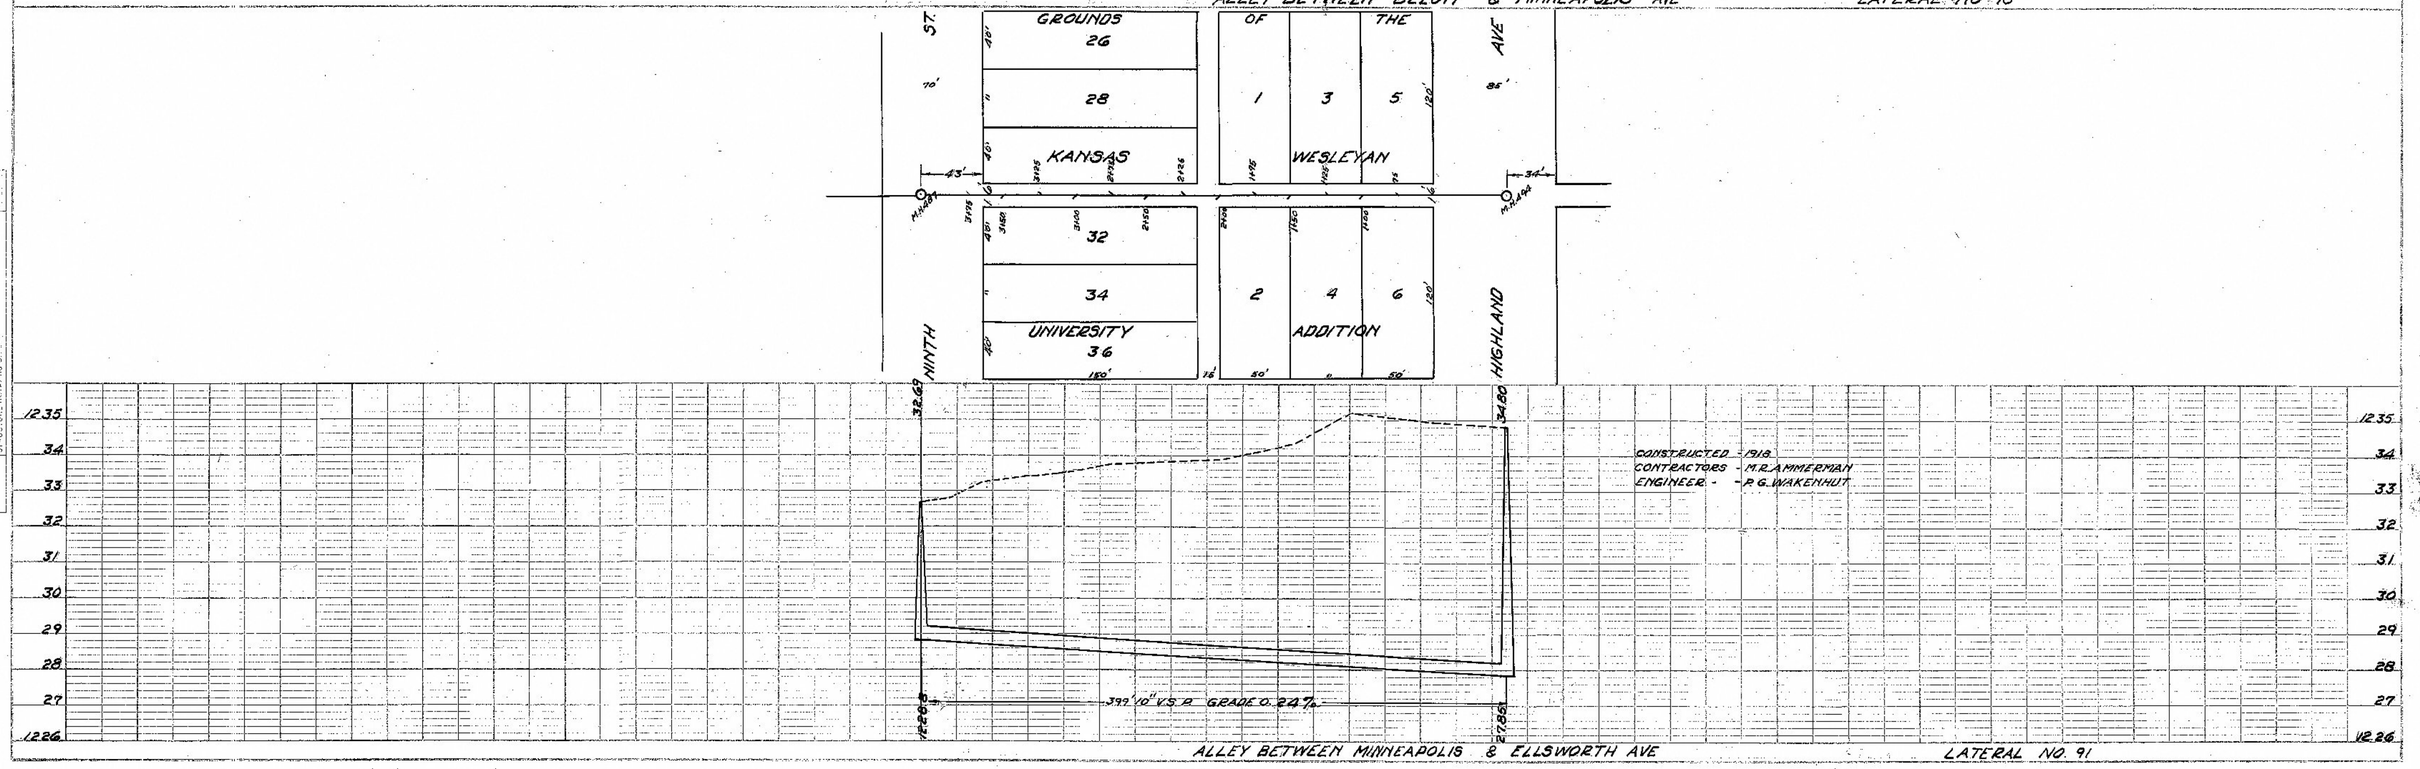

PLATES PLAN-PROFILE O.P.R.&R'R STANDARD
KEUFFEL & ESSER CO. NEW YORK