G-98 457

94

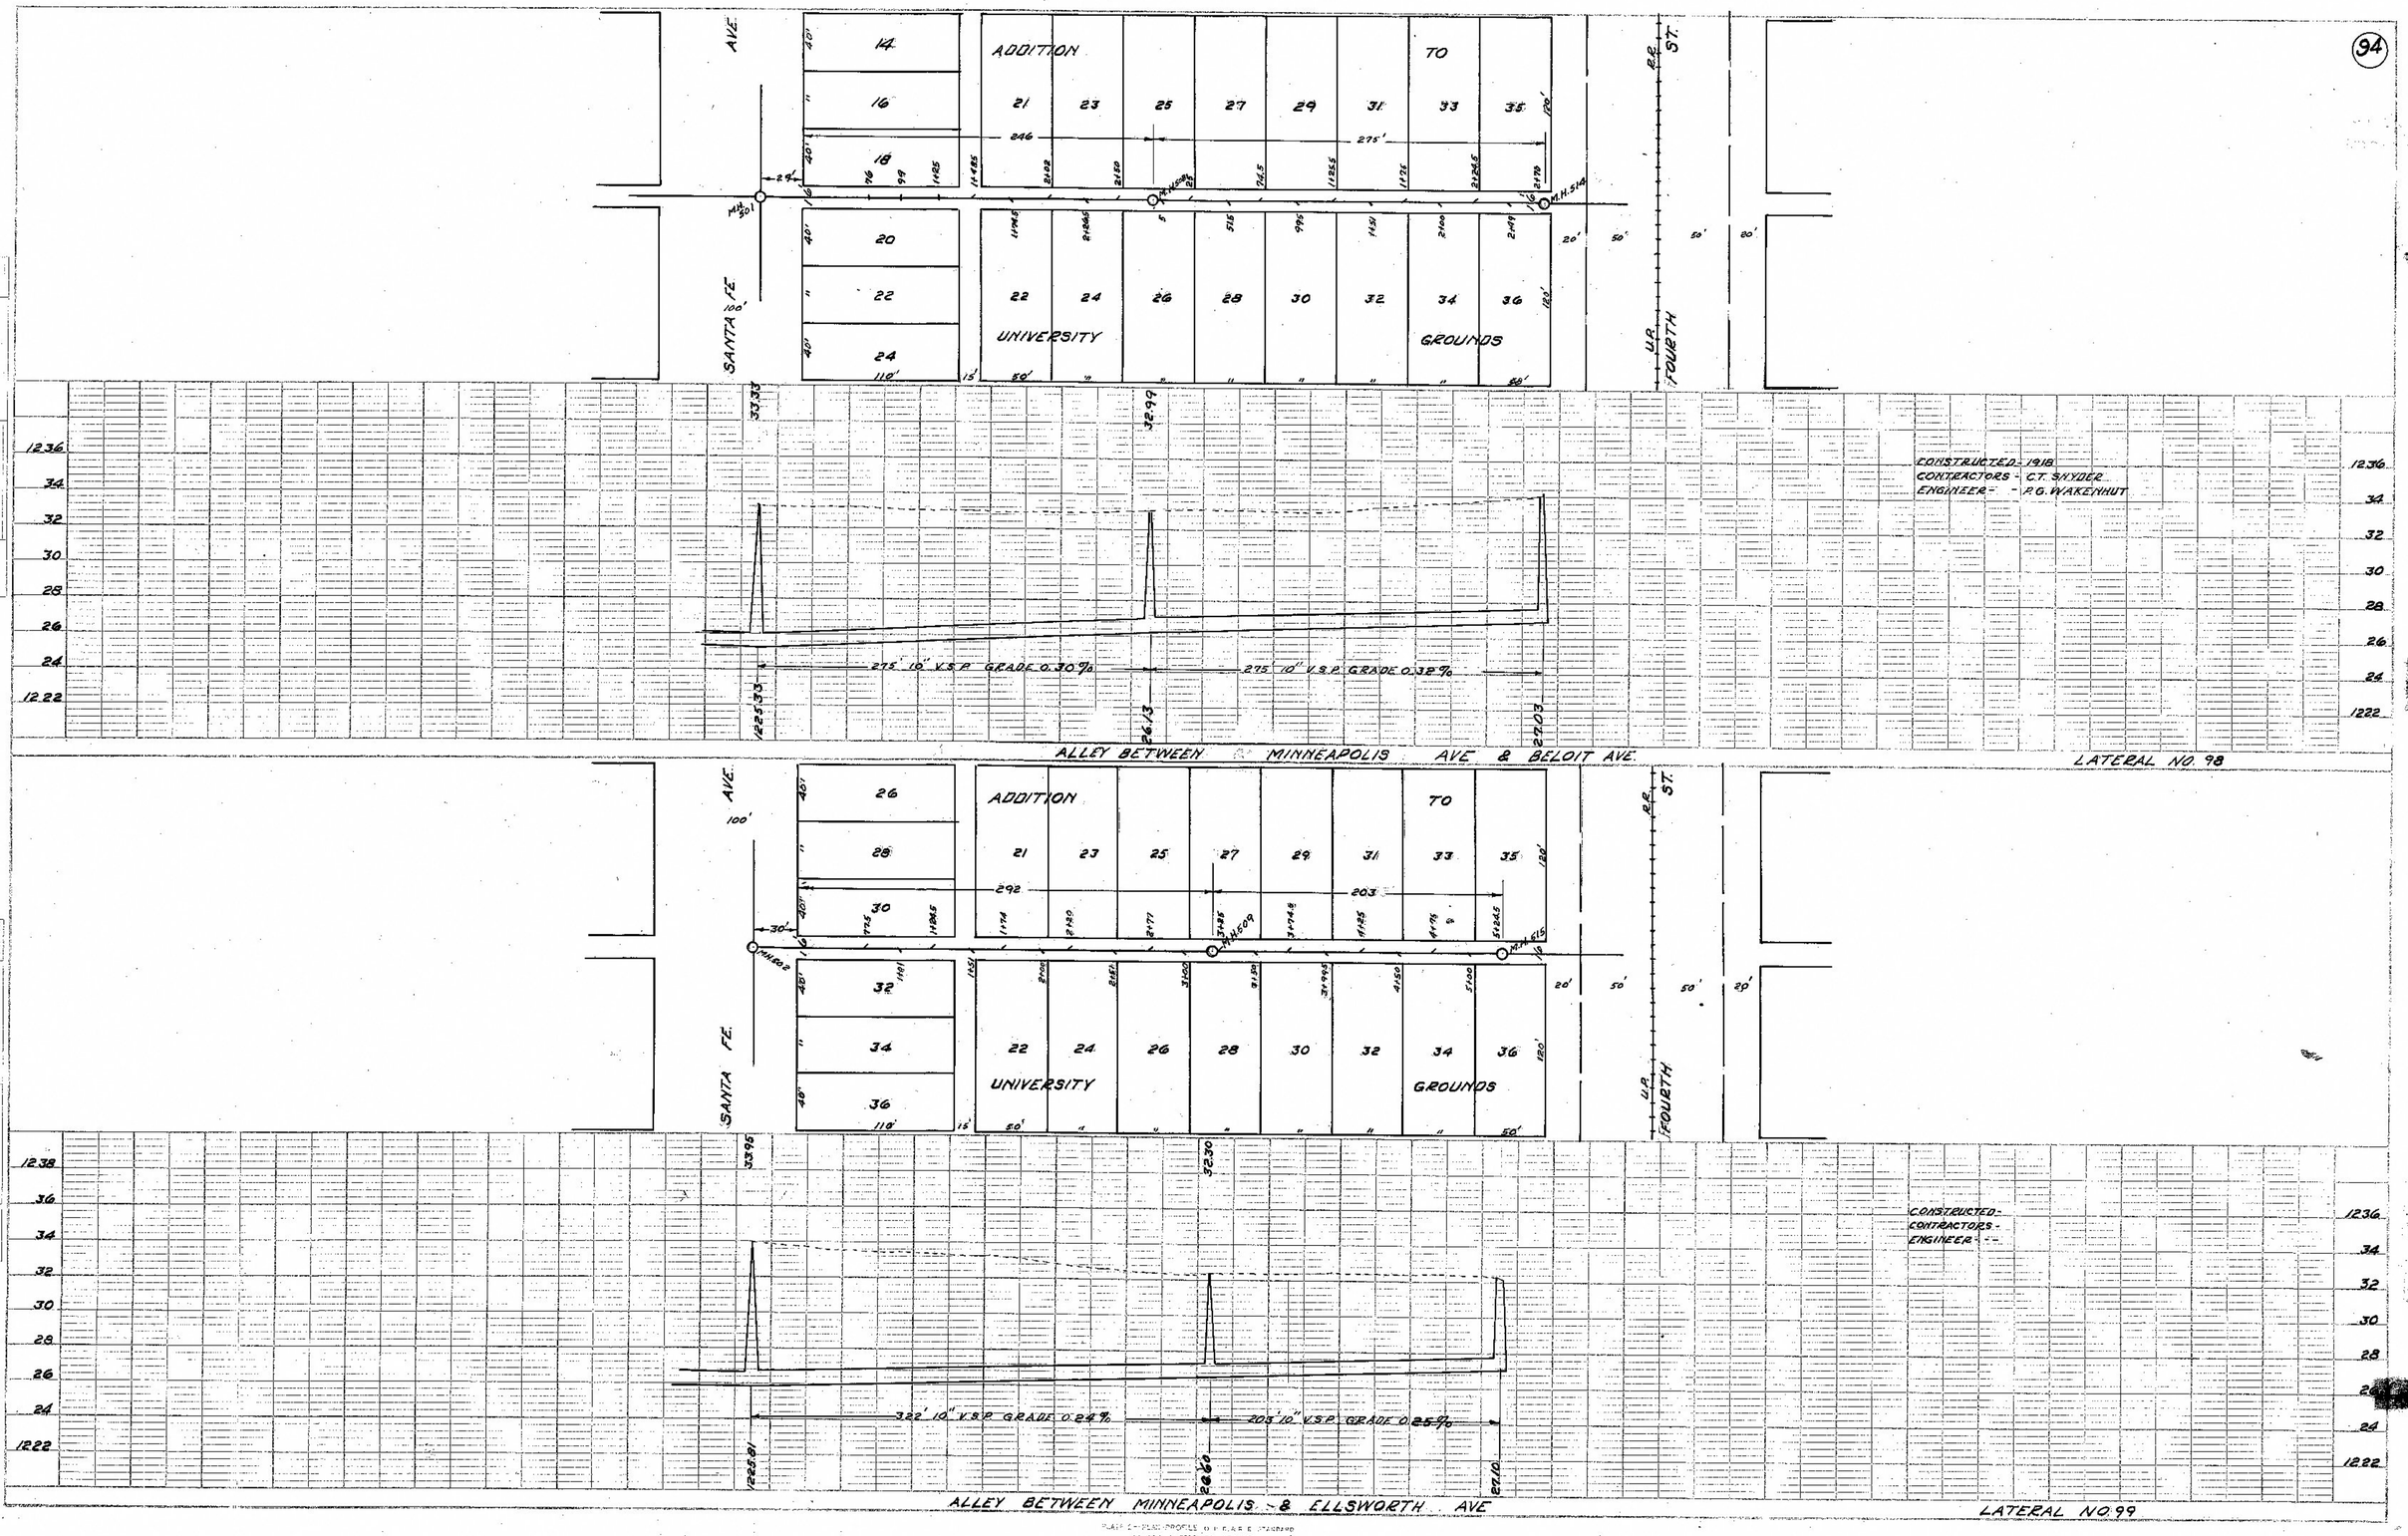

PLAN
SURVEYED
MAPPED
NOTE BOOK ALIGNMENT CHECKED
NO. RT. OF WAY CHECKED
H.E.W. 2.28

PROFILE
CONTRACTOR
E. OTTER
NOTE BOOK GRADES CHECKED
NO. ALIGNMENT CHECKED
RT. OF WAY CHECKED
H.E.W. 2.28

PLATE 2 - PLAN & PROFILE OF PLATE E STANDARD
HEUPEL & ESSER CO. NEW YORK.