G-106 465

(102)

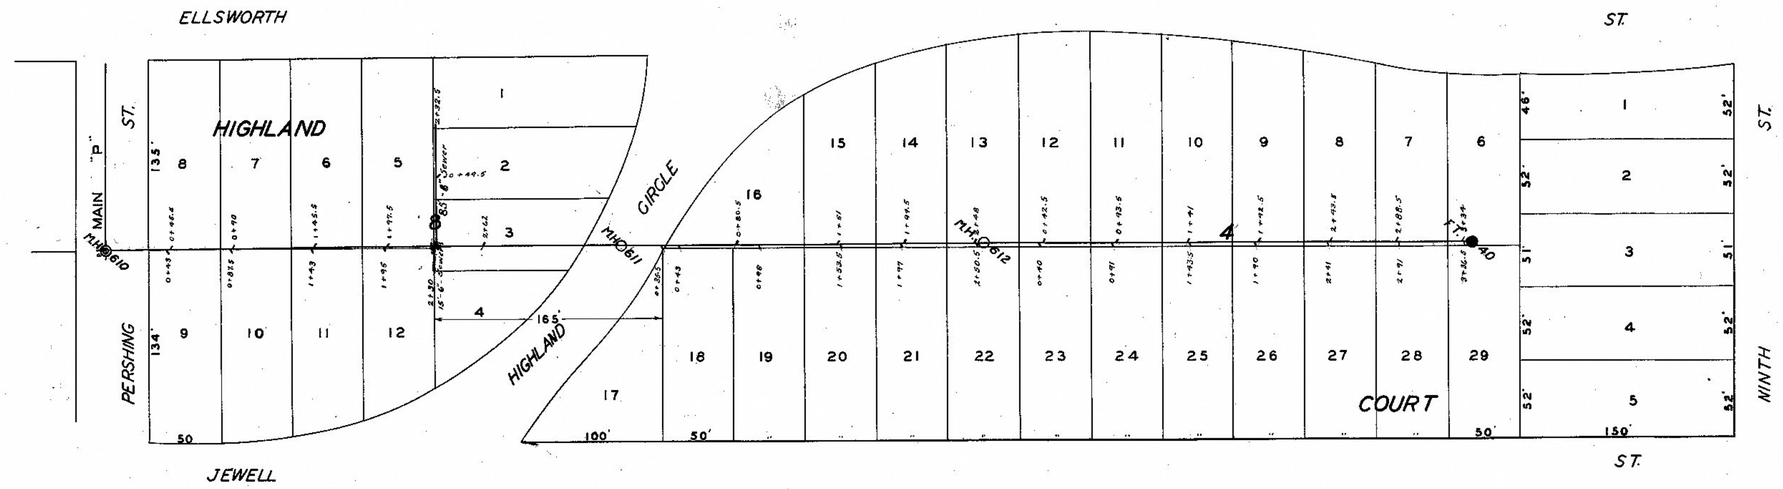

B.M. "M" ON HYD. - SUNSET DRIVE & HIGHLAND CIRCLE ELEV. 1235.87

PLAN		BY	DATE
NOTE BOOK	SURVEYED		
	PLOTTED		
	LAYOUT CHECKED		
NO.	RT. OF WAY CHECKED		

PROFILE		BY	DATE
NOTE BOOK	SURVEYED	Spencer Caldwell	
	PLOTTED		
	GRADES CHECKED		
	B.M.'S NOTED		
NO.	STRUCTURE NOTATIONS CHK'D		

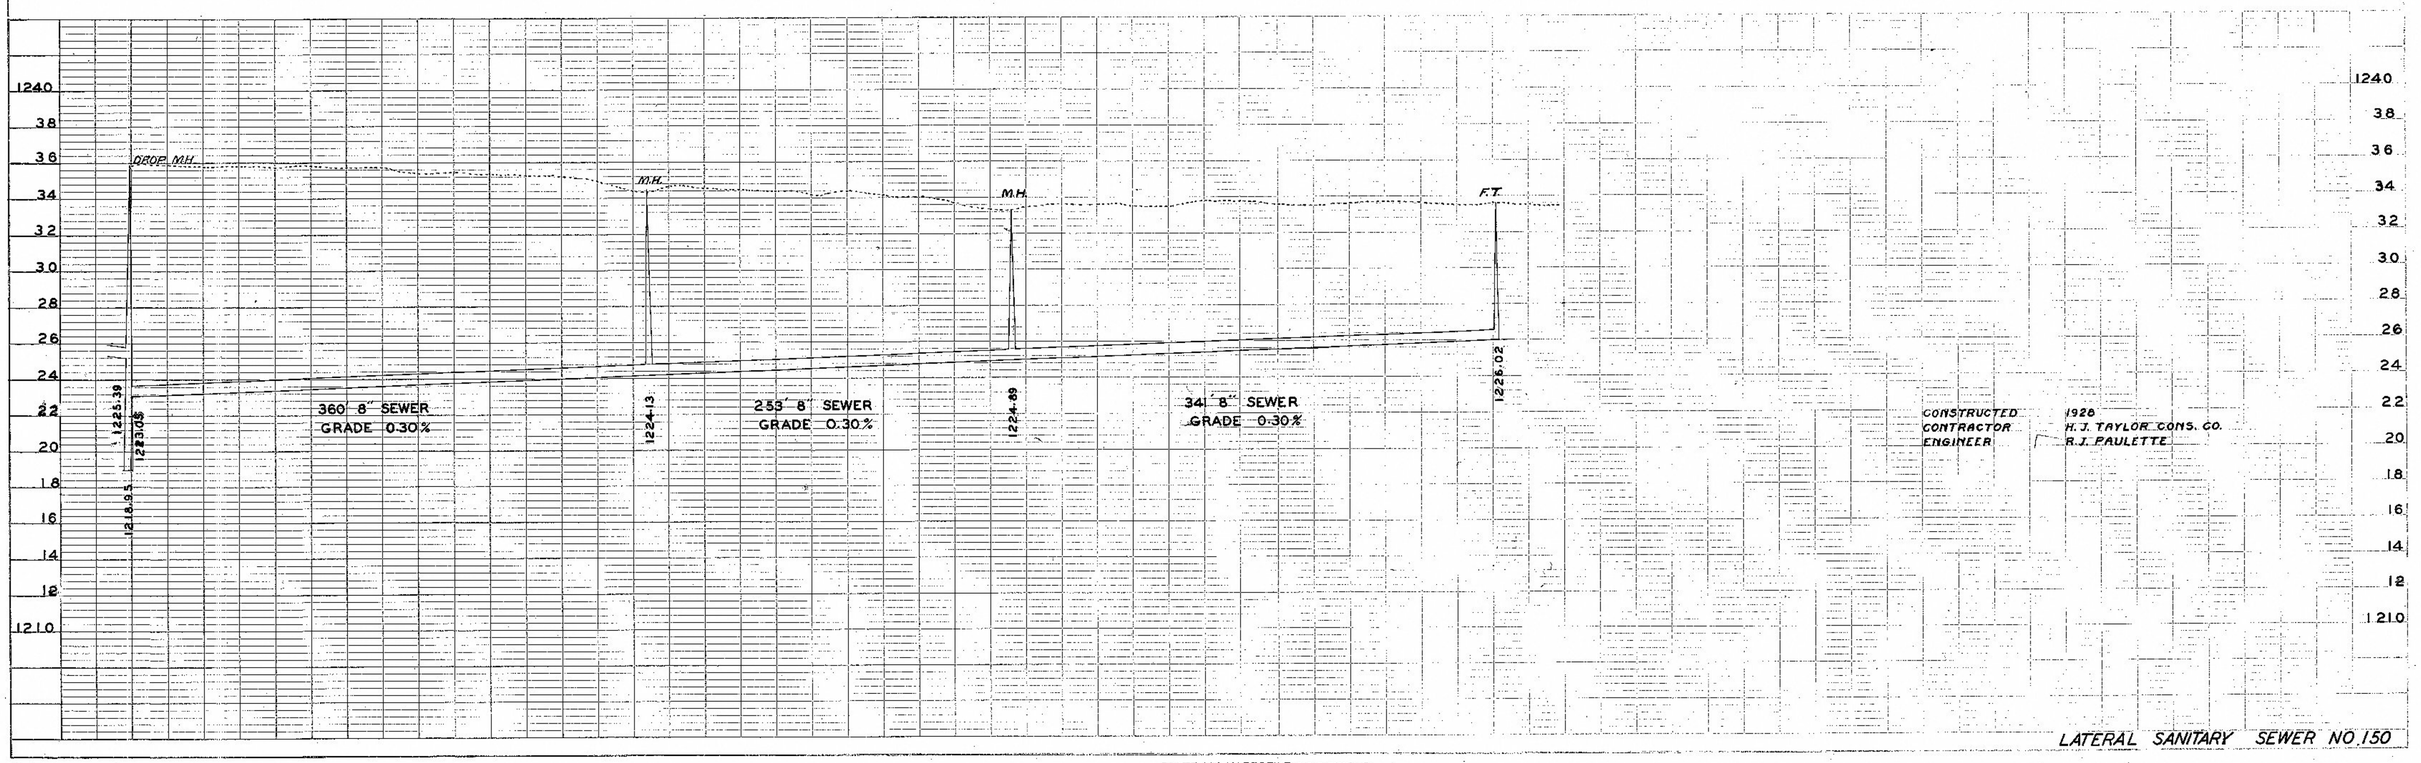

LATERAL SANITARY SEWER NO. 150

EUGENE DIETZGEN CO., CHGO., N. Y.

PLATE I-PLAN-PROFILE A. P. W. STANDARD

TRIM TO THIS LINE