
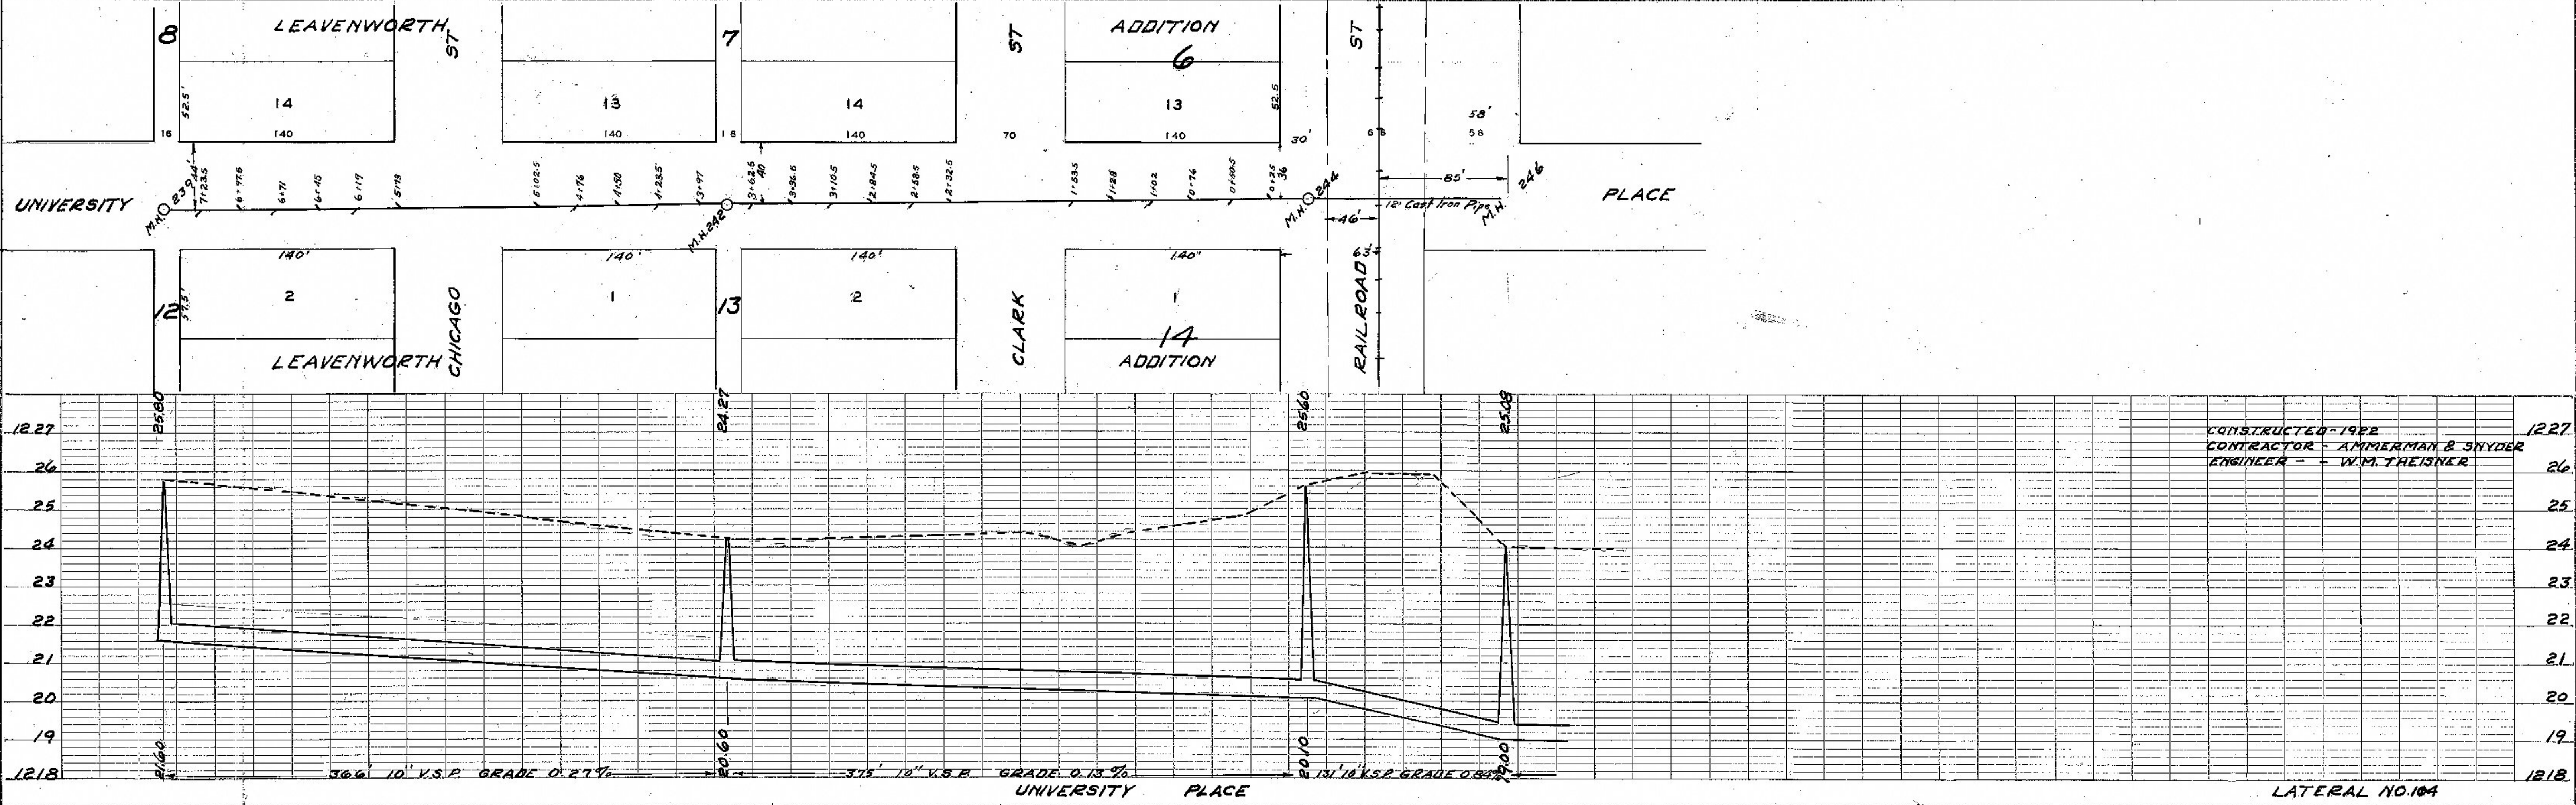


PLAN  
 SURVEYED BY: R.B.L.T.C.  
 PLOTTED BY: R.B.L.T.C.  
 ALIGNED CHECKED:  
 NOTE BOOK NO.:

PROFILE  
 SURVEYED BY: R.B.L.T.C.  
 PLOTTED BY: R.B.L.T.C.  
 ALIGNED CHECKED:  
 STRUCTURE NOTATIONS CHECKED:

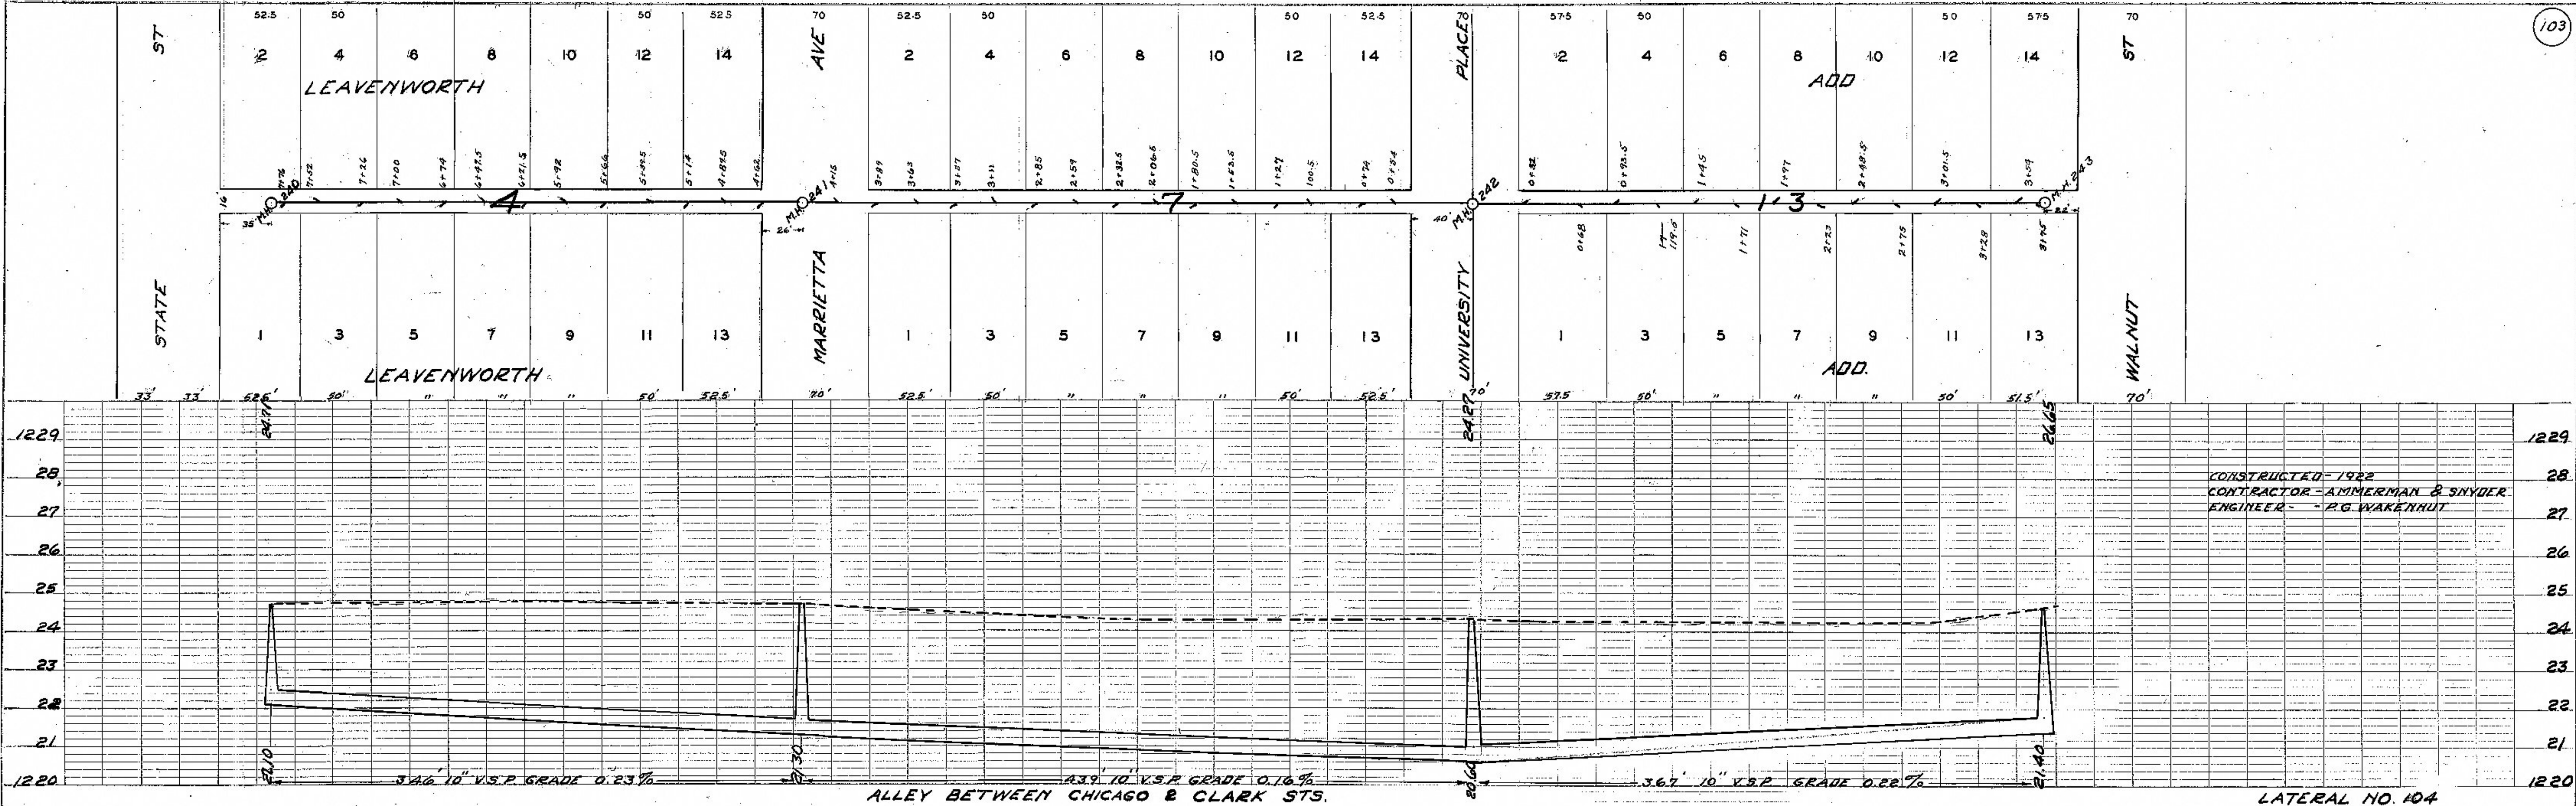

CONSTRUCTED - 1922  
 CONTRACTOR - AMMERMAN & SNYDER  
 ENGINEER - P.G. WAKENHUT

CONSTRUCTED - 1922  
 CONTRACTOR - AMMERMAN & SNYDER  
 ENGINEER - W.M. TREISNER