


PLAN

SURVEYED	DATE
PLOTTED	BY
ALIGNED	RE.B.
CHECKED	
NO. 10	

PROFILE

SURVEYED	DATE
PLOTTED	BY
GRADES CHECKED	
NO. 10	

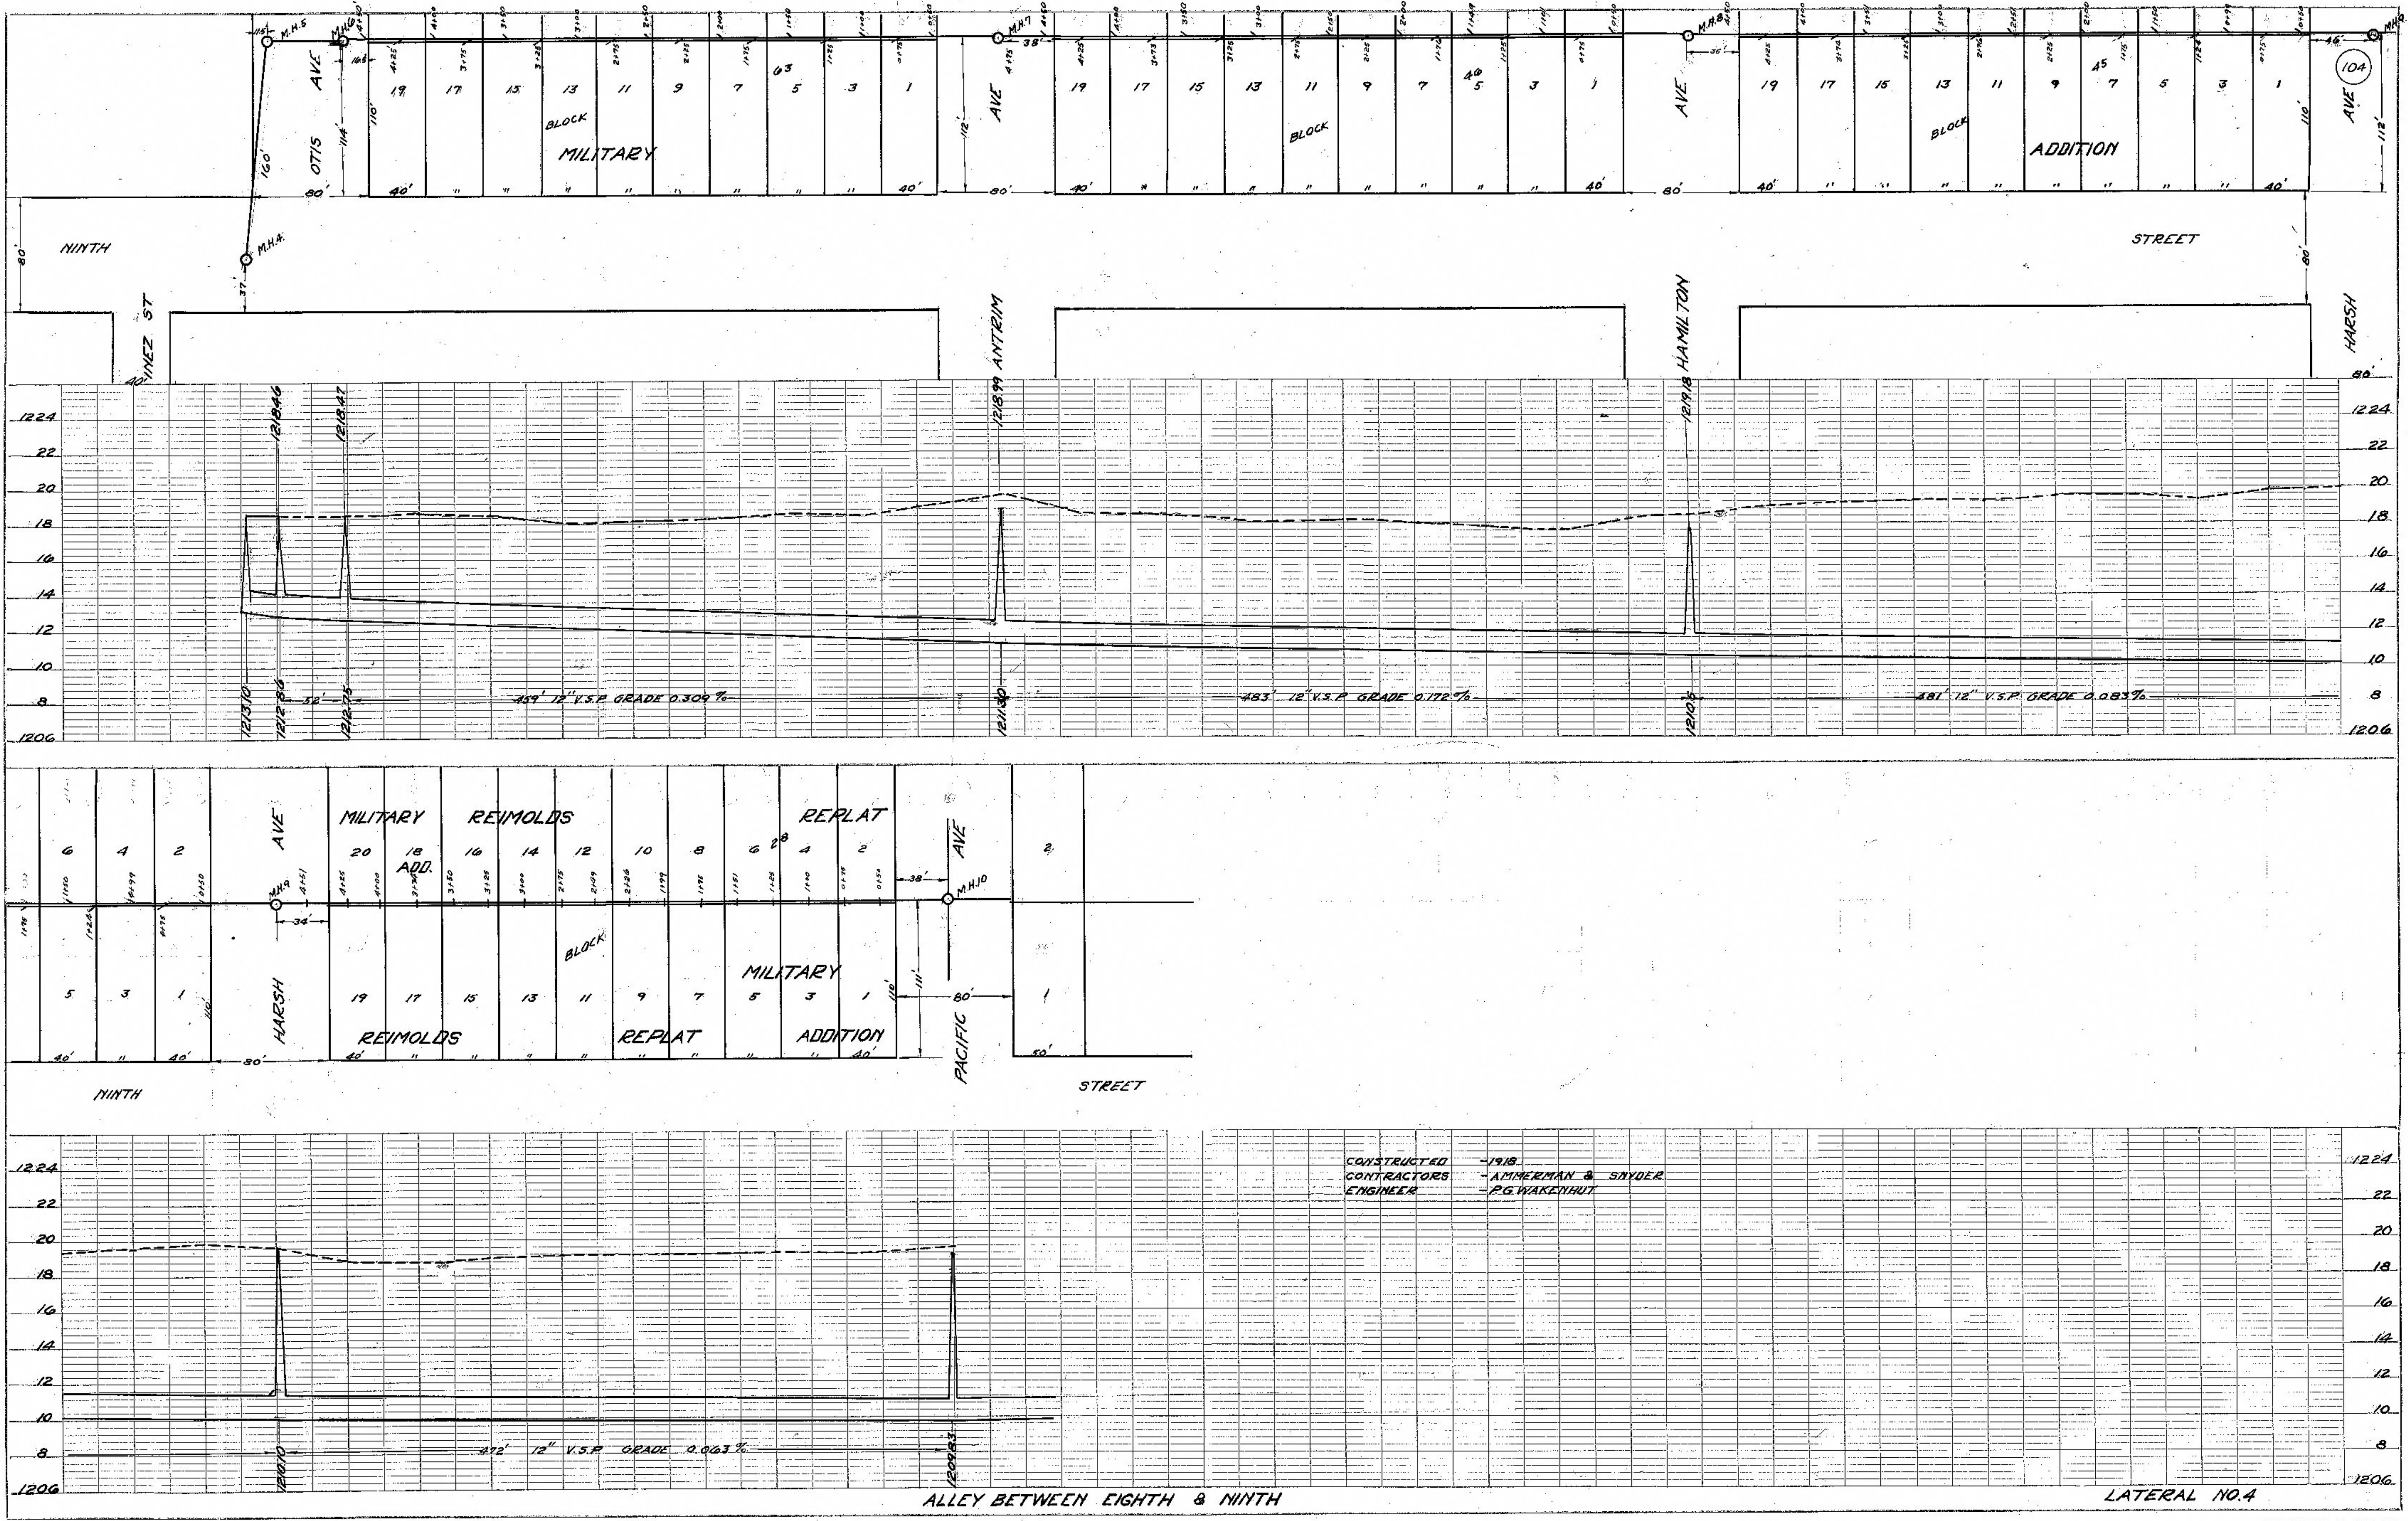

ALLEY BETWEEN EIGHTH & NINTH

LATERAL NO.4