


PLAN
 SURVEYED BY DATE
 PLOTTED BY
 CHECKED BY
 REVISIONS
 NO.

PROFILE
 SURVEYED BY DATE
 PLOTTED BY
 CHECKED BY
 REVISIONS
 NO.

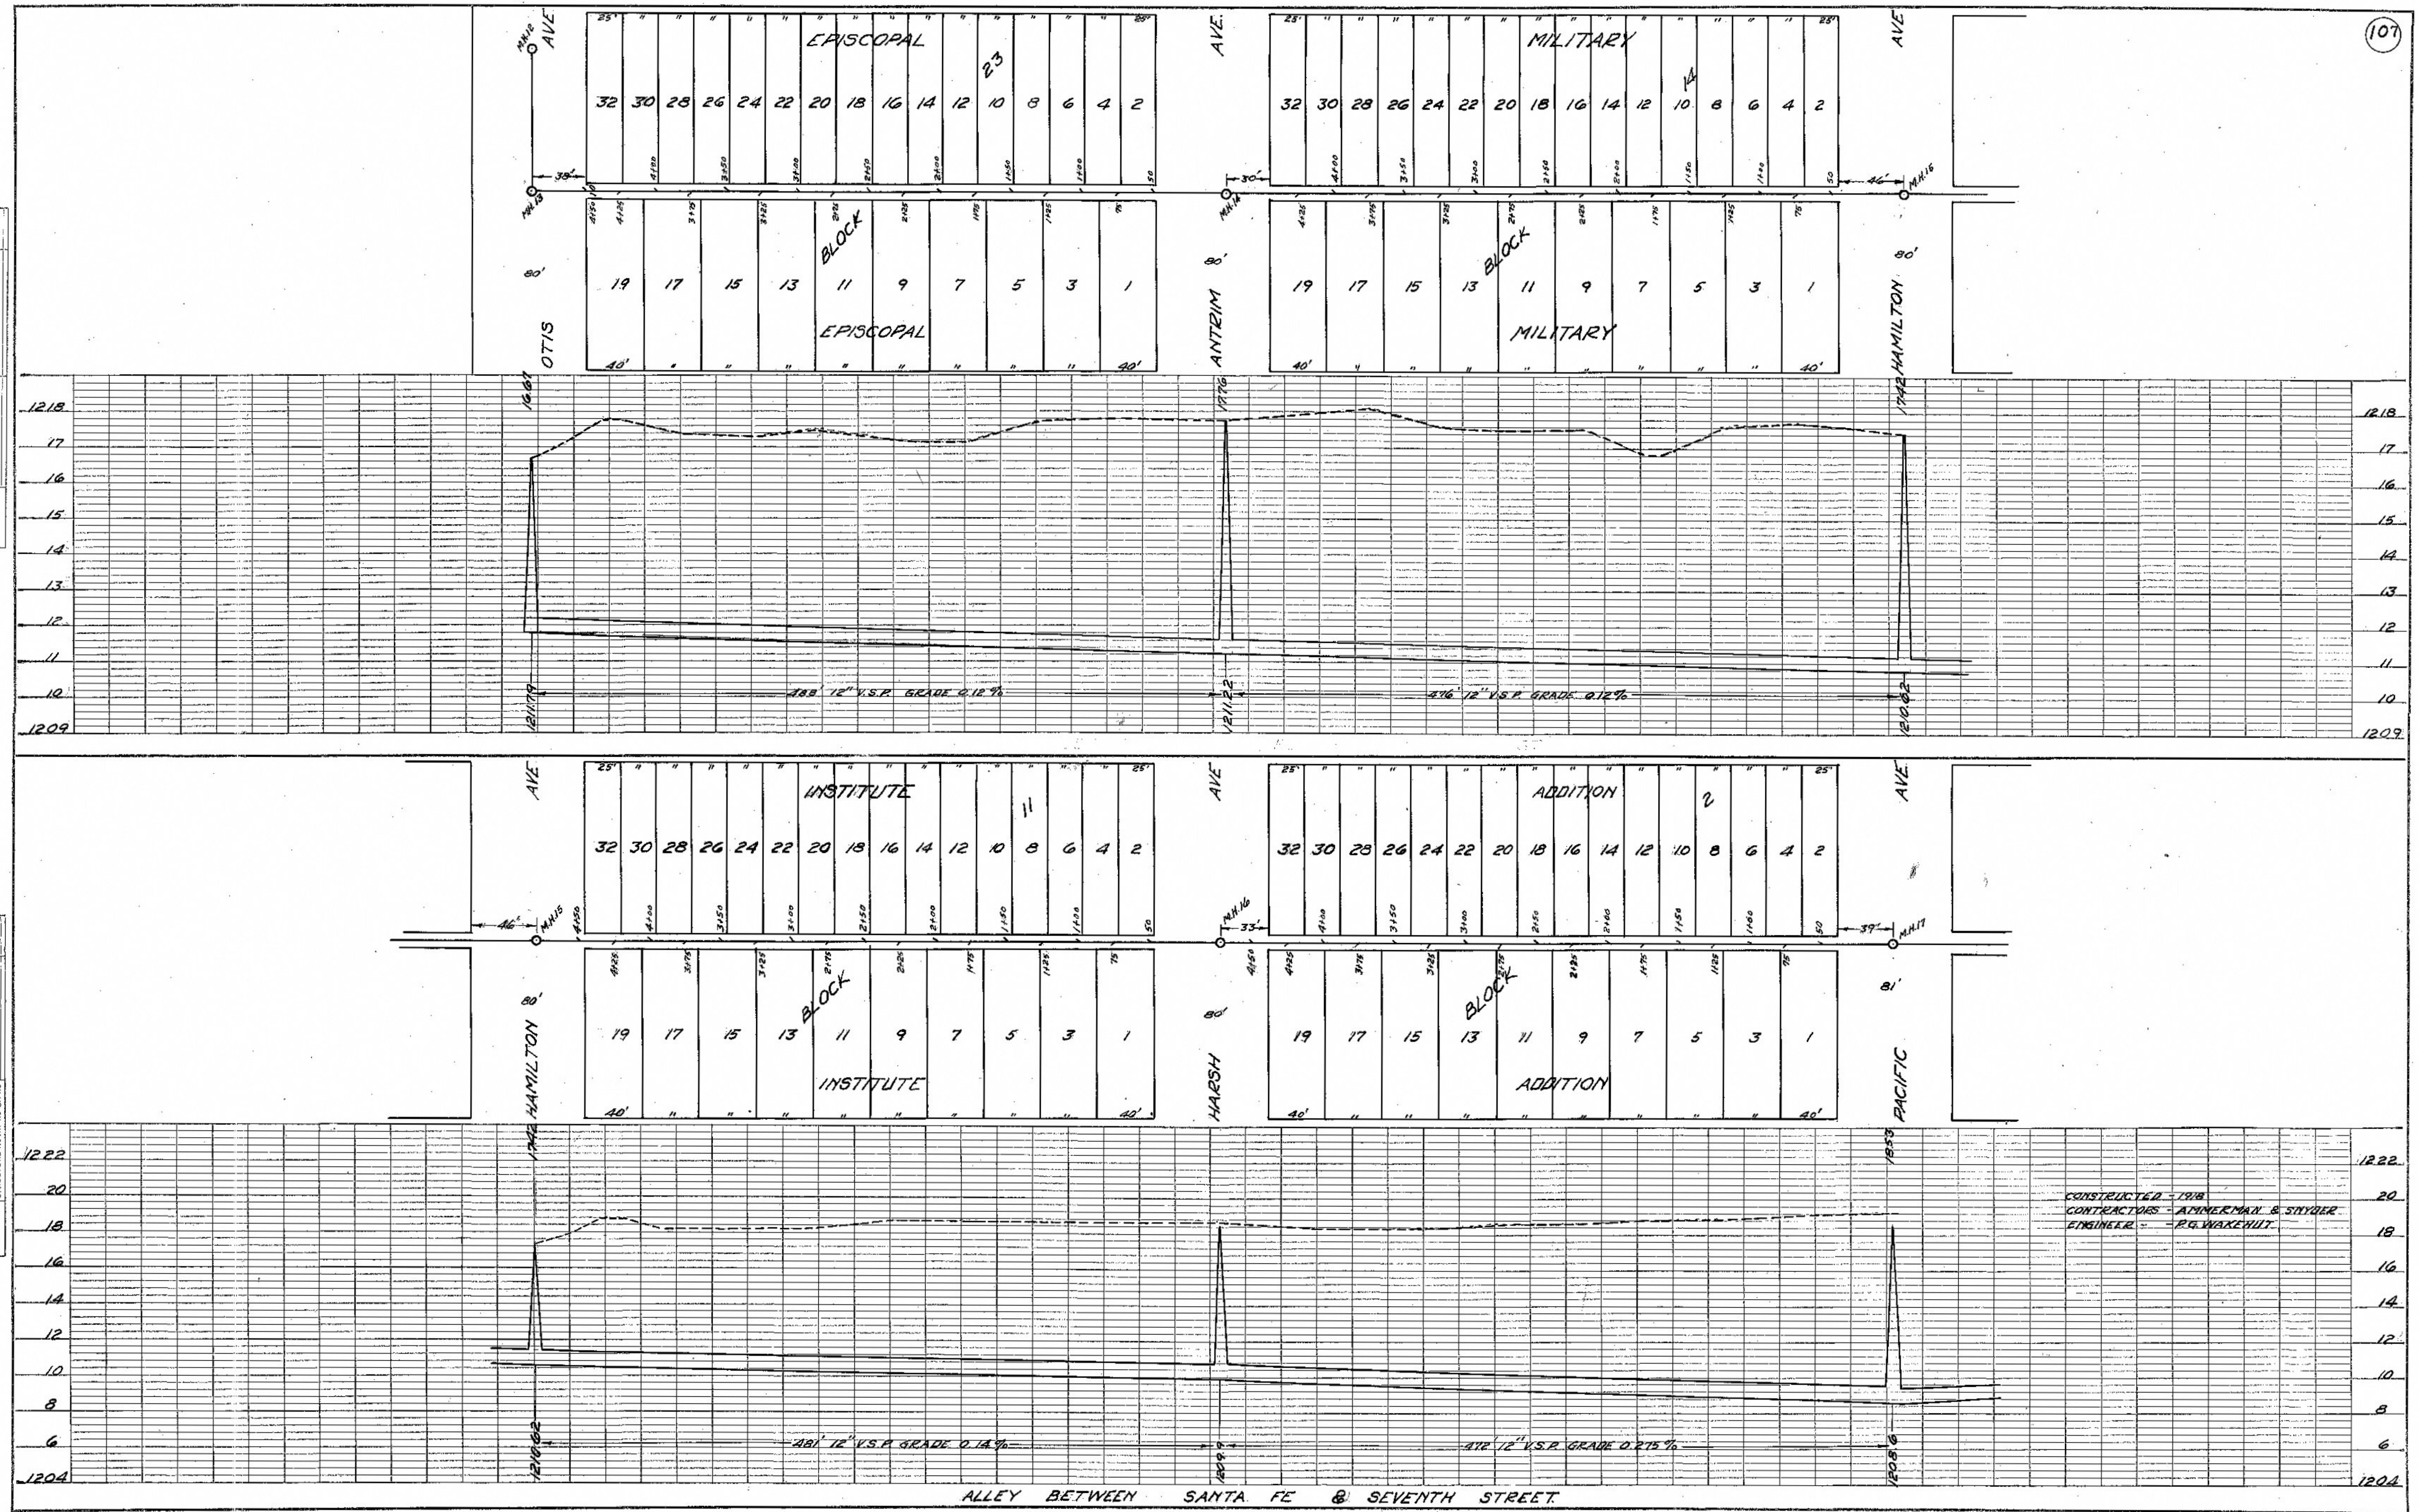

ALLEY BETWEEN SANTA FE & SEVENTH STREET

CONSTRUCTED - 1918
 CONTRACTORS - AMMERMAN & STYDER
 ENGINEER - P. G. WAKEWILL