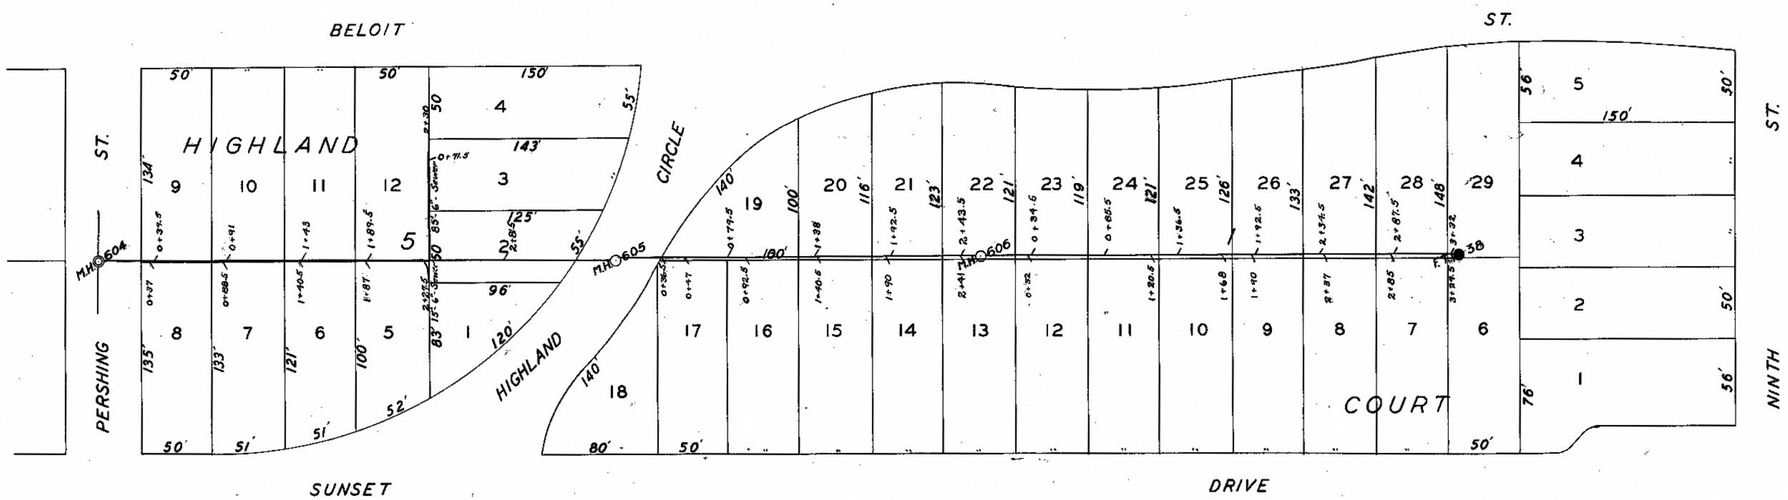

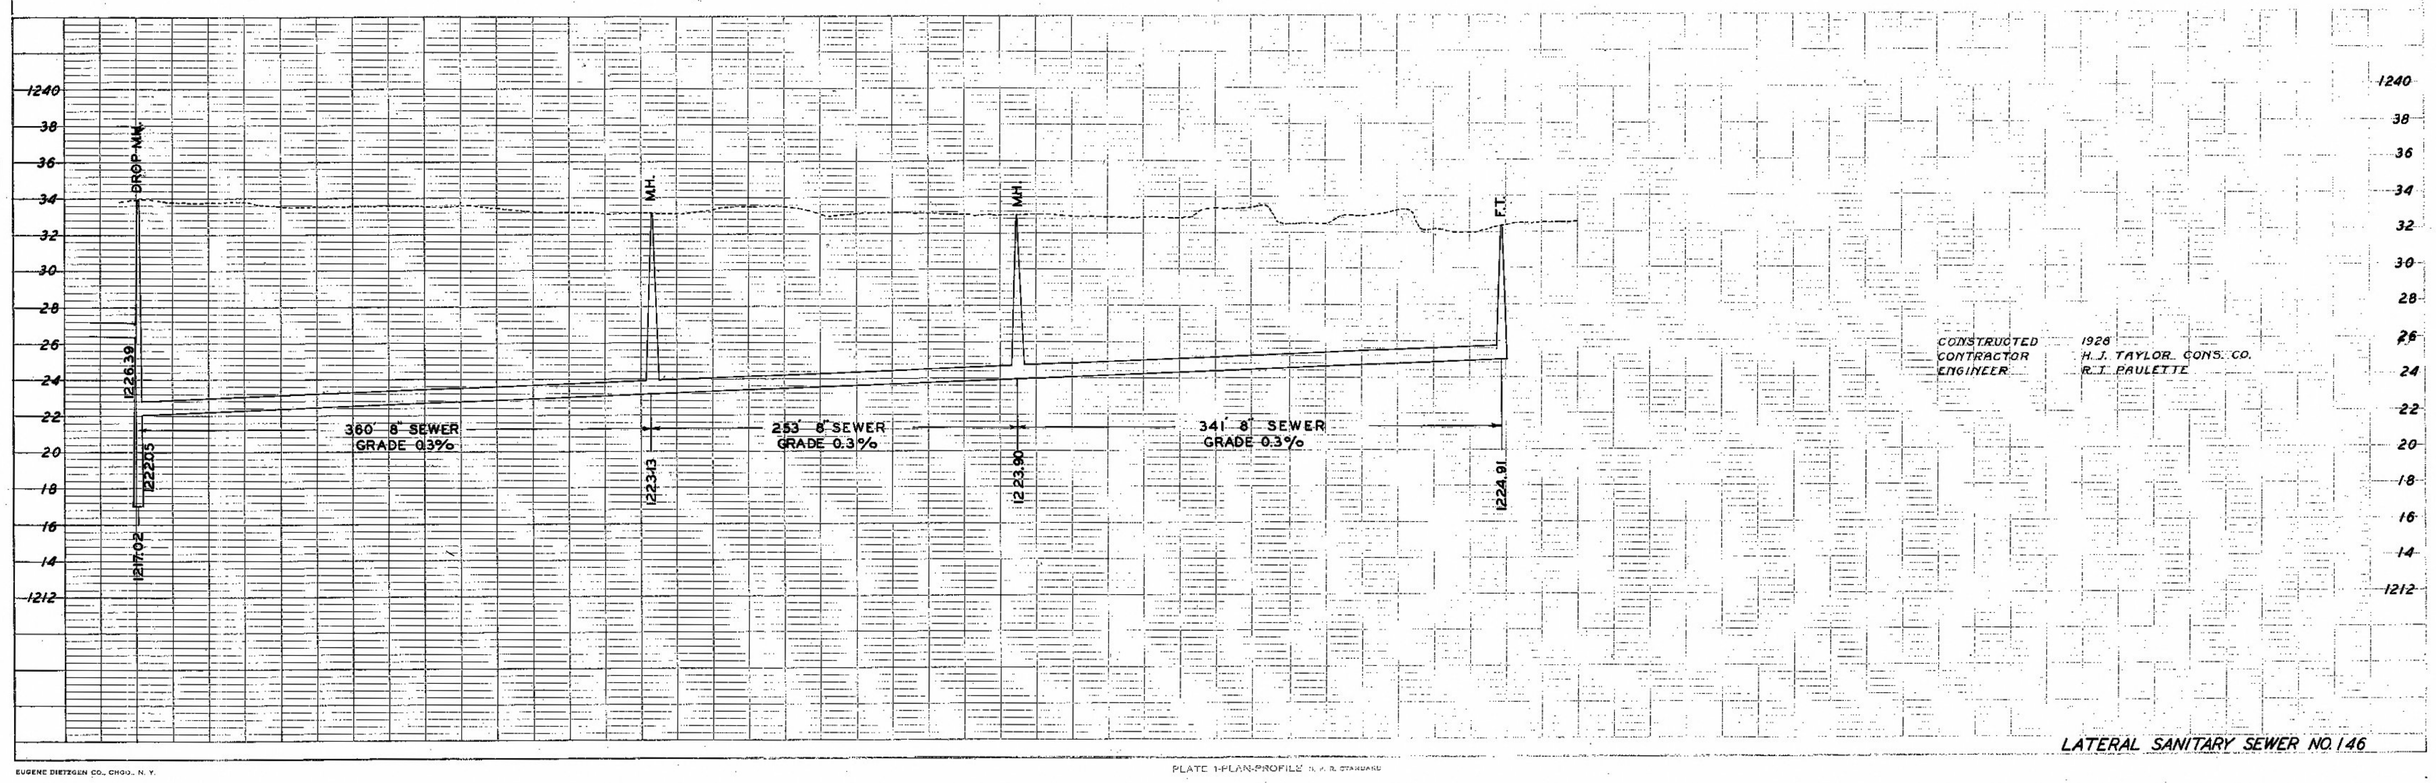

LATERAL SANITARY SEWER NO. 146

PLAN
SURVEYED
NOTE BOOK PLOTTED
ALIGNMENT CHECKED
RT. OF WAY CHECKED
NO.

BM. "M" ON HYD. BELOIT & HIGHLAND
CIRCLE ELEV. 1235.90

PROFILE
SURVEYED
NOTE BOOK PLOTTED
GRADES CHECKED
B.M.'S NOTED
NO. 35 STRUCTURE NOTATIONS CHECKED

BY SRACK
PAULETTE
DATE 6-22-28

EUGENE DIETZGEN CO., CHGO., N. Y.

PLATE 1-PLAN-PROFILE S. A. B. STANDARD

TRIM TO THIS LINE