(117)

PLAN

	BY	DATE
SURVEYED		
PLOTTED		
ALIGNMENT CHECKED		
RT. OF WAY CHECKED		

NOTE BOOK NO.

PROFILE

	BY	DATE
SURVEYED		
PLOTTED	L.A.CHADWELL	
GRADES CHECKED		
B. Ms. NOTED		
STRUCTURE NOTATNS CHKD		

NOTE BOOK No. 28

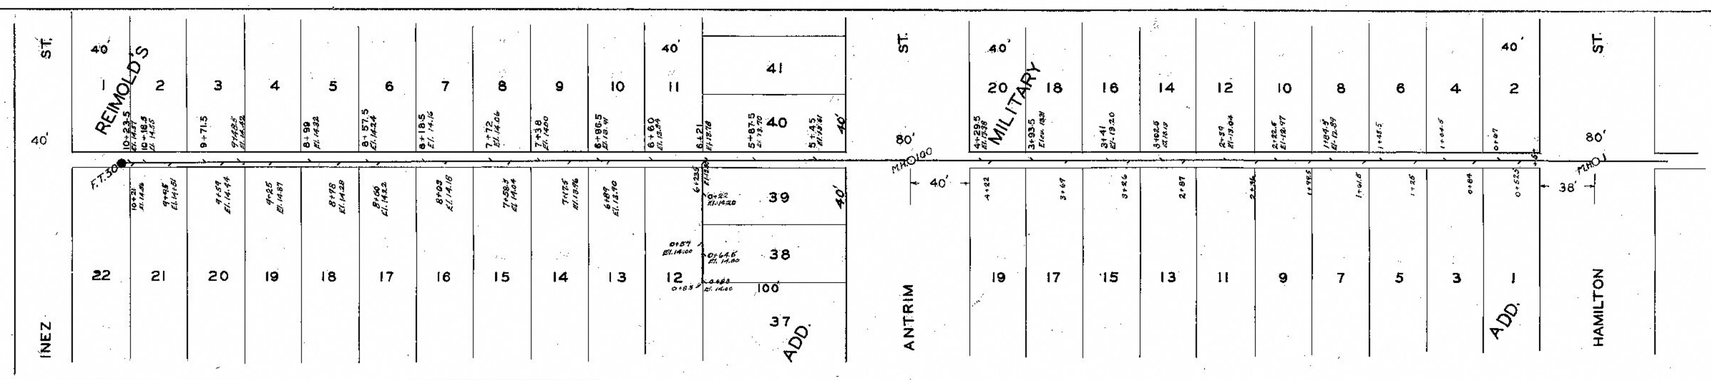

B.M. "M" ON HYD. 9TH & HAMILTON ELEV 1220.50 BOOK NO 28 ALLEY BET. NINTH & TENTH HAMILTON TO INEZ LATERAL SANITARY SEWER NO 132

PLATE 2-PLAN-PROFILE B. P. R. STANDARD

EUGENE DIETZGEN CO. CHICAGO, N.Y.