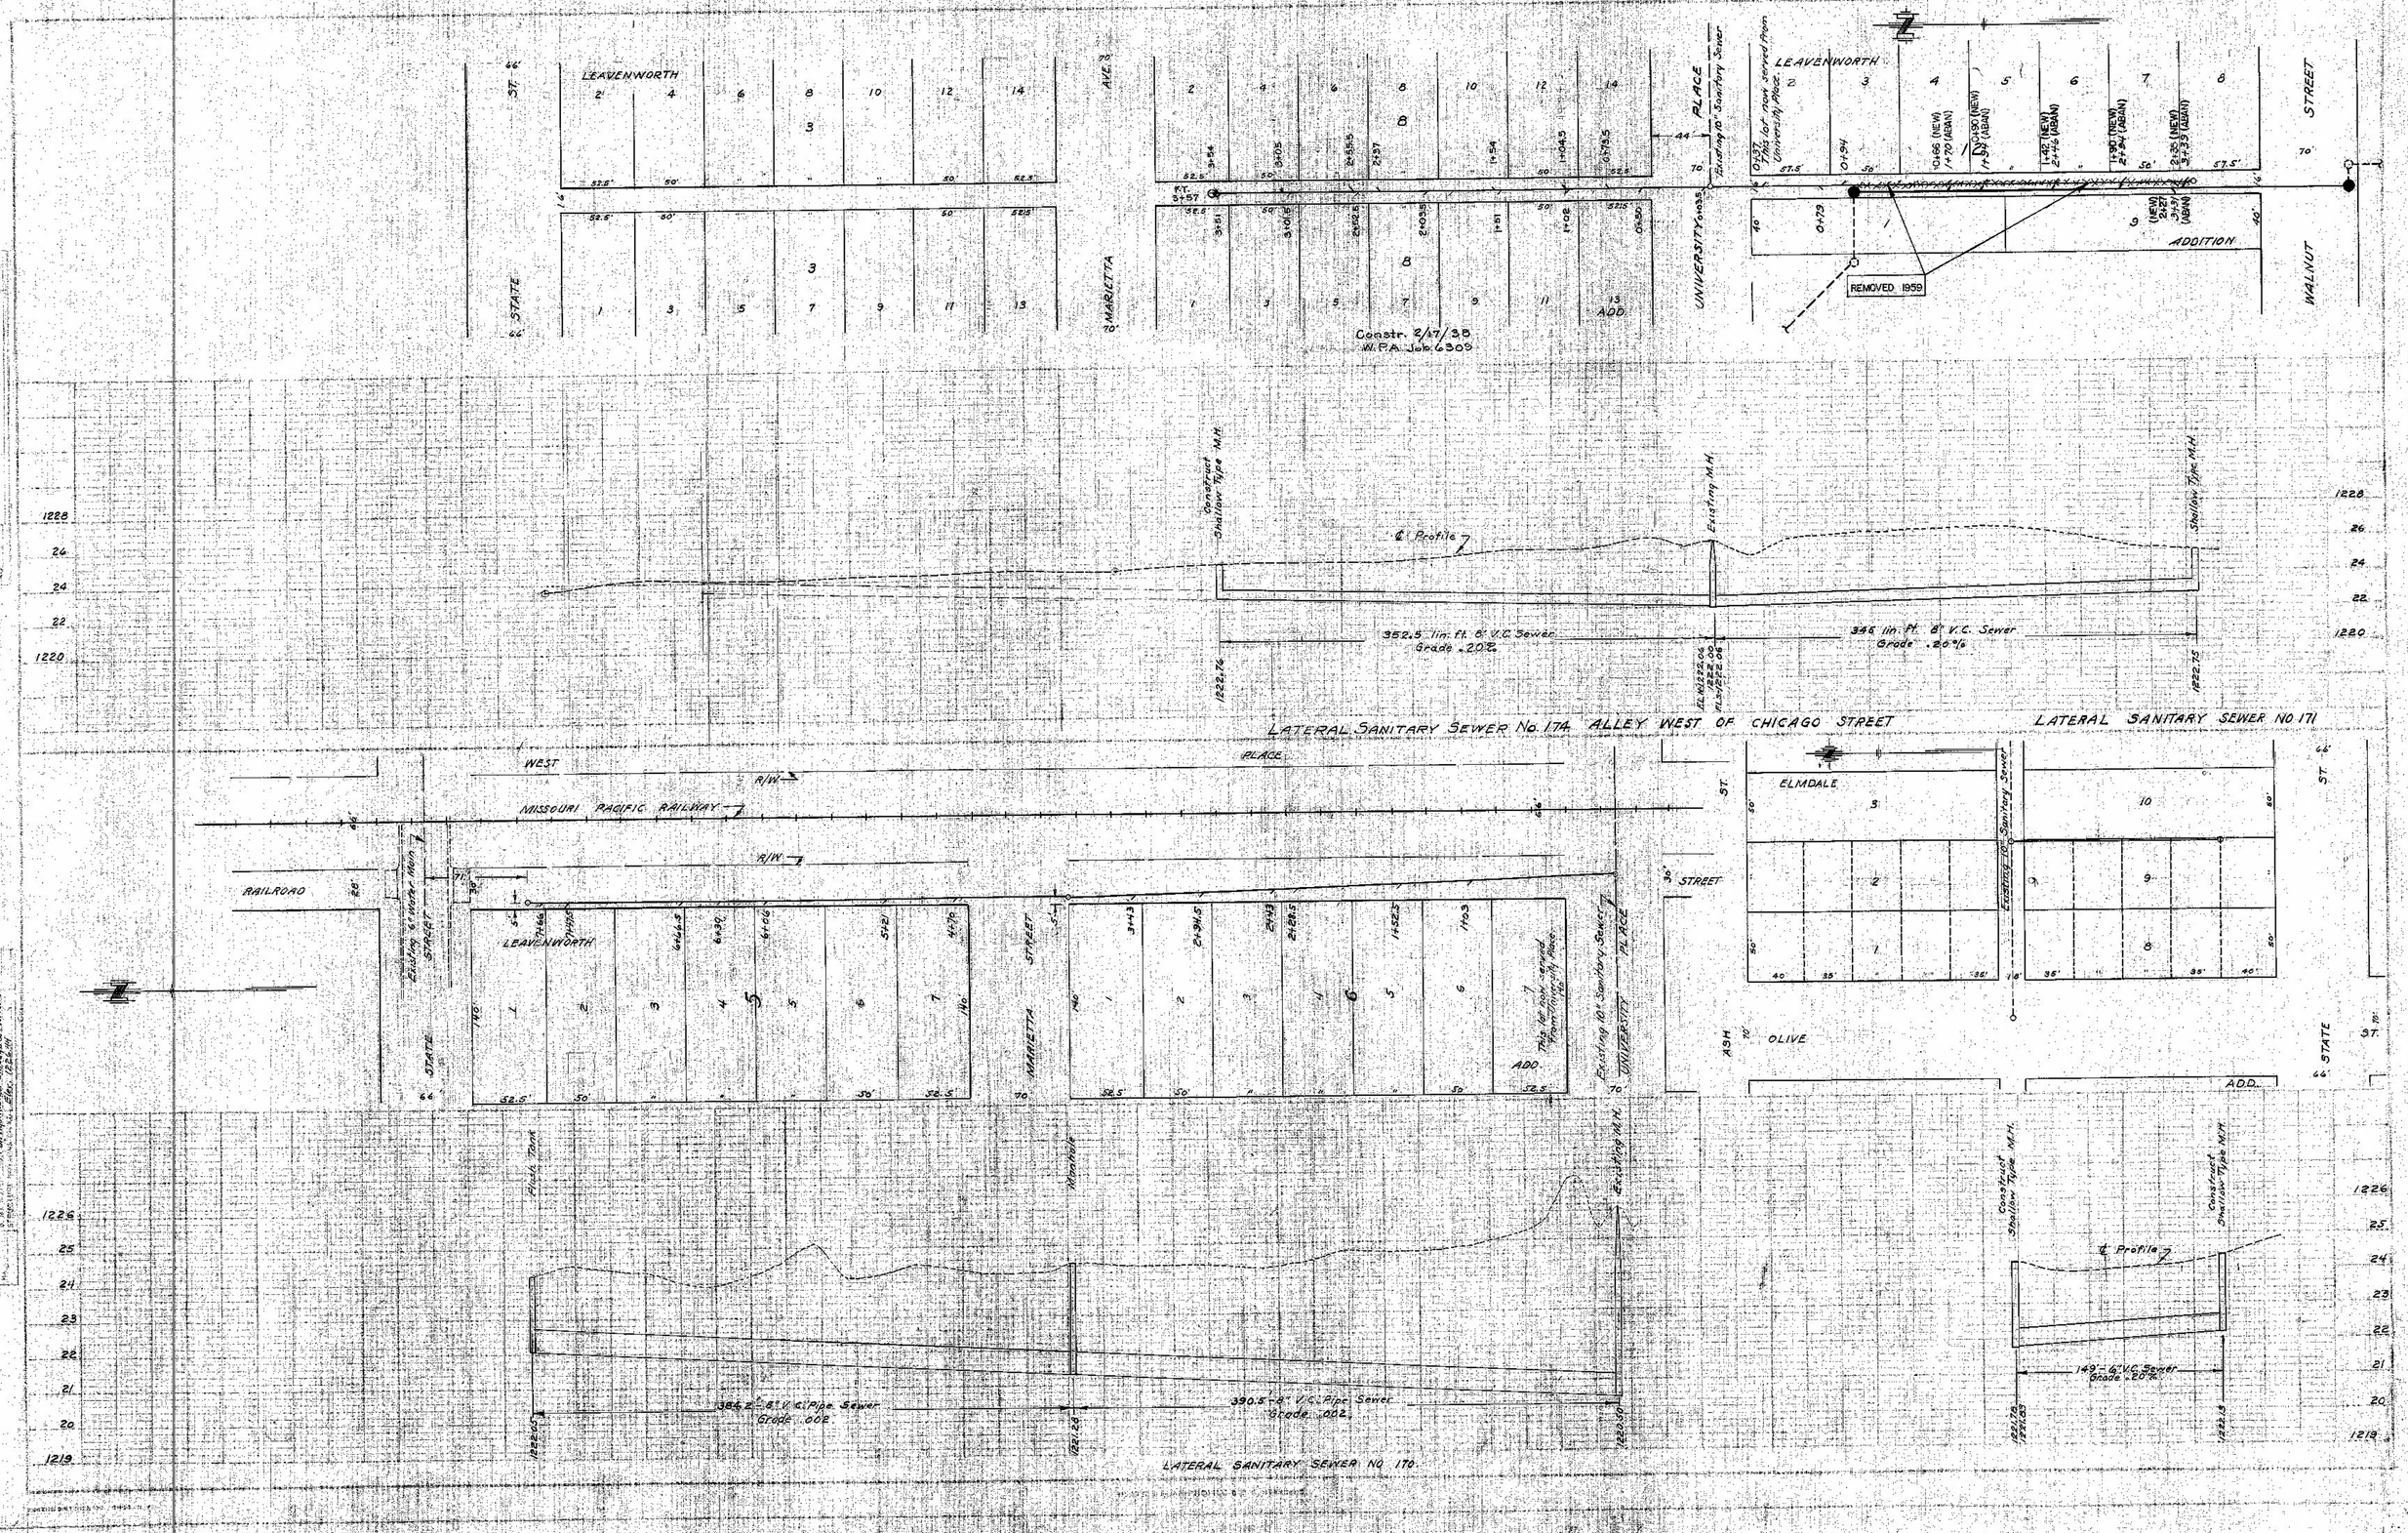
LEAVENWORTH
STATE ST.
S. MARIETTA AVE.
UNIVERSITY PLACE
Existing 10" Sanitary Sewer
Constr. 2/17/38
W.P.A. Job 6309
REMOVED 1959
ADDITION
WALNUT STREET
Constructed Shallow Type M.H.
Existing M.H.
℄ Profile
352.5 lin. ft. 8" V.C. Sewer
Grade .20%
348 lin. ft. 8" V.C. Sewer
Grade .20%
LATERAL SANITARY SEWER No. 174 ALLEY WEST OF CHICAGO STREET
LATERAL SANITARY SEWER NO 171
WEST PLACE
R/W
MISSOURI PACIFIC RAILWAY
RAILROAD
Existing 8" Water Main
STATE STREET
MARIETTA STREET
UNIVERSITY PLACE
Existing 10" Sanitary Sewer
Flush Tank
384.2 - 8" V.C. Pipe Sewer
Grade .002
390.5 - 8" V.C. Pipe Sewer
Grade .002
LATERAL SANITARY SEWER NO 170
ELMDALE
OLIVE
ASH
ADD.
149' - 6" V.C. Sewer
Grade .20%