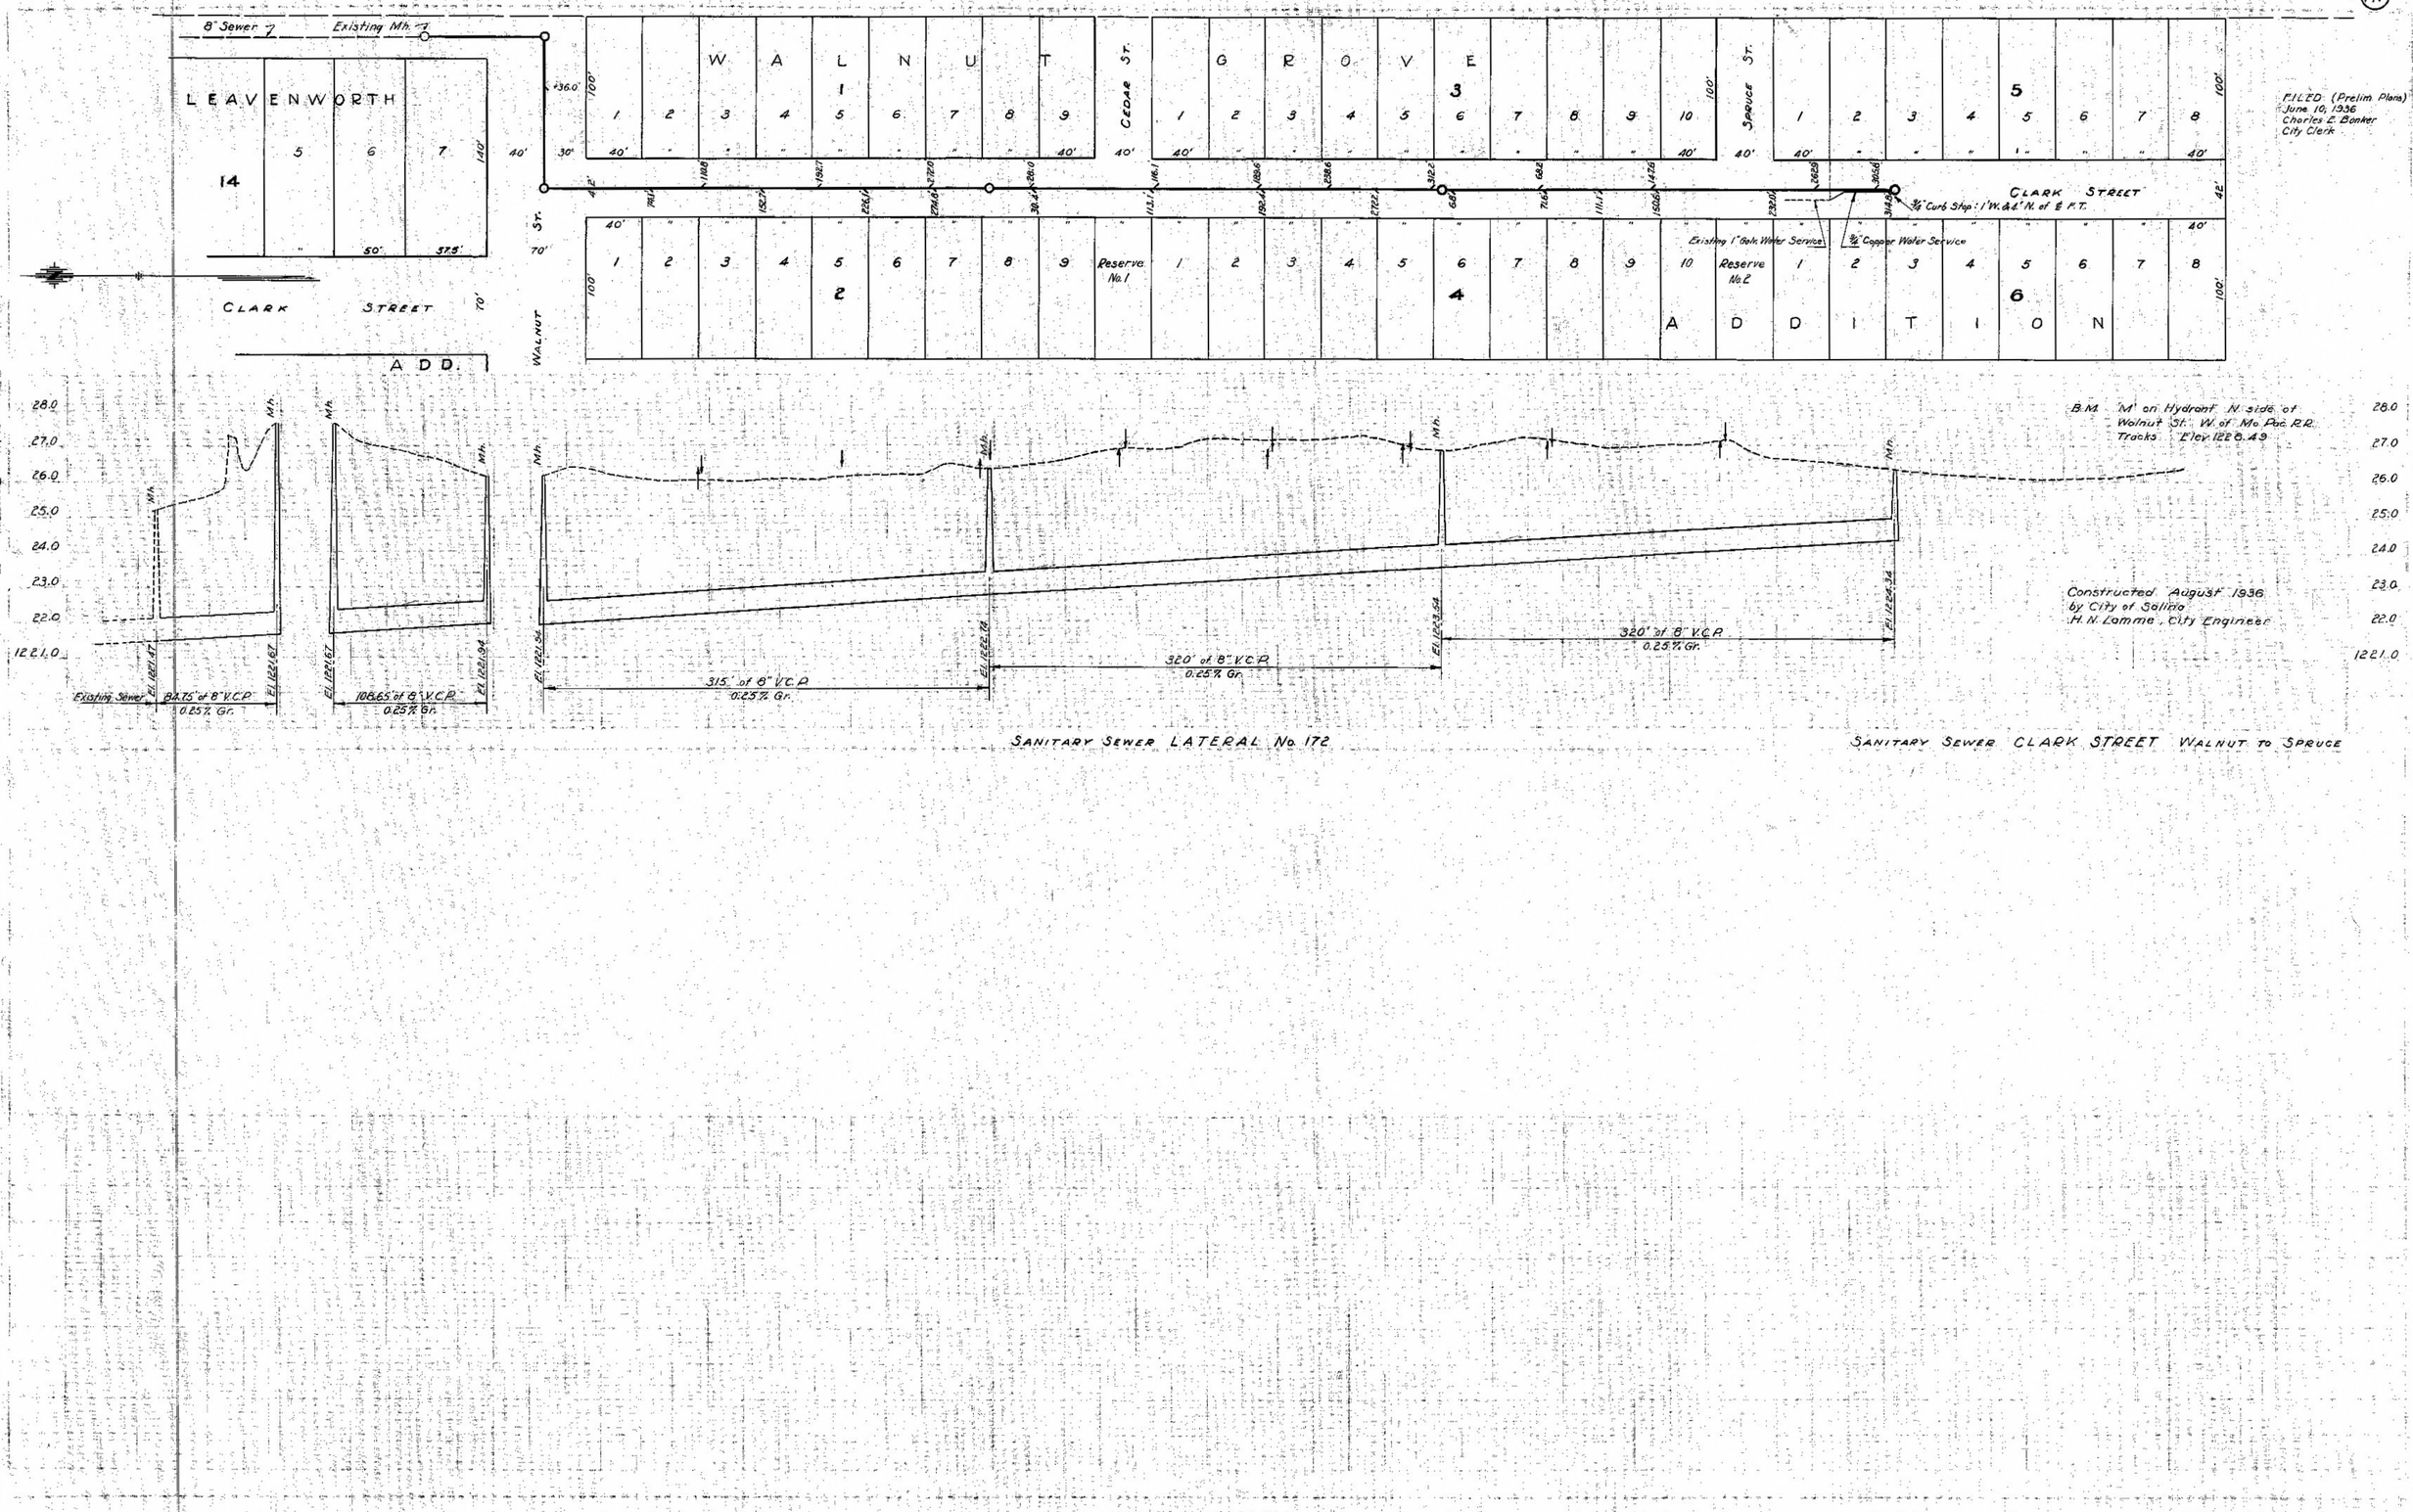
8" Sewer
Existing Mh.
LEAVENWORTH
CLARK STREET ADD.
WALNUT ST.
CEDAR ST.
GROVE
SPRUCE ST.
CLARK STREET
Reserve No. 1
Reserve No. 2
ADDITION
Existing 1" Galv. Water Service
¾" Copper Water Service
¾" Curb Stop: 1' W. & 4' N. of ⊕ F.T.
FILED (Prelim. Plans) June 10, 1936 Charles E. Booker City Clerk
B.M. 'M' on Hydrant N. side of Walnut St. W. of Mo. Pac. R.R. Tracks. Elev. 1220.49
Existing Sewer
8.75' of 8" V.C.P. 0.25% Gr.
108.65' of 8" V.C.P. 0.25% Gr.
315' of 8" V.C.P. 0.25% Gr.
320' of 8" V.C.P. 0.25% Gr.
320' of 8" V.C.P. 0.25% Gr.
Constructed August 1936 by City of Salina H. N. Lamme, City Engineer
SANITARY SEWER LATERAL No. 172
SANITARY SEWER CLARK STREET WALNUT TO SPRUCE