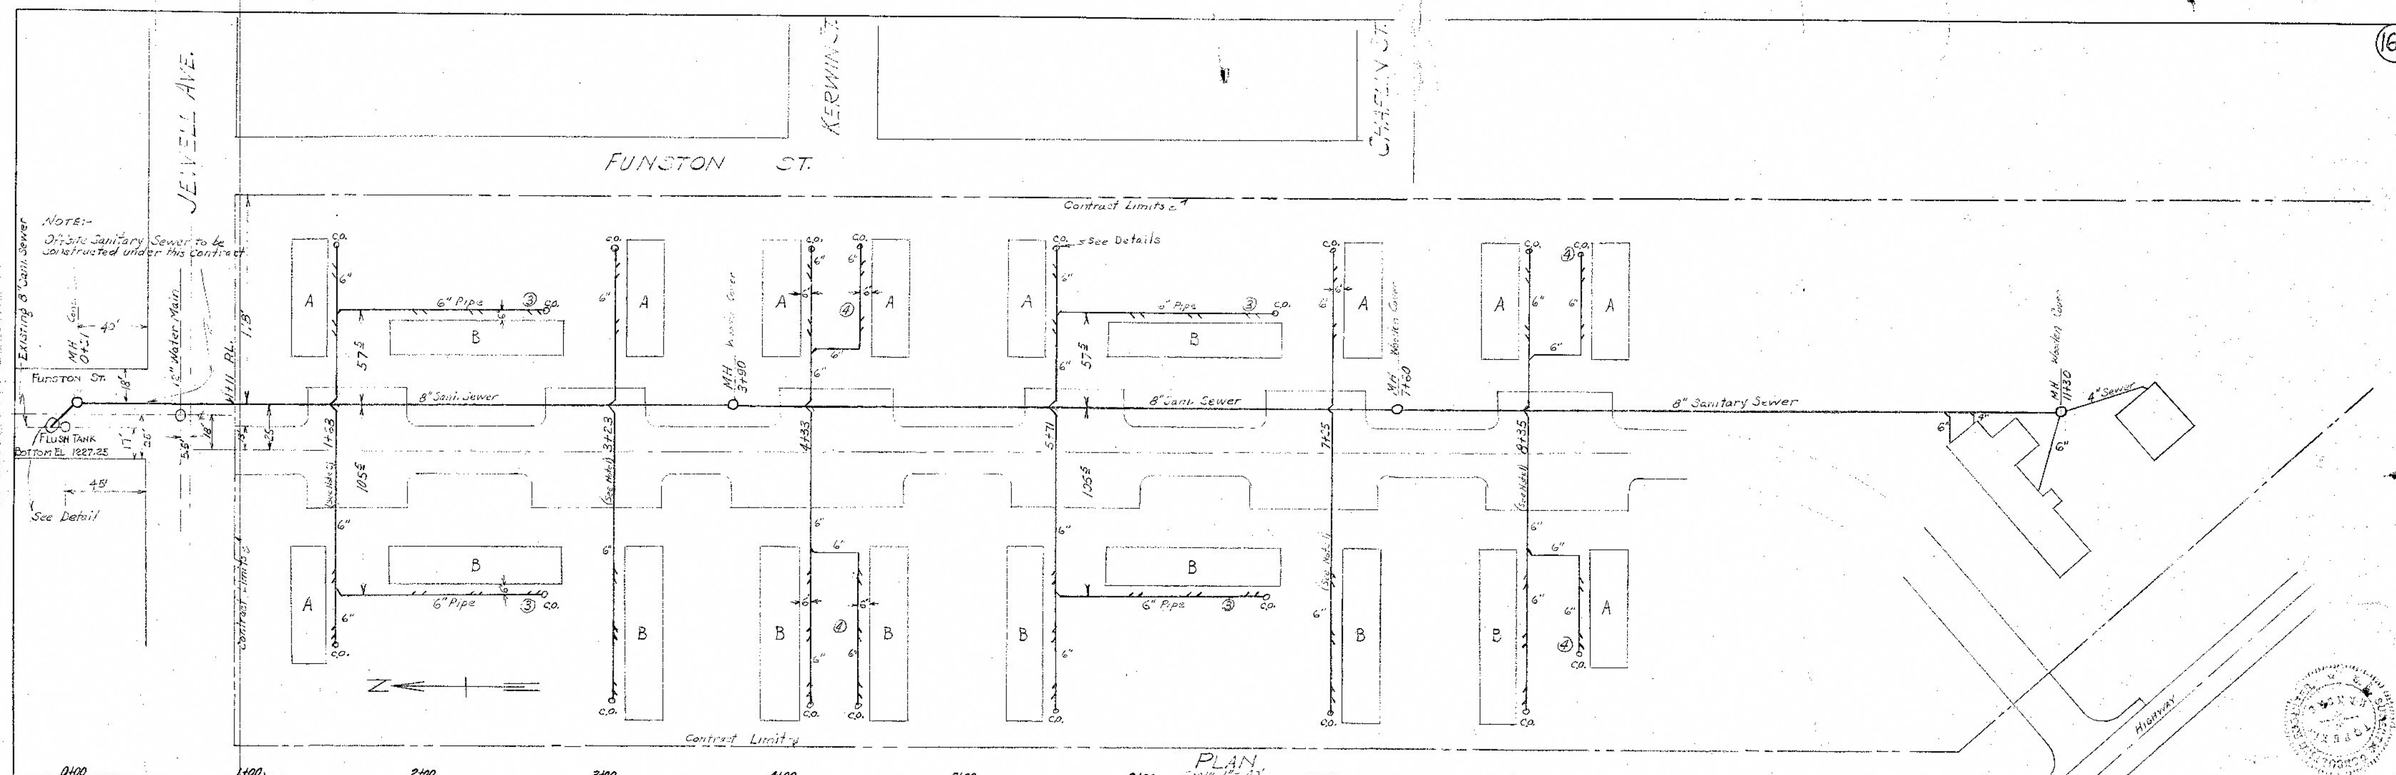

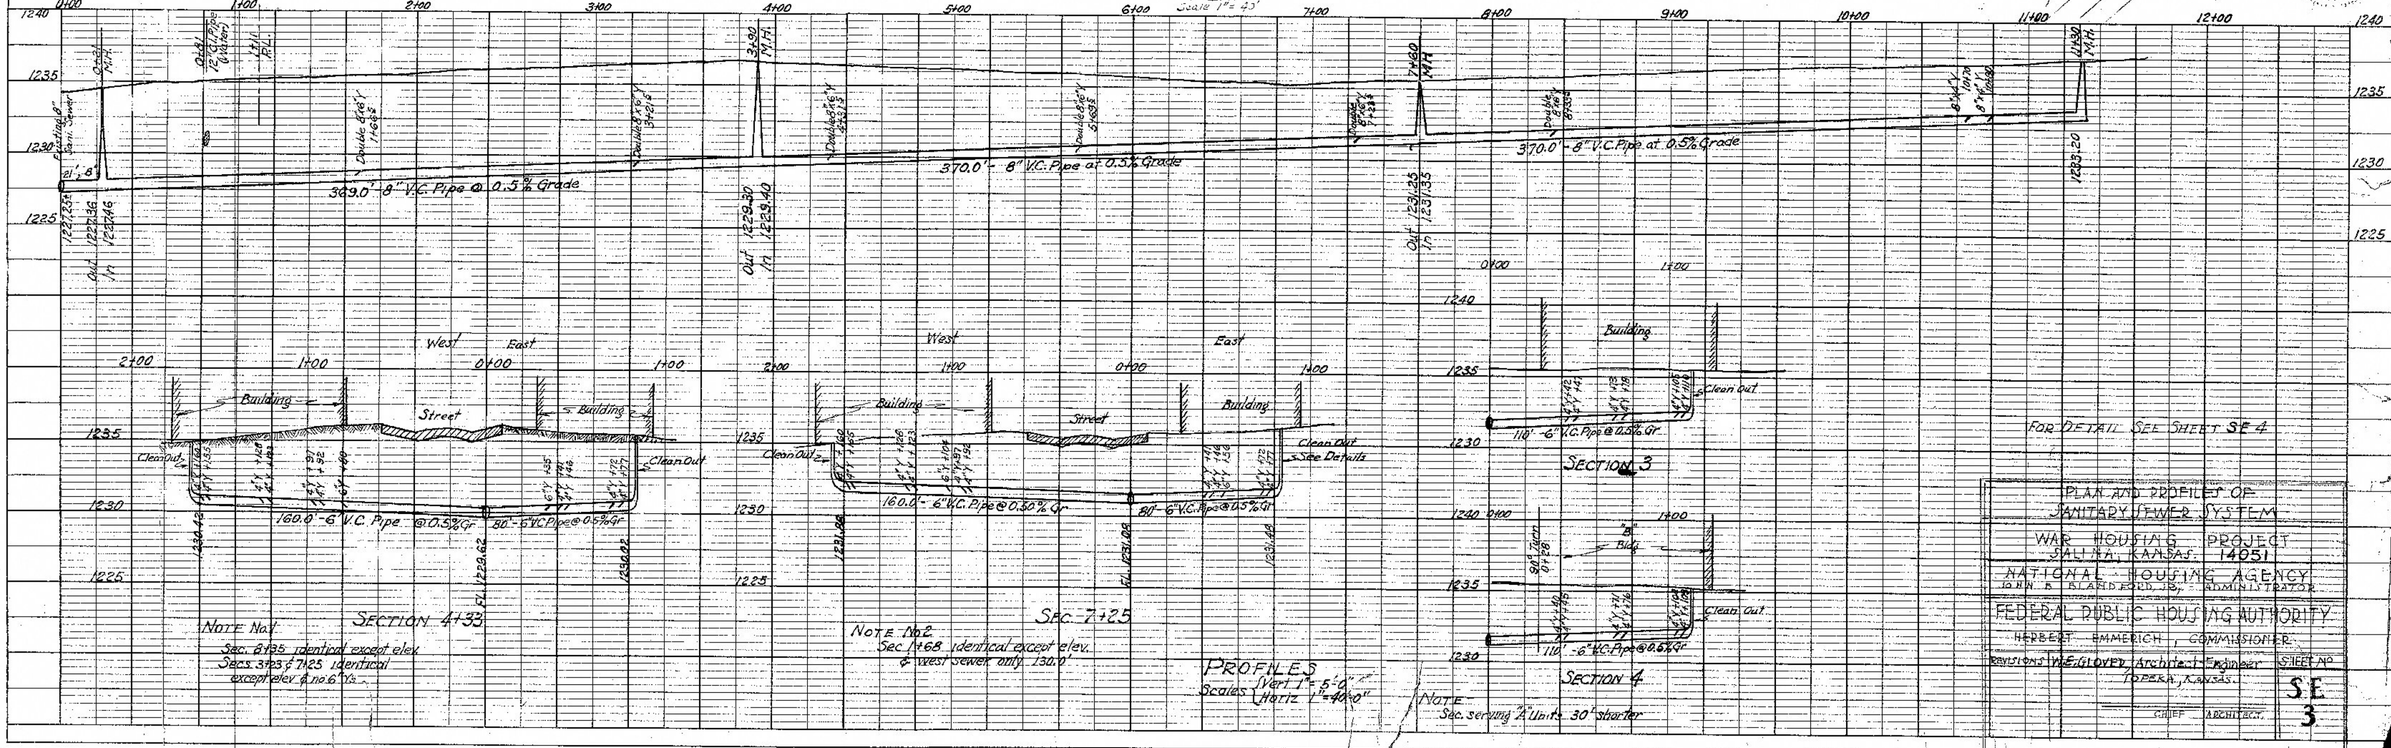

PLATE 1-PLAN-PROFILE B. R. R. STANDARD
100% RAG PAPER—MADE AND PRINTED IN U. S. A.
EUGENE DIETZGEN CO.