1389 G 187

172

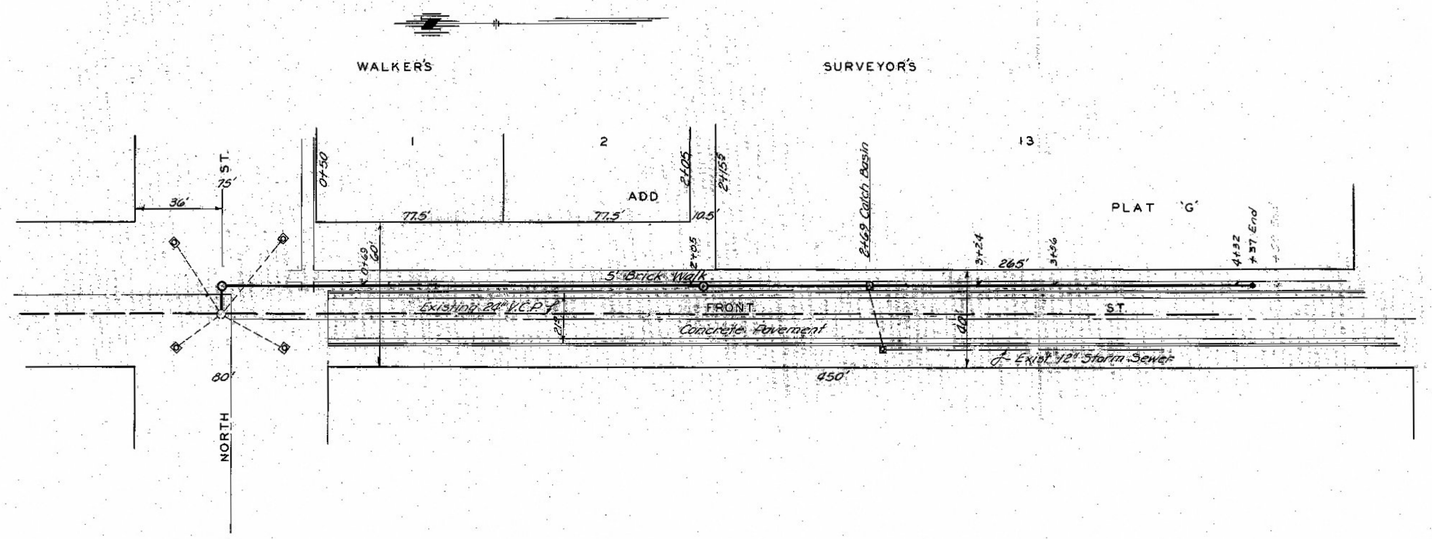

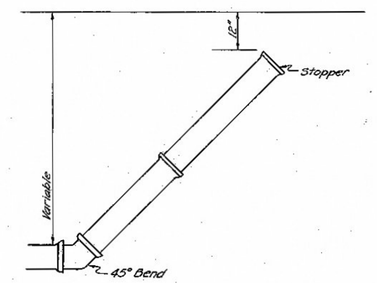

DETAIL
CLEAN OUT
SCALE 1/2" = 1'-0"

B.M. #453 'R' in Corey Fire Hyd. S.W. Cor. Front & North St. Elev. = 1222.32

Scale: Hor. 1" = 30'
Ver. 1" = 4'

Note: All MH Lids are Conc.

AS BUILT MAY 1945

CITY OF SALINA
ENGINEERING DEPARTMENT

SANITARY SEWER
LATERAL NO 201
FRONT ST. FROM NORTH ST.
SOUTH 430±'

JOB NO. 208

ORD. NO. 5077
C. C. MACFARLANE
CITY ENGINEER

FILED Mar. 23 1945
Ethel Rankin
CITY CLERK