GG-118

181

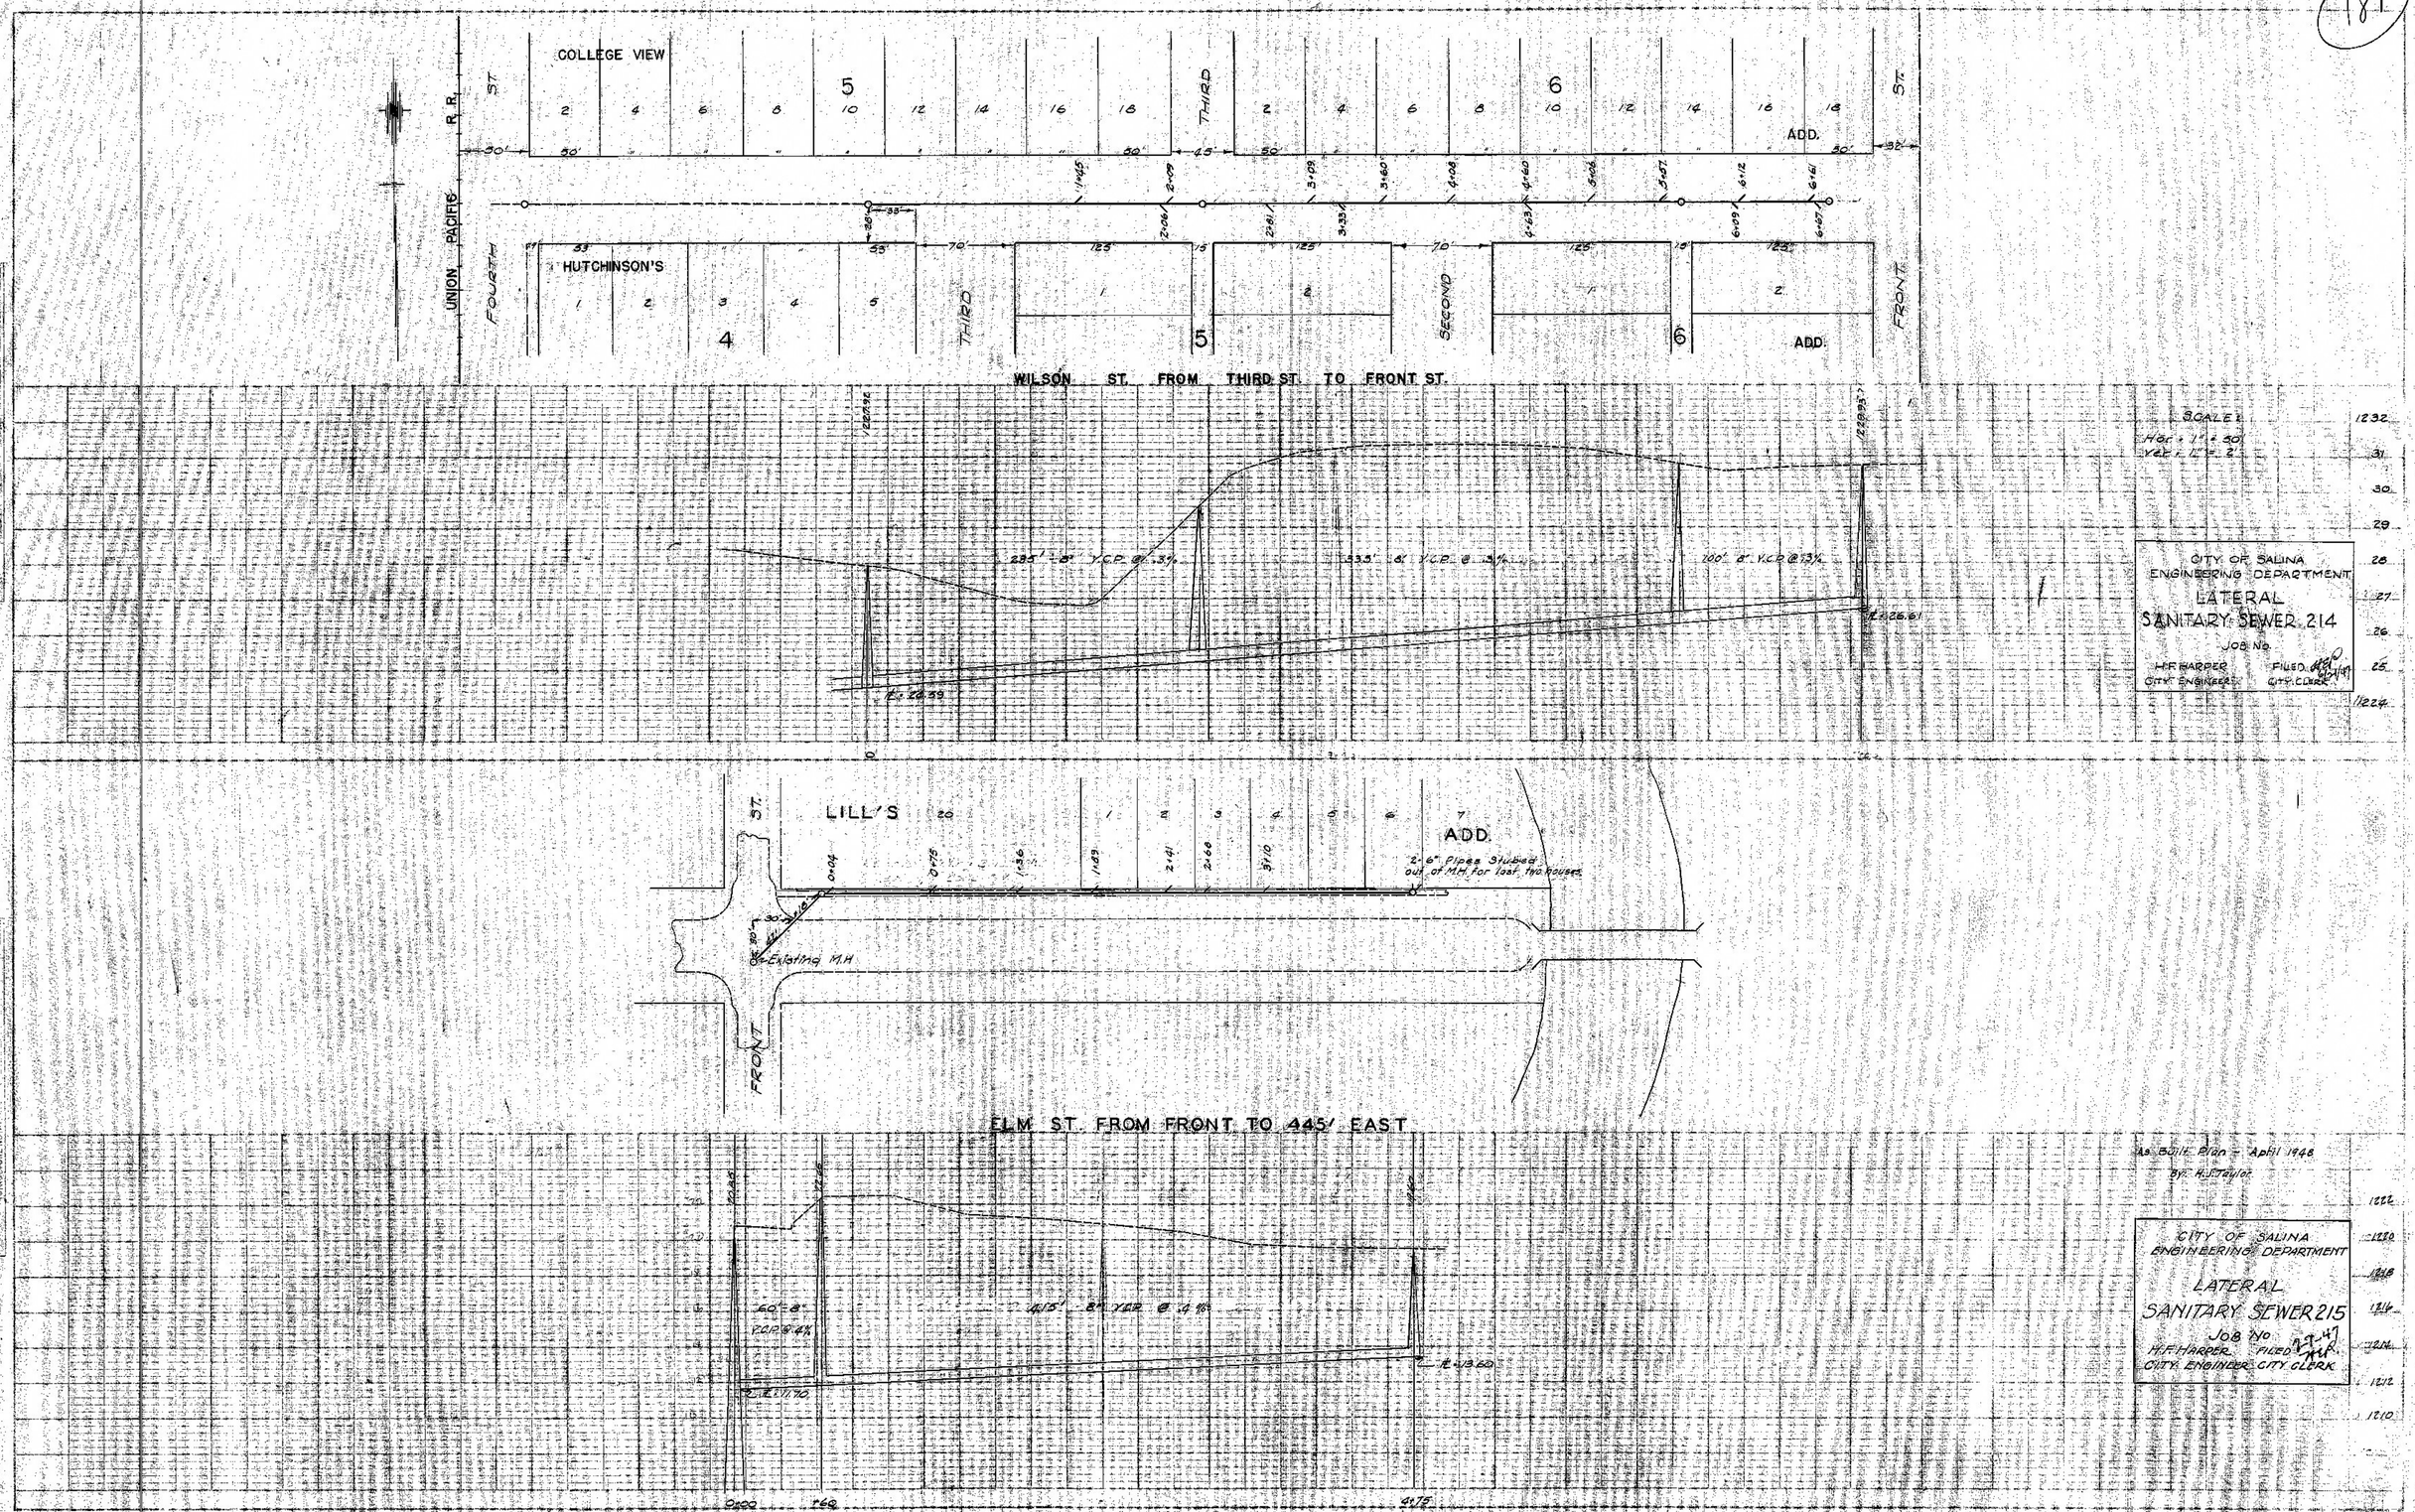
COLLEGE VIEW
ADD.
HUTCHINSON'S
ADD.
UNION PACIFIC R.R.
FOURTH ST.
THIRD ST.
SECOND ST.
FRONT ST.
WILSON ST. FROM THIRD ST. TO FRONT ST.
SCALE:
HOR. 1" = 50'
VERT. 1" = 2'
CITY OF SALINA
ENGINEERING DEPARTMENT
LATERAL
SANITARY SEWER 214
JOB No.
H.F. HARPER
CITY ENGINEER
FILED
CITY CLERK
LILL'S
ADD.
2-6" Pipes Stubbed out of M.H. for last two houses
Existing M.H.
FRONT ST.
ELM ST. FROM FRONT TO 445' EAST
As Built Plan - April 1948
By: H. J. Taylor
CITY OF SALINA
ENGINEERING DEPARTMENT
LATERAL
SANITARY SEWER 215
JOB No.
H.F. HARPER
CITY ENGINEER
FILED
CITY CLERK
PLAN
PROFILE