GG-125

191

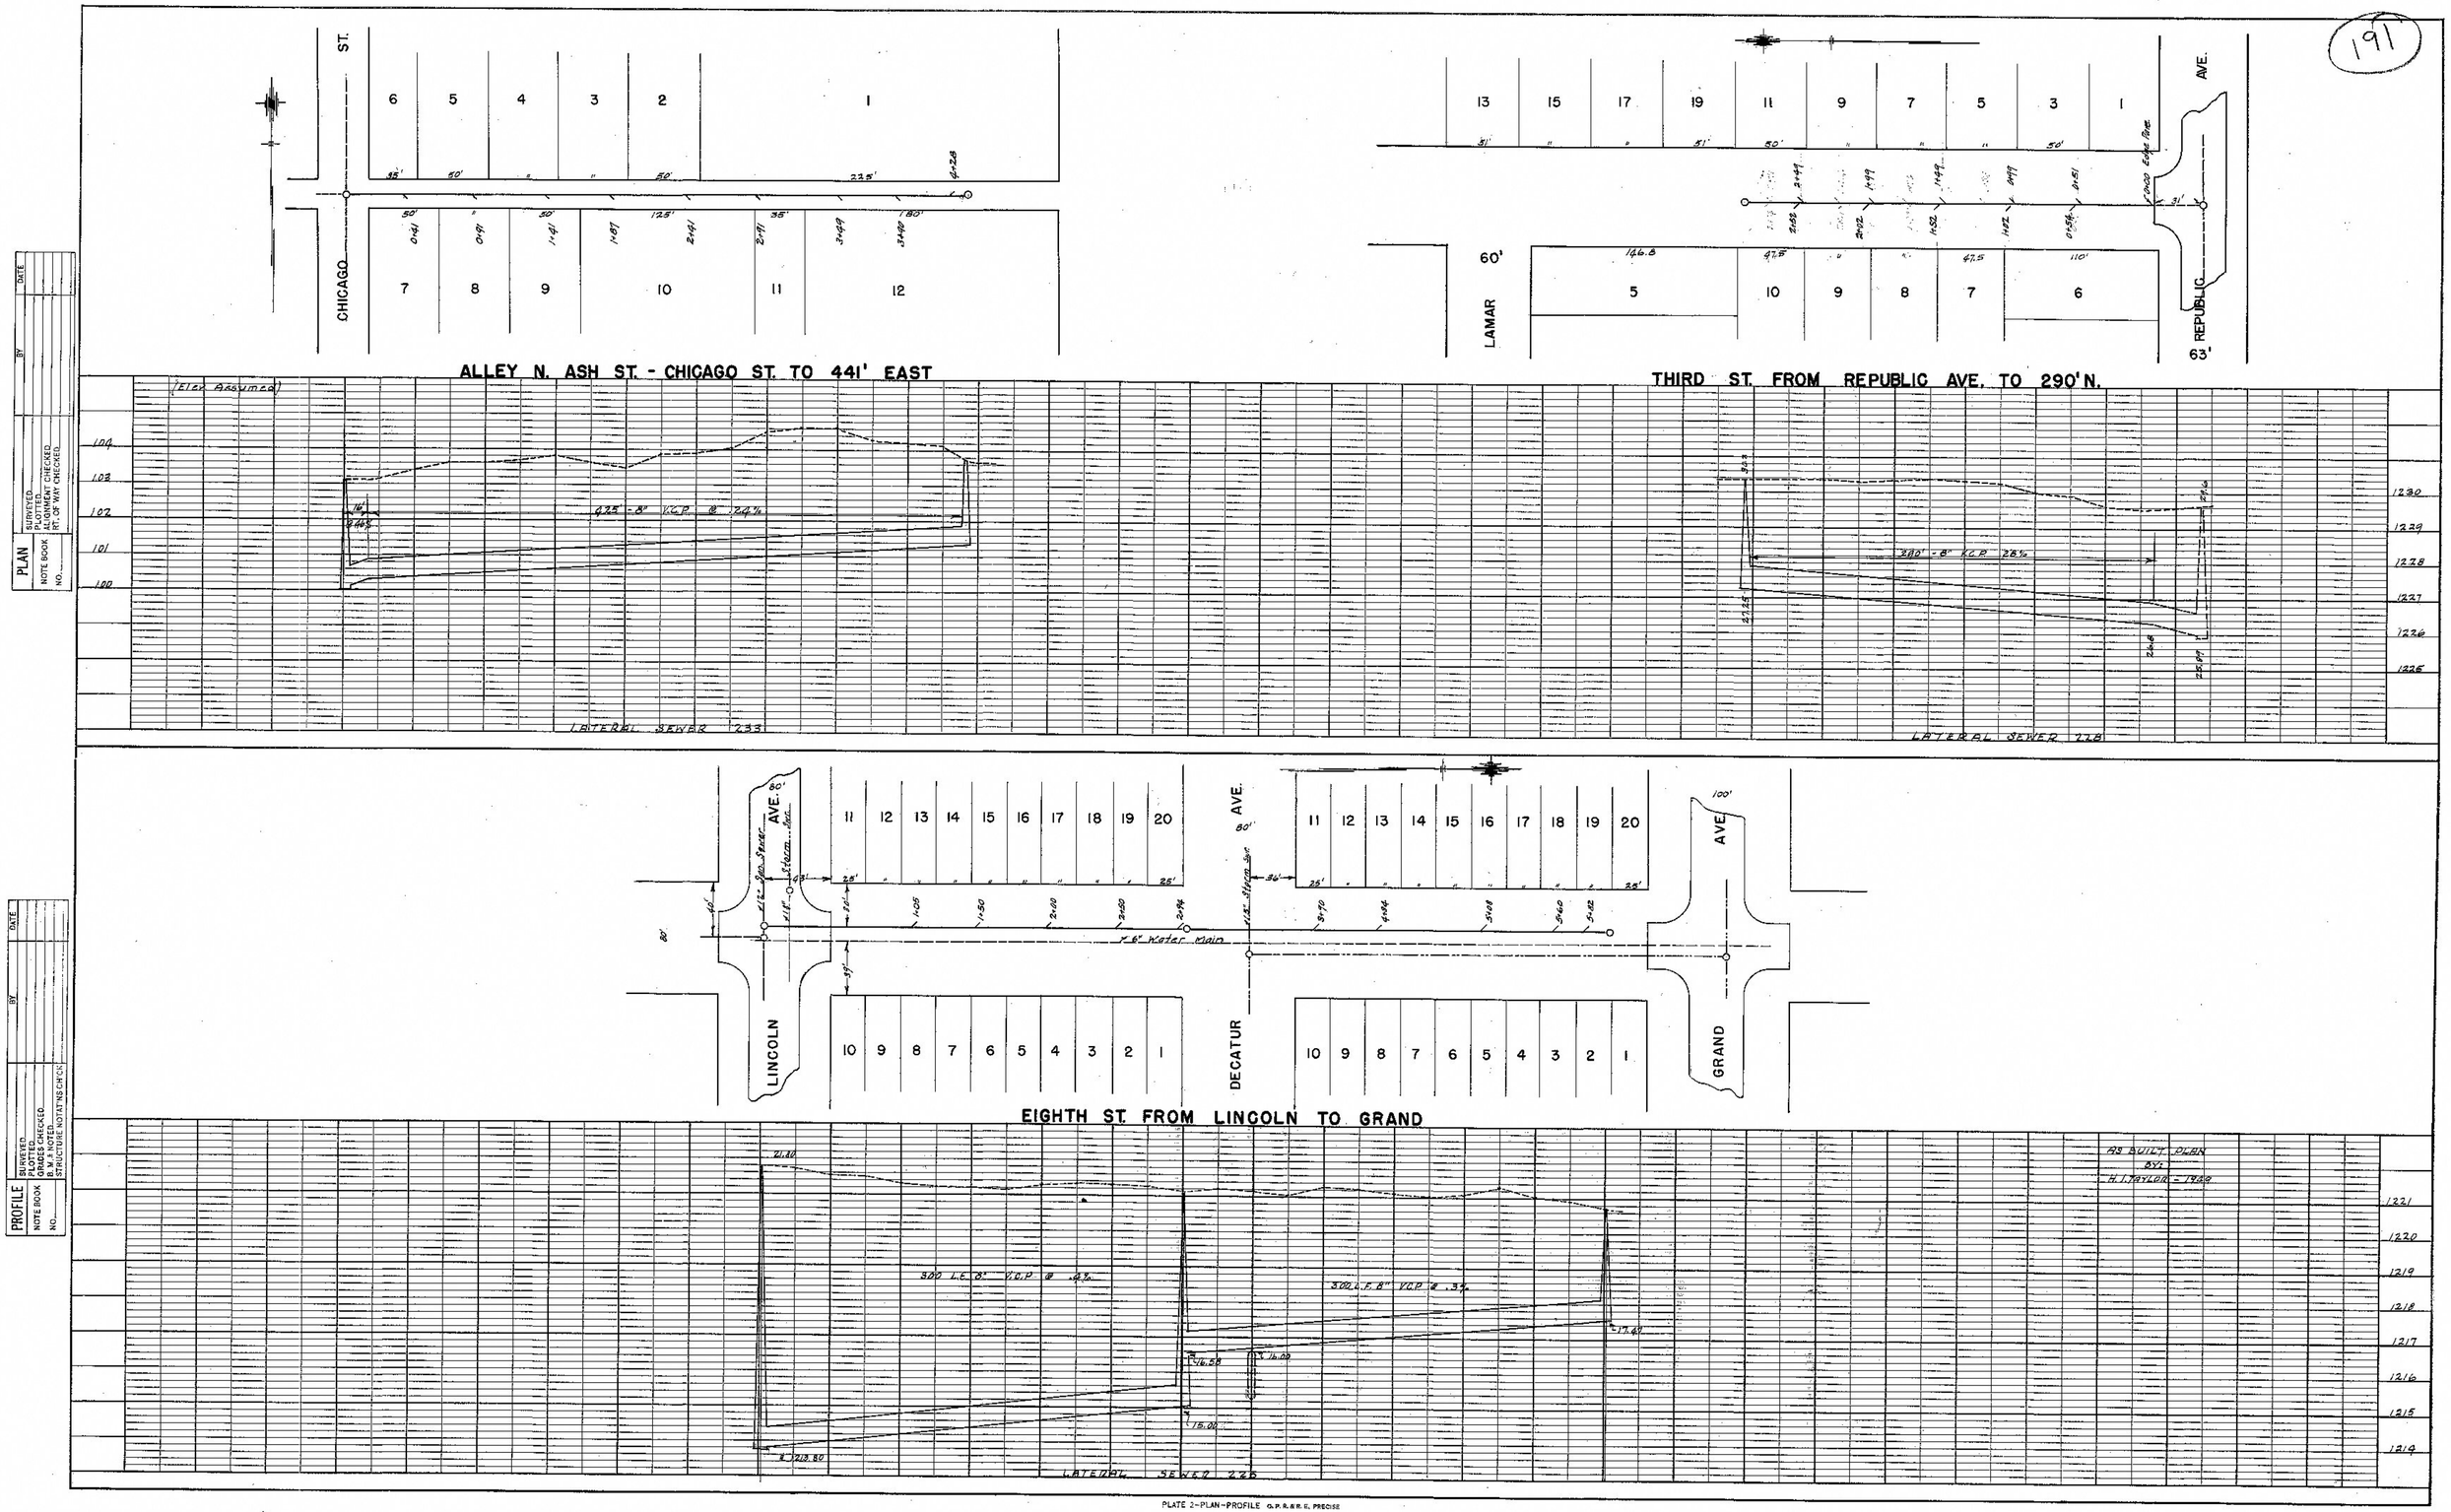

PLATE 2-PLAN-PROFILE G.P.R.&R.E. PRECISE

CHARLES BRUNING COMPANY, INC.