1457 44 137

200

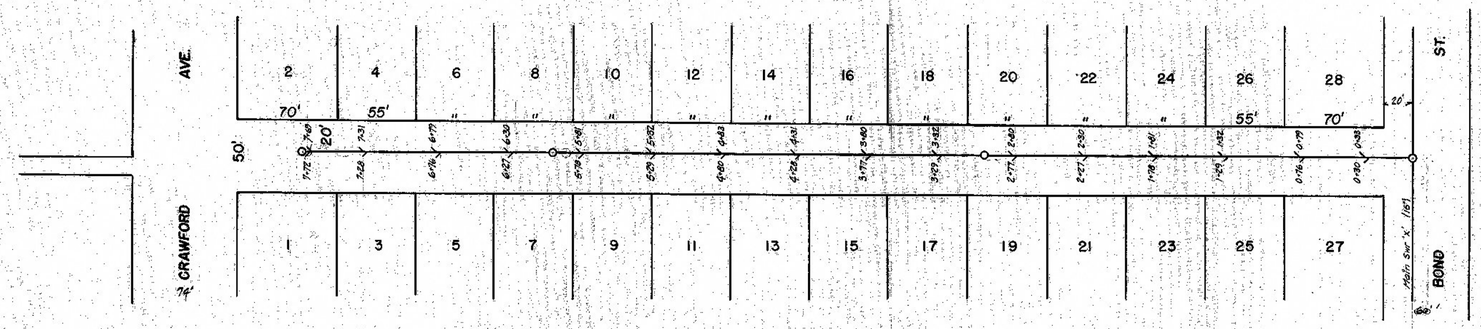

WOOD AVE. — BOND TO CRAWFORD

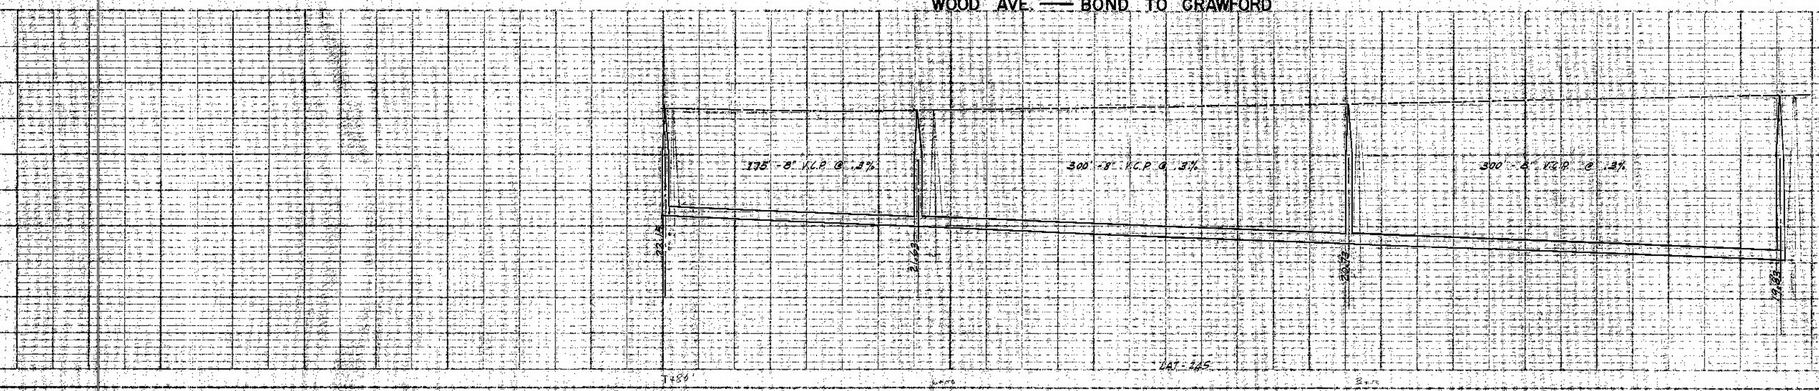

"AS BUILT PLAN"
Constructed - Dec. 1949
by:
H.V. Taylor Const'n Co.
Salina, Kansas

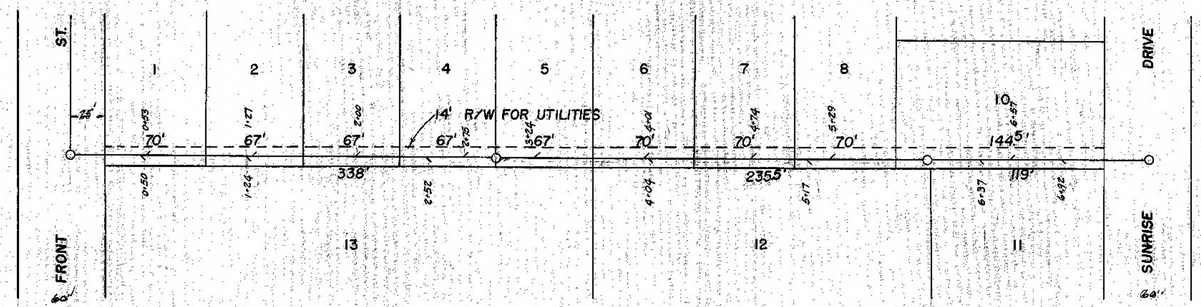

R/W NORTH REPUBLIC AVE. — FRONT TO SUNRISE

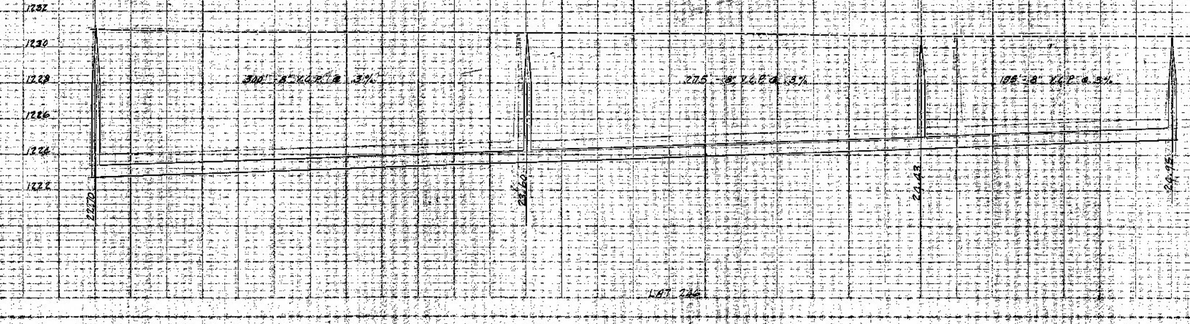

PLAN
SURVEYED
PLOTTED
ALIGNMENT CHECKED
PLAN CHECKED
NOTE BOOK
NO.
BY
DATE

PROFILE
SURVEYED
PLOTTED
GRADES CHECKED
STRUCTURE NOTATIONS CHECKED
NOTE BOOK
NO.
BY
DATE