202

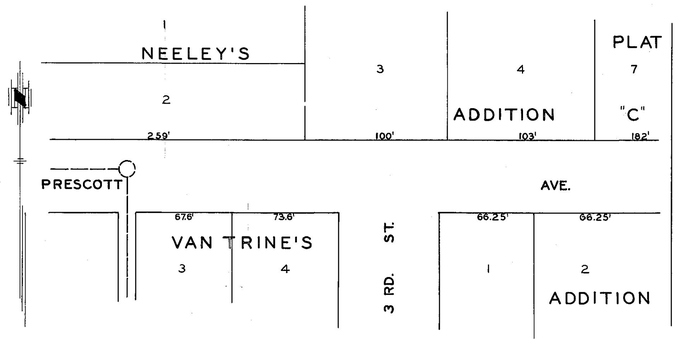

PRESCOTT ST. — ALLEY E. OF 4TH TO 132.5' E. OF 3RD ST. LATERAL 198

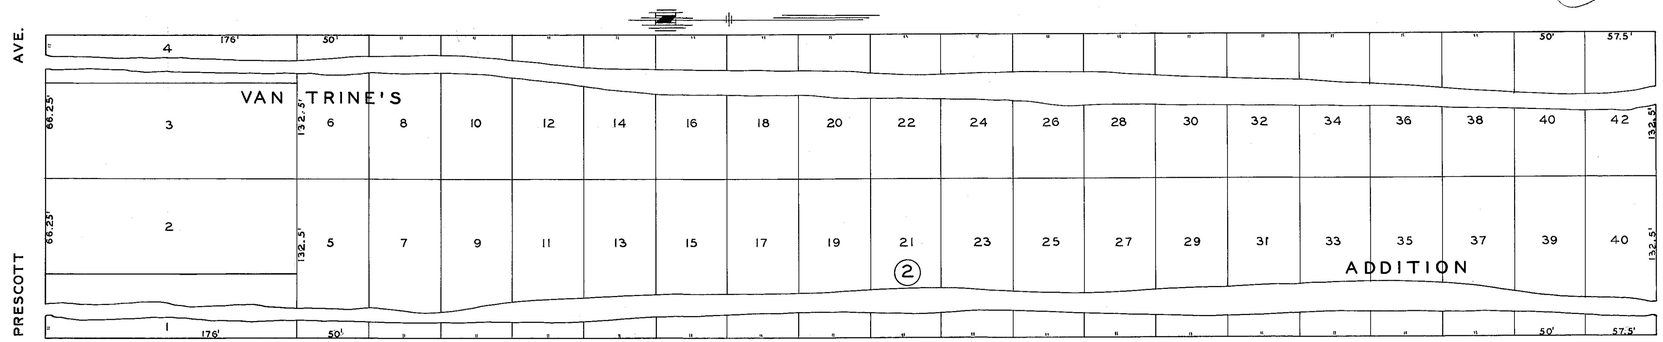

B.M.#413 ELEV. 1228.58 "M" IN MFG. F.H. NE. COR. 4TH ST. & PRESCOTT

132.5' E. OF 3RD. ST. FROM PRESCOTT AVE. TO CRAWFORD AVE. LATERAL 198

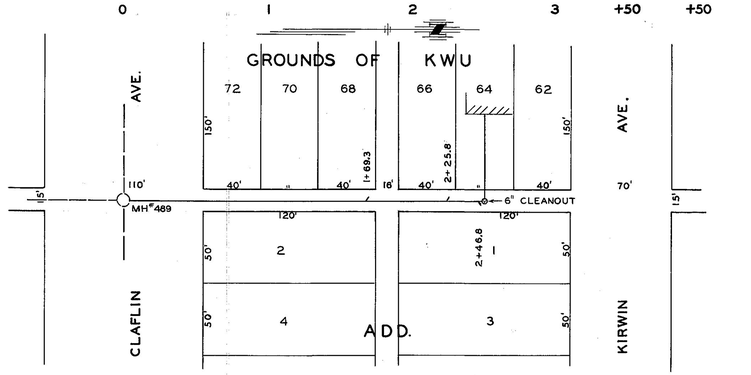

ALLEY E. OF 9TH FROM CLAFLIN TO KIRWIN LAT. 200

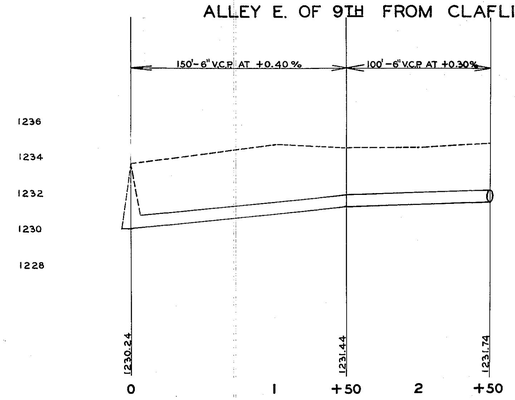

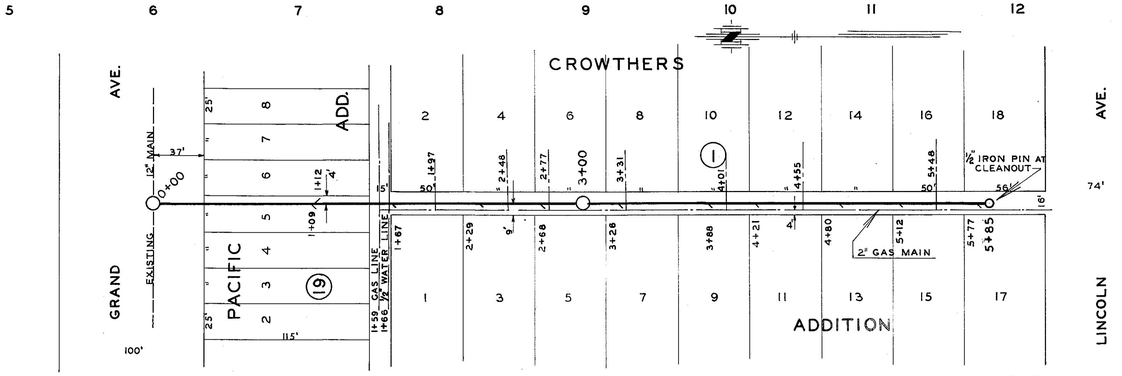

ALLEY E. OF 11TH FROM GRAND TO LINCOLN LATERAL 203

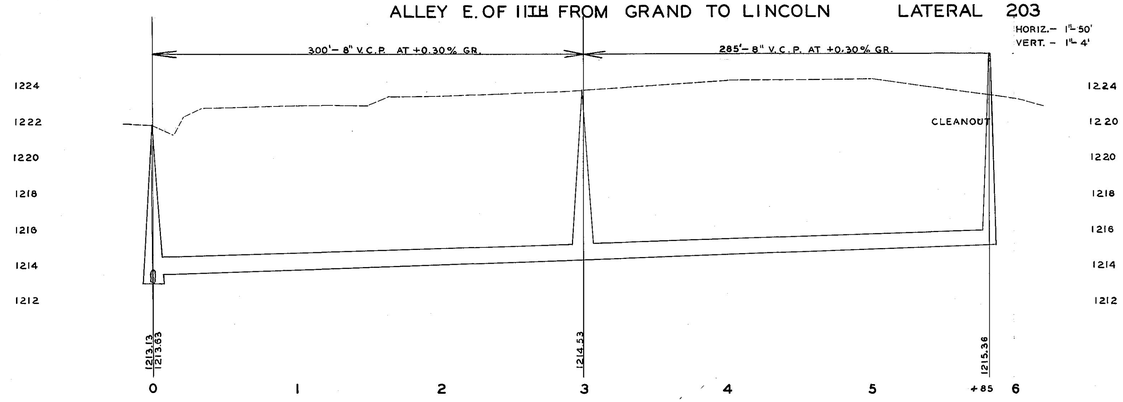

AS CONSTRUCTED AUGUST 1945

CITY OF SALINA
ENGINEERING DEPARTMENT

SANITARY SEWERS

LATERALS
198 — 200 — 203

ORD. NO. 1278 JOB NO. 209

C.C. MACFARLANE
CITY ENGINEER

FILED April 20, 1945
Earl Barker
CITY CLERK