215

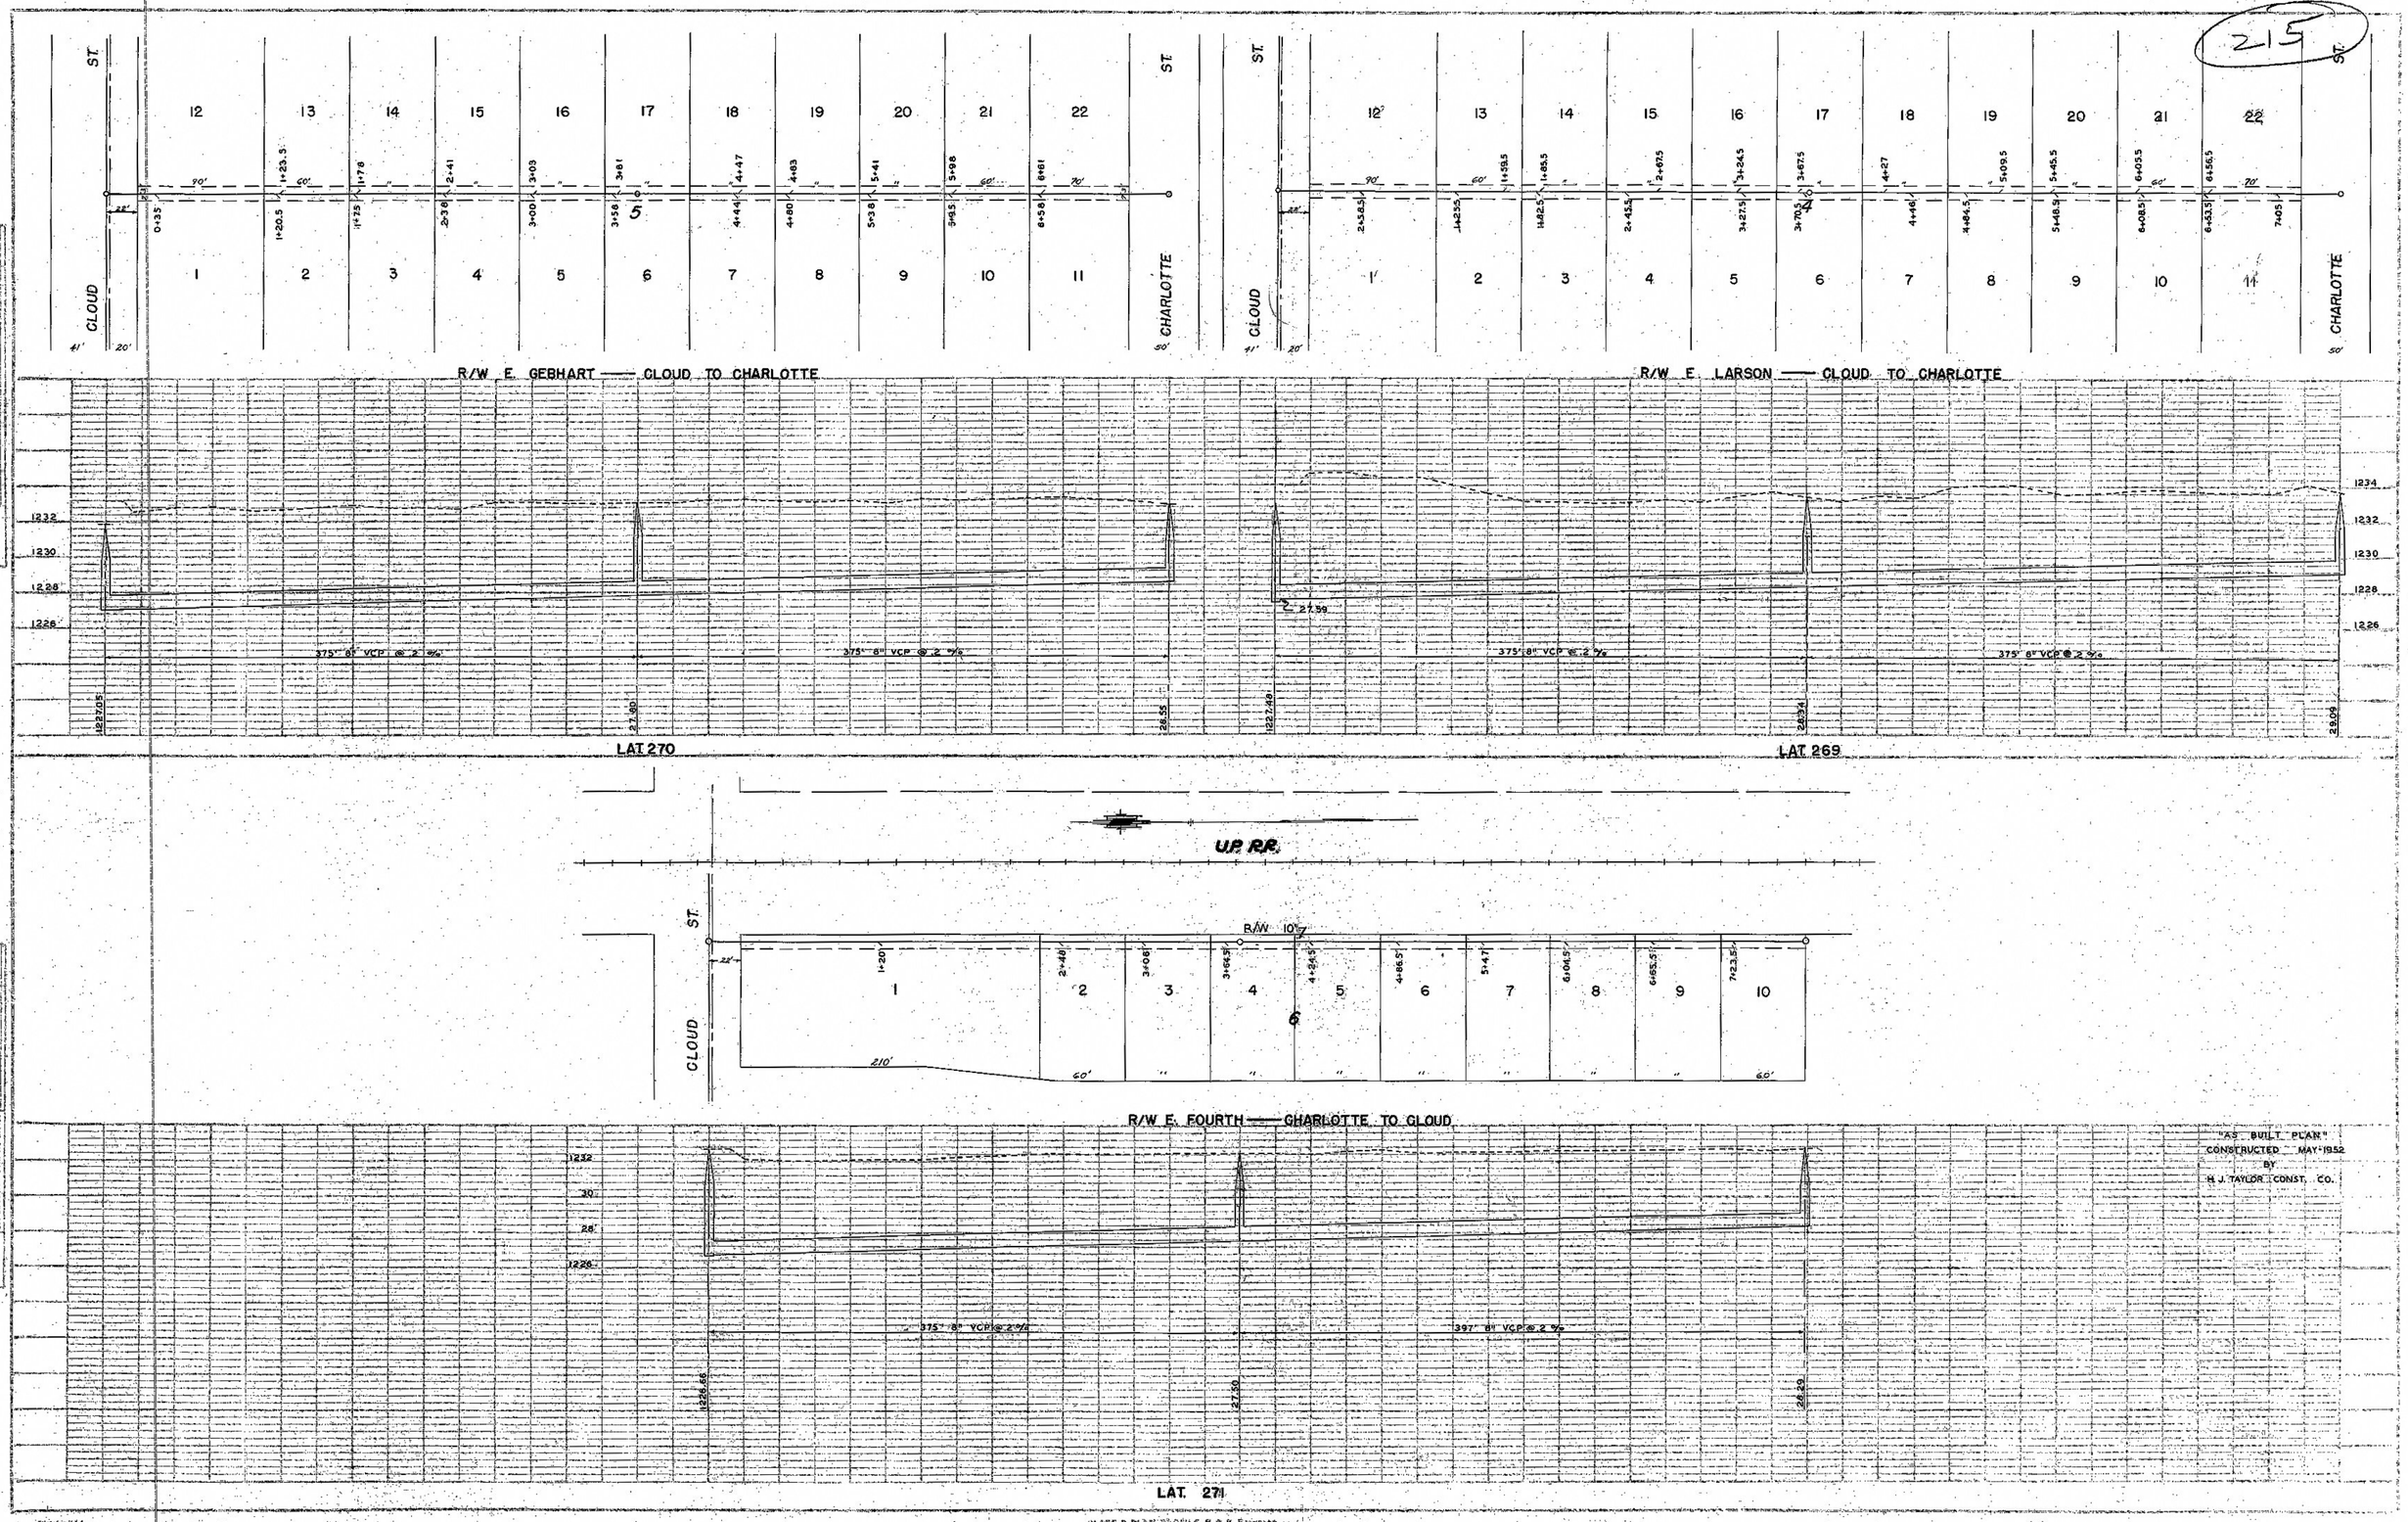
R/W E. GEBHART —— CLOUD TO CHARLOTTE
R/W E. LARSON —— CLOUD TO CHARLOTTE
CLOUD ST.
CHARLOTTE ST.
375' 8" VCP @ 2 %
397' 8" VCP @ 2 %
LAT 270
LAT 269
U.P. R.R.
R/W 10'
R/W E. FOURTH —— CHARLOTTE TO CLOUD
LAT 271
"AS BUILT PLAN"
CONSTRUCTED MAY-1952
BY
H. J. TAYLOR CONST. CO.
PLAN
PROFILE