2-18

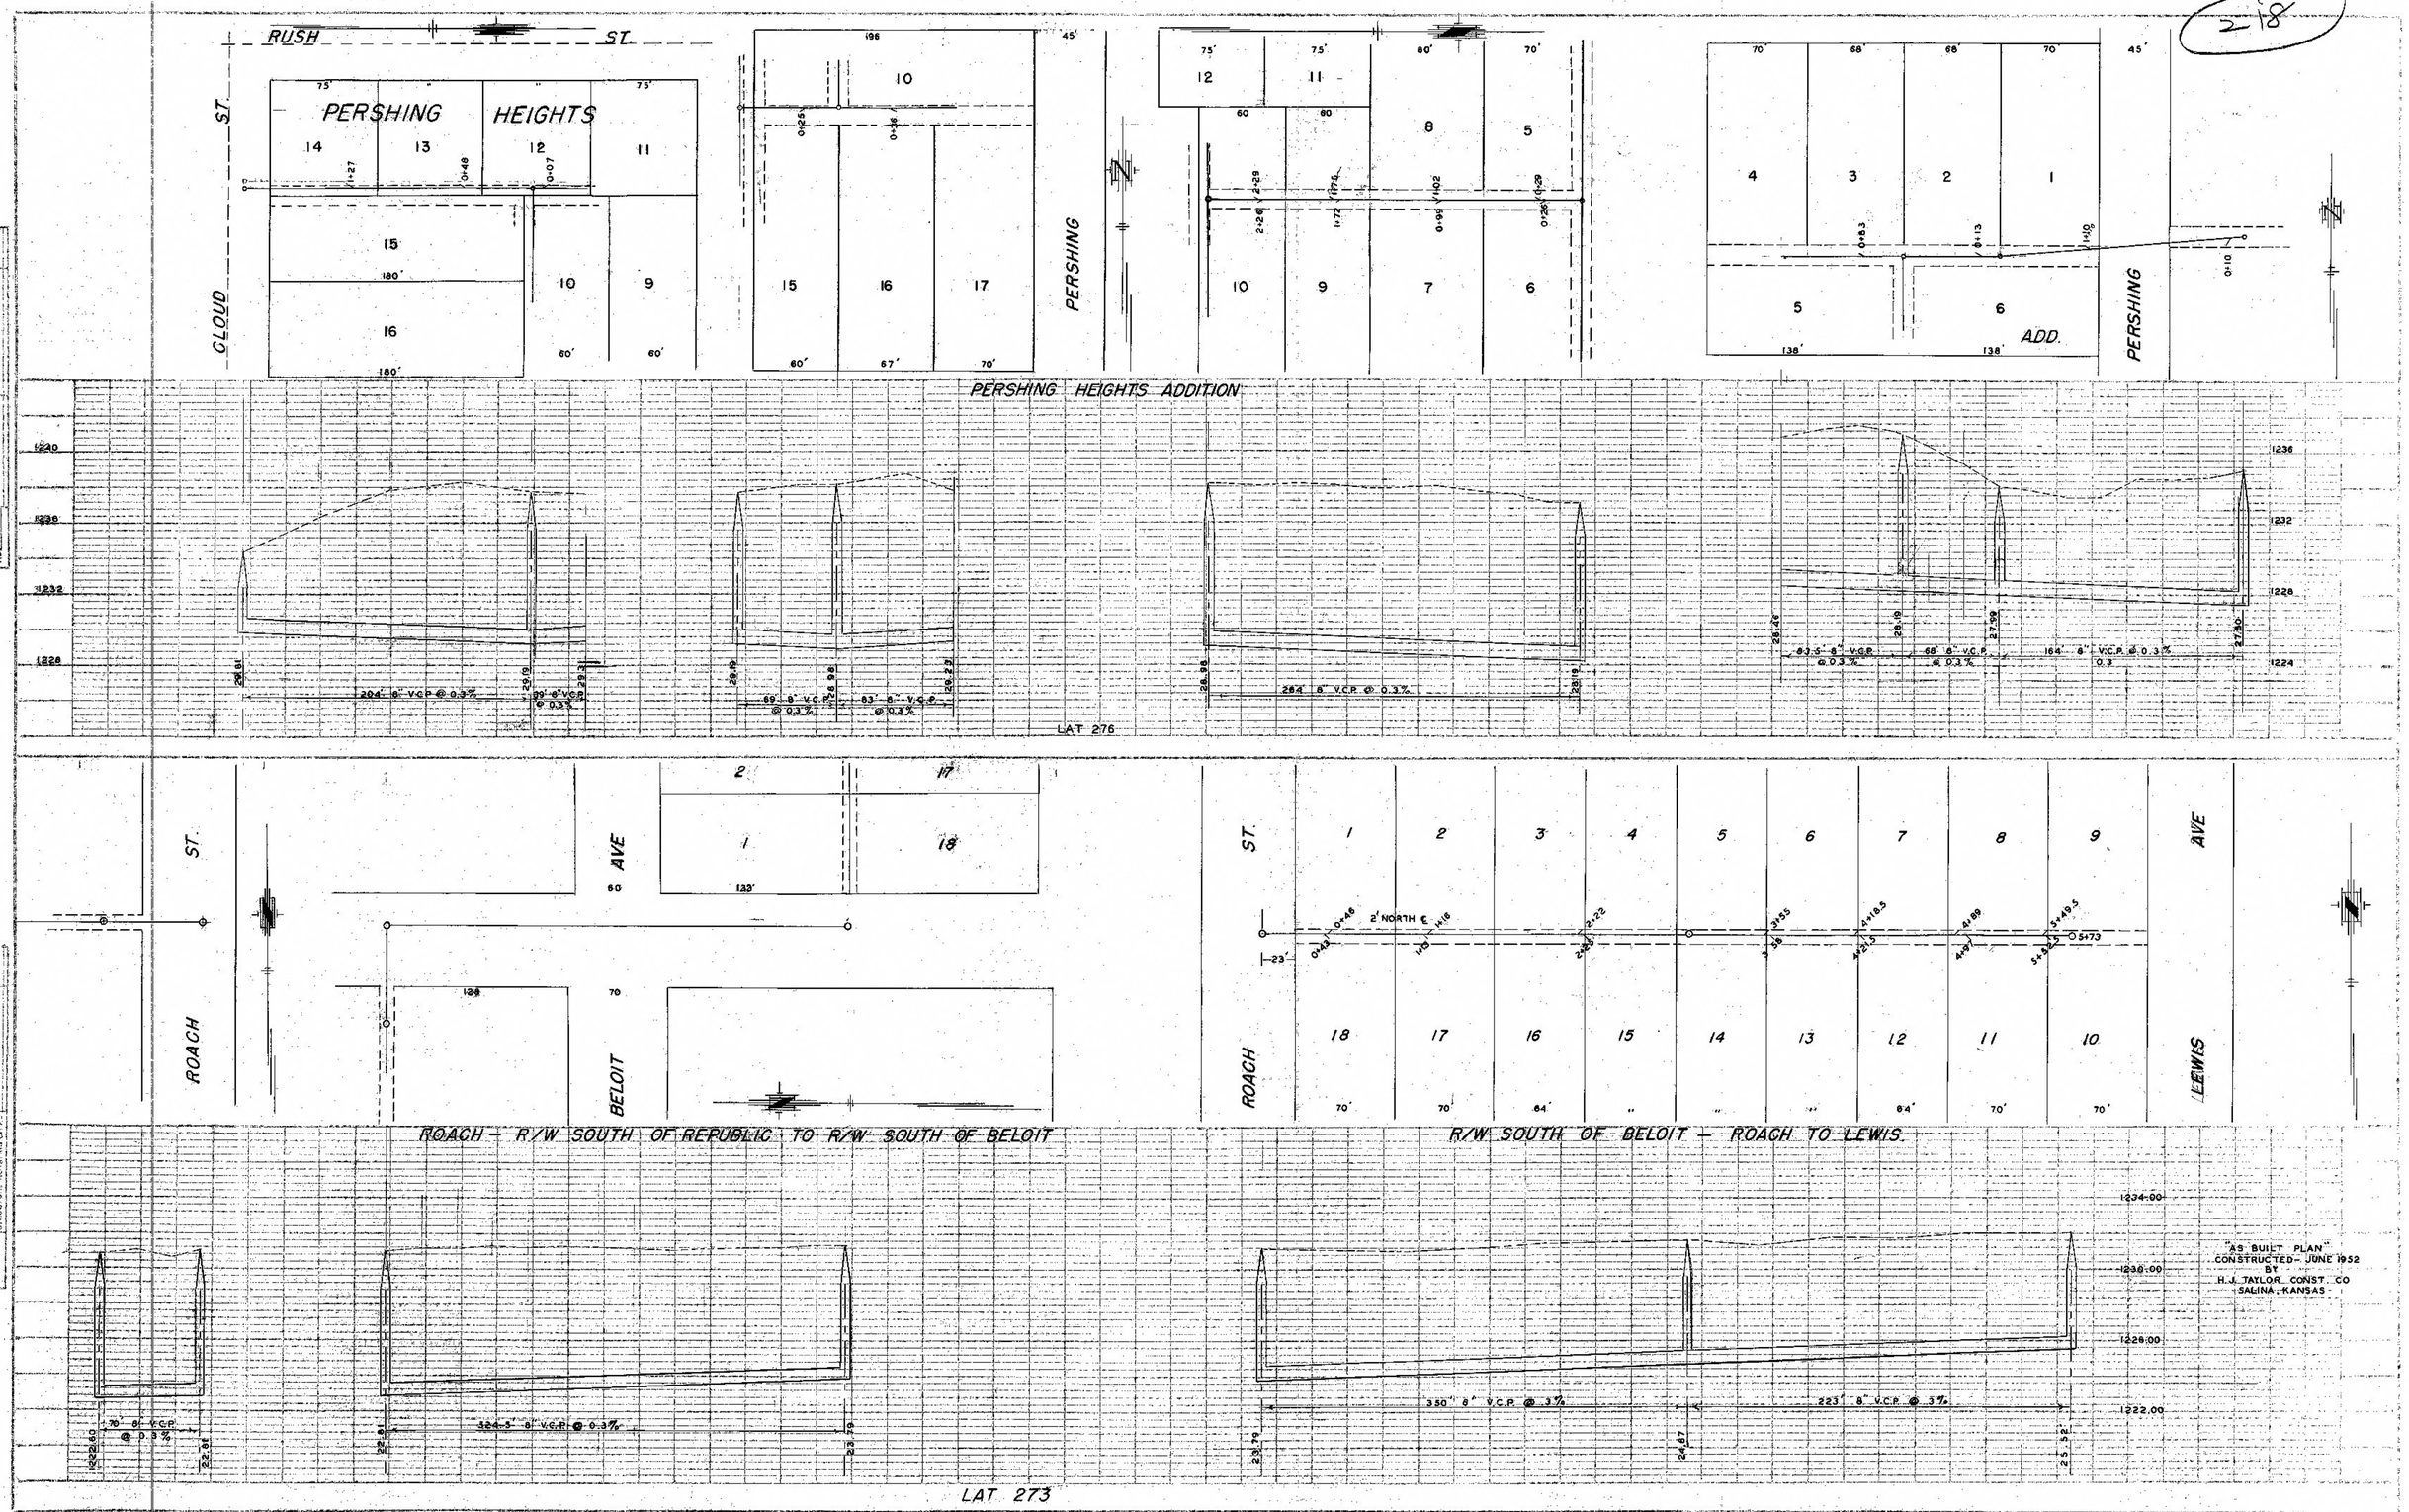

PLAN — SURVEYED, PLOTTED, NOTE BOOK, GRADES CHECKED, BY C.P. WAY CHECKED, NO.

PROFILE — SURVEYED, PLOTTED, NOTE BOOK, GRADES PROPOSED, B.M. NOTE, STRUCTURE NOTATIONS CH'K'D, NO.