



PLAN	DATE
REVISED	
NOTED	
NOTE BOOK	
10	



PROFILE	DATE
REVISED	
NOTED	
NOTE BOOK	
10	

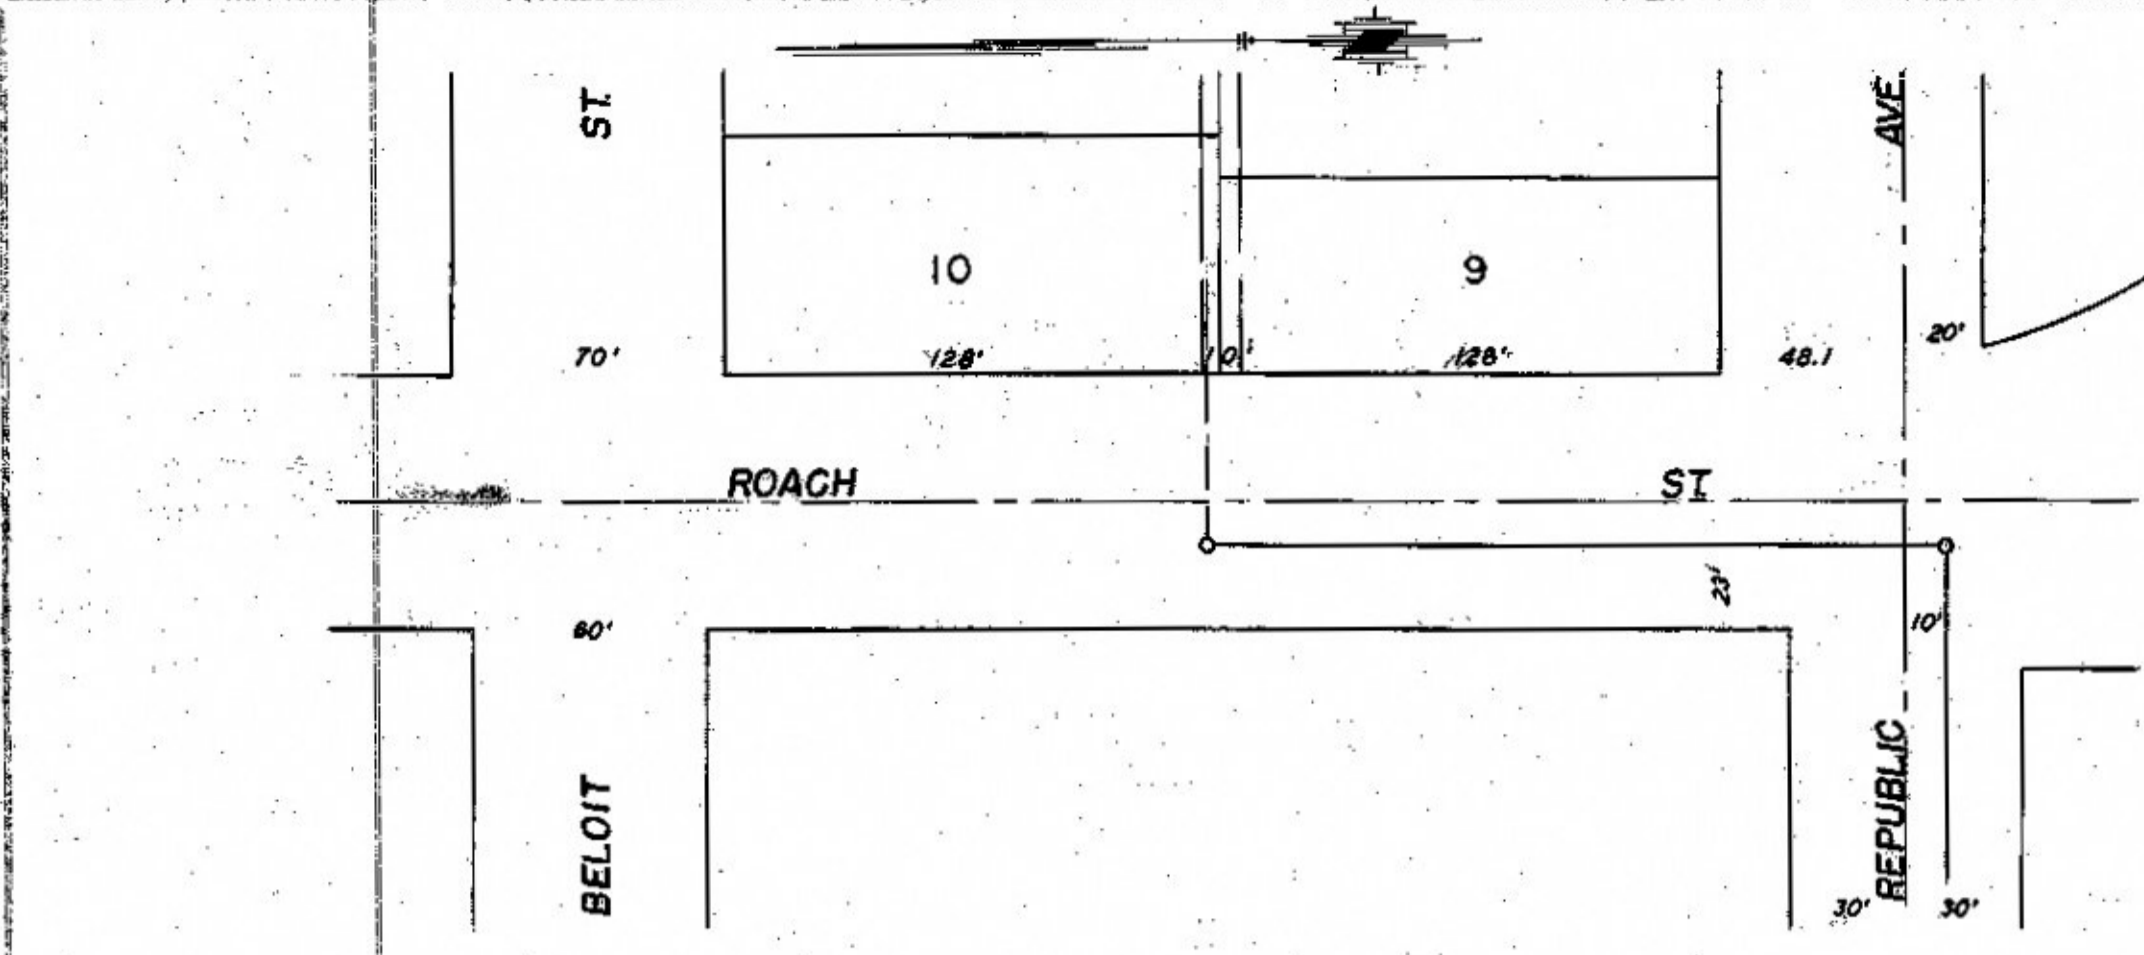


ROACH ST — R/W N. BELOIT TO REPUBLIC

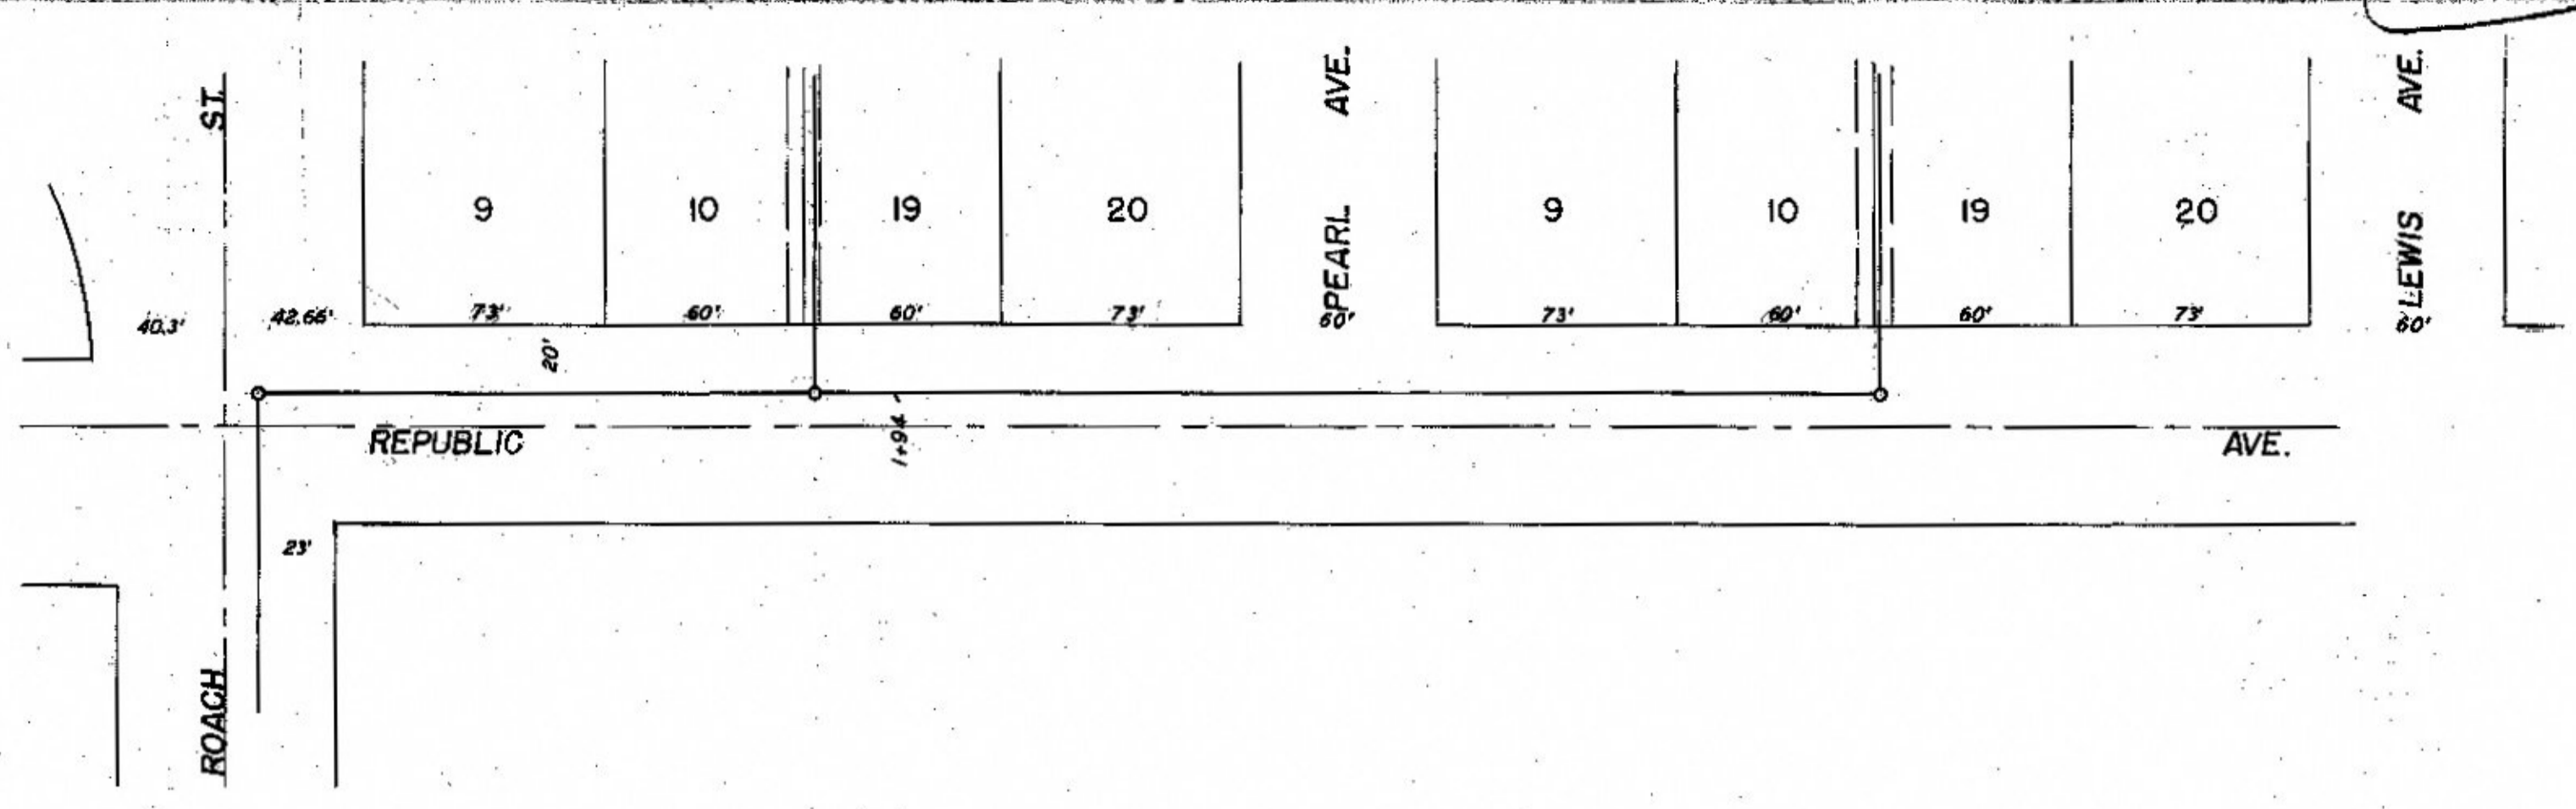


REPUBLIC AVE — ROACH TO R/W E LEWIS

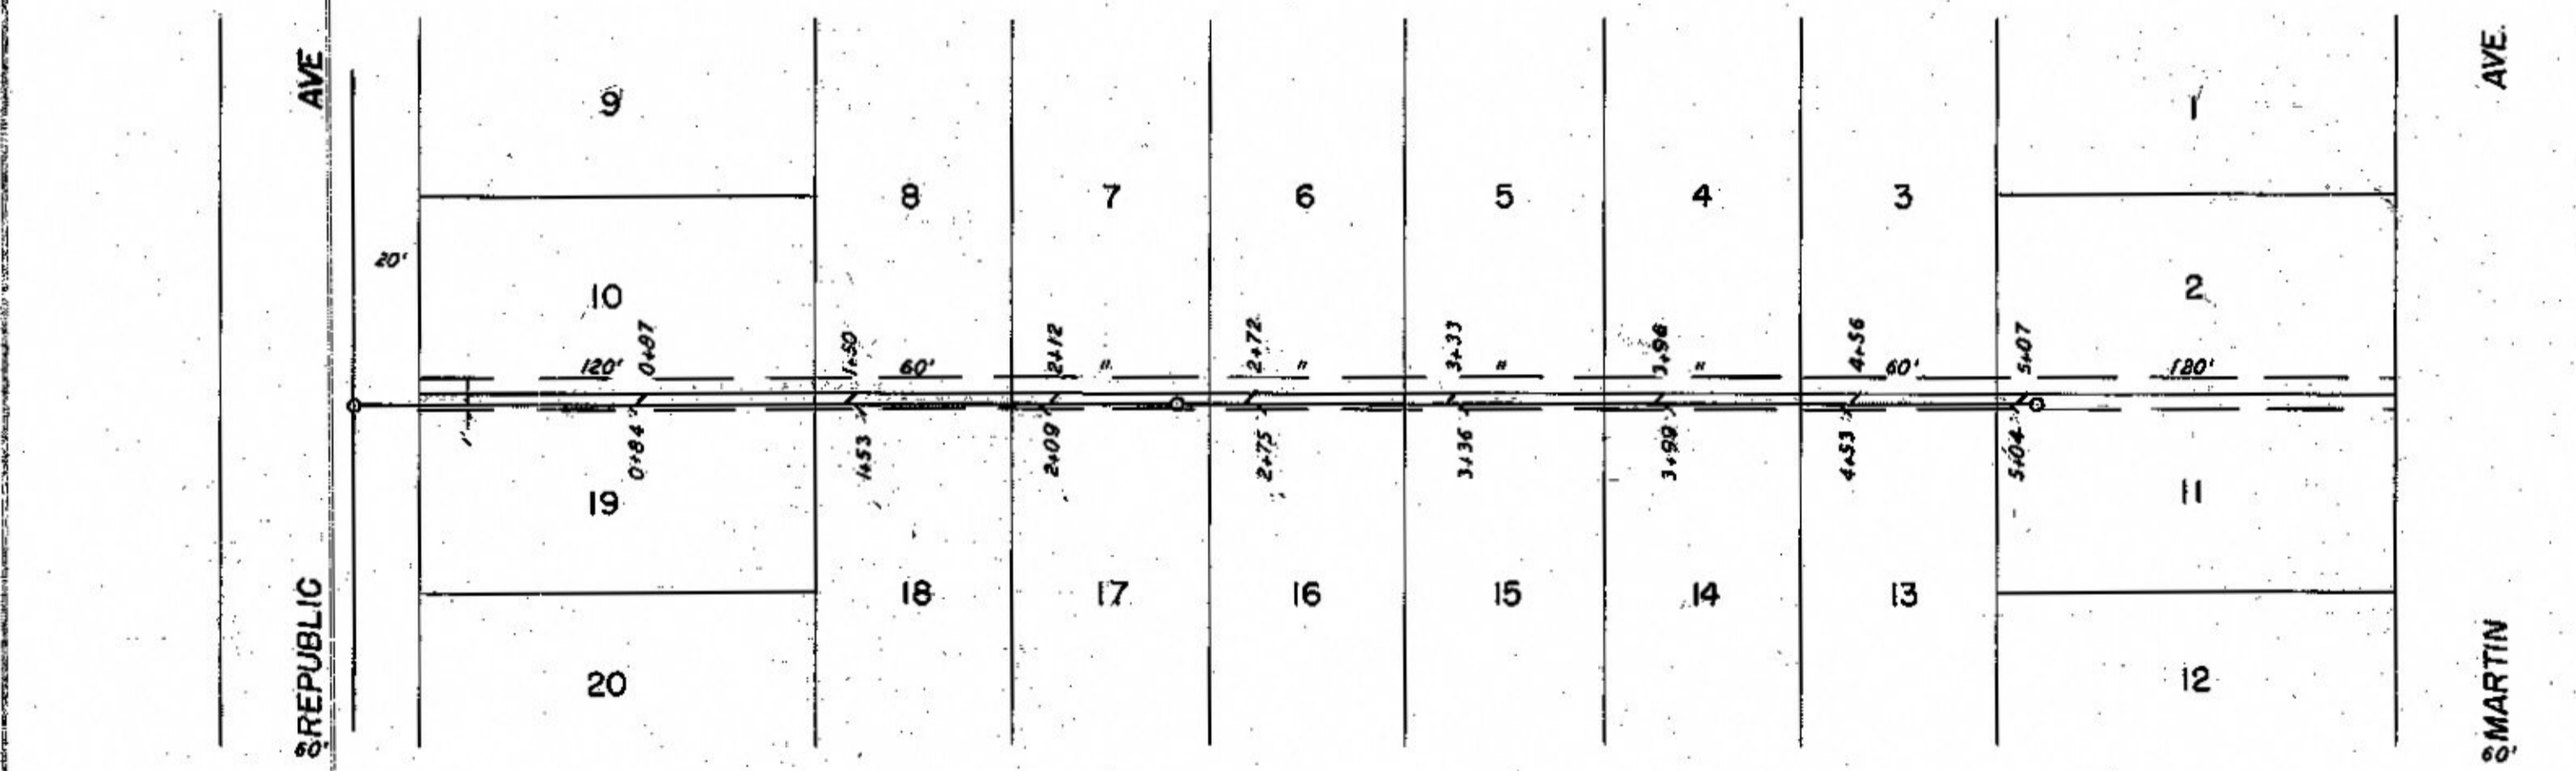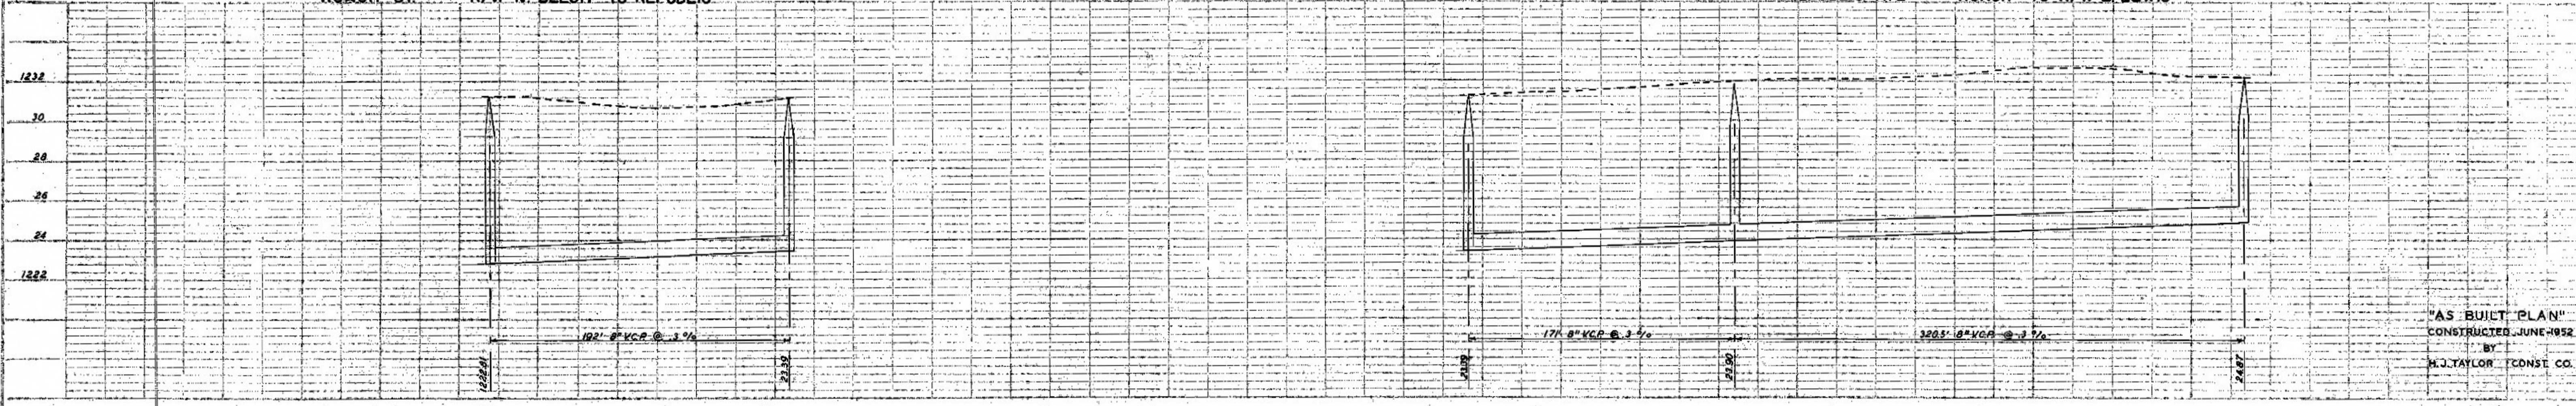

R/W E. ROACH — REPUBLIC TO MARTIN

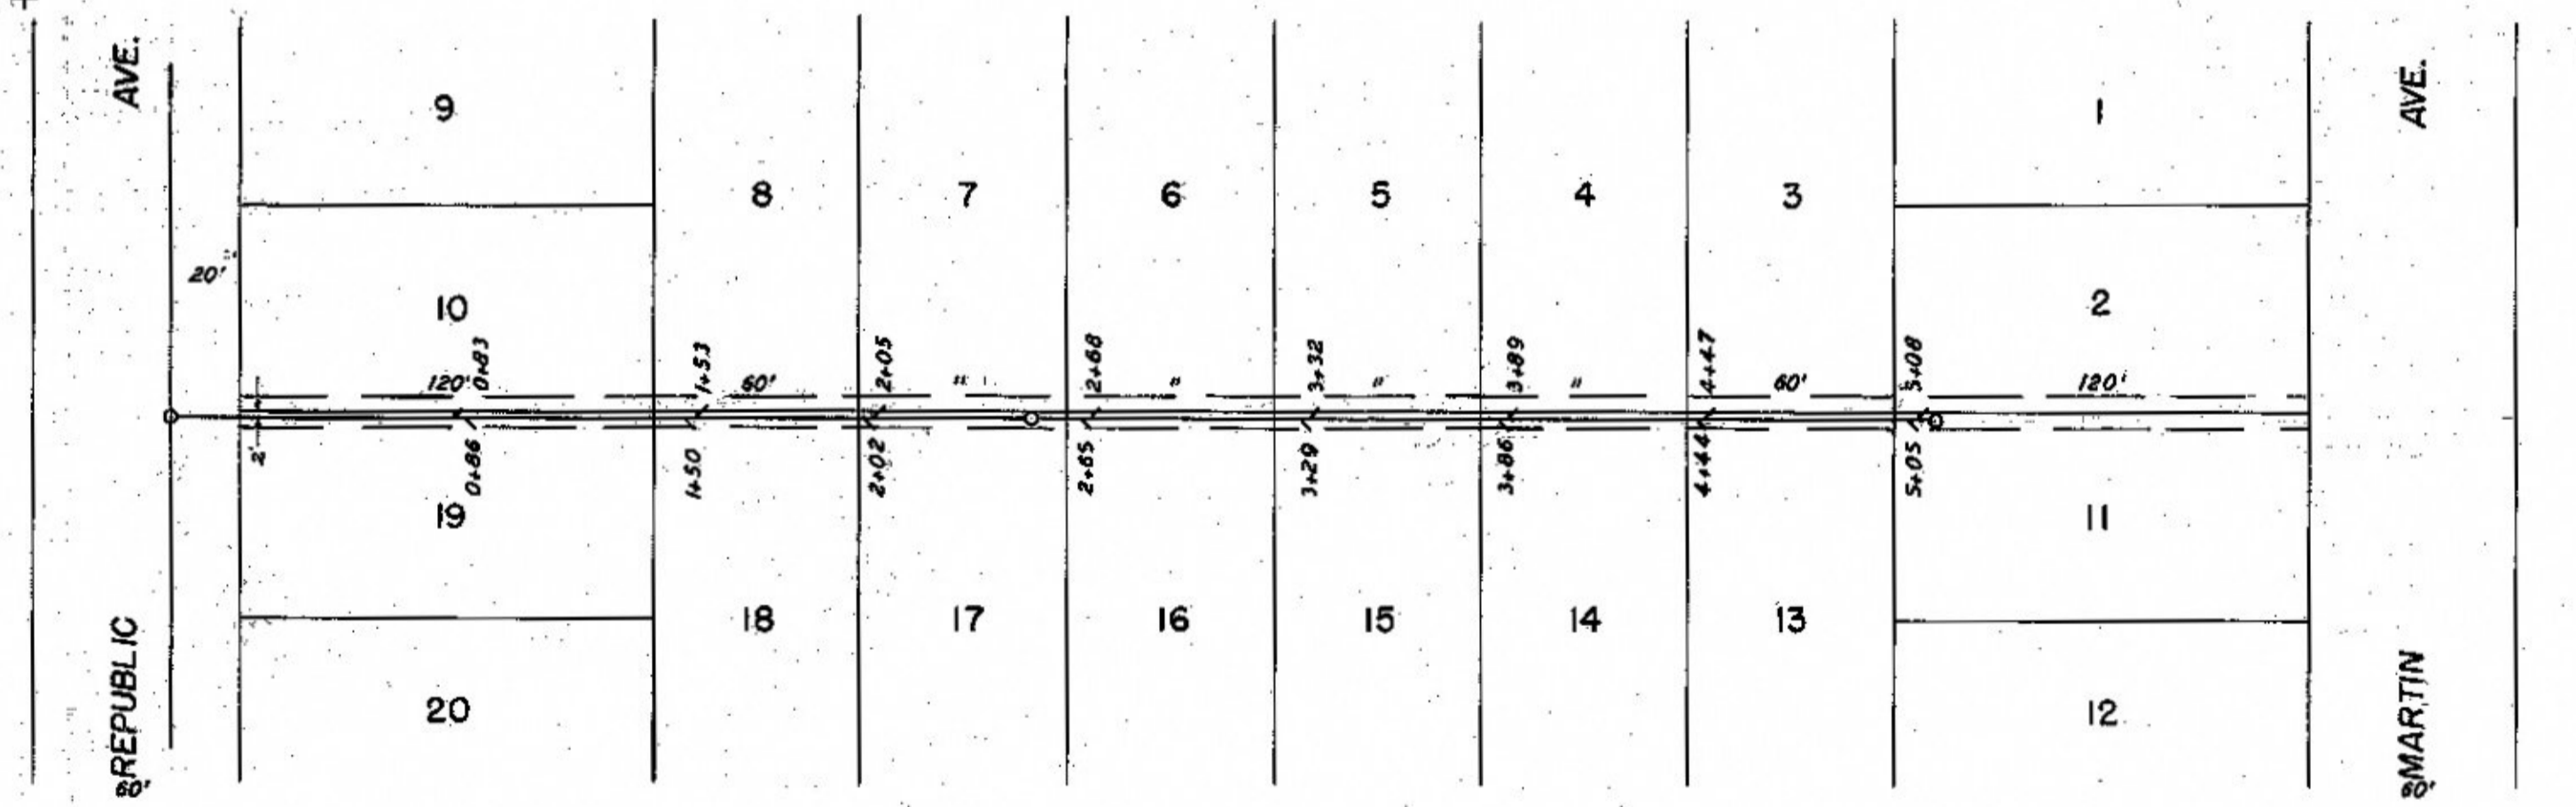

R/W E. PEARL — REPUBLIC TO MARTIN

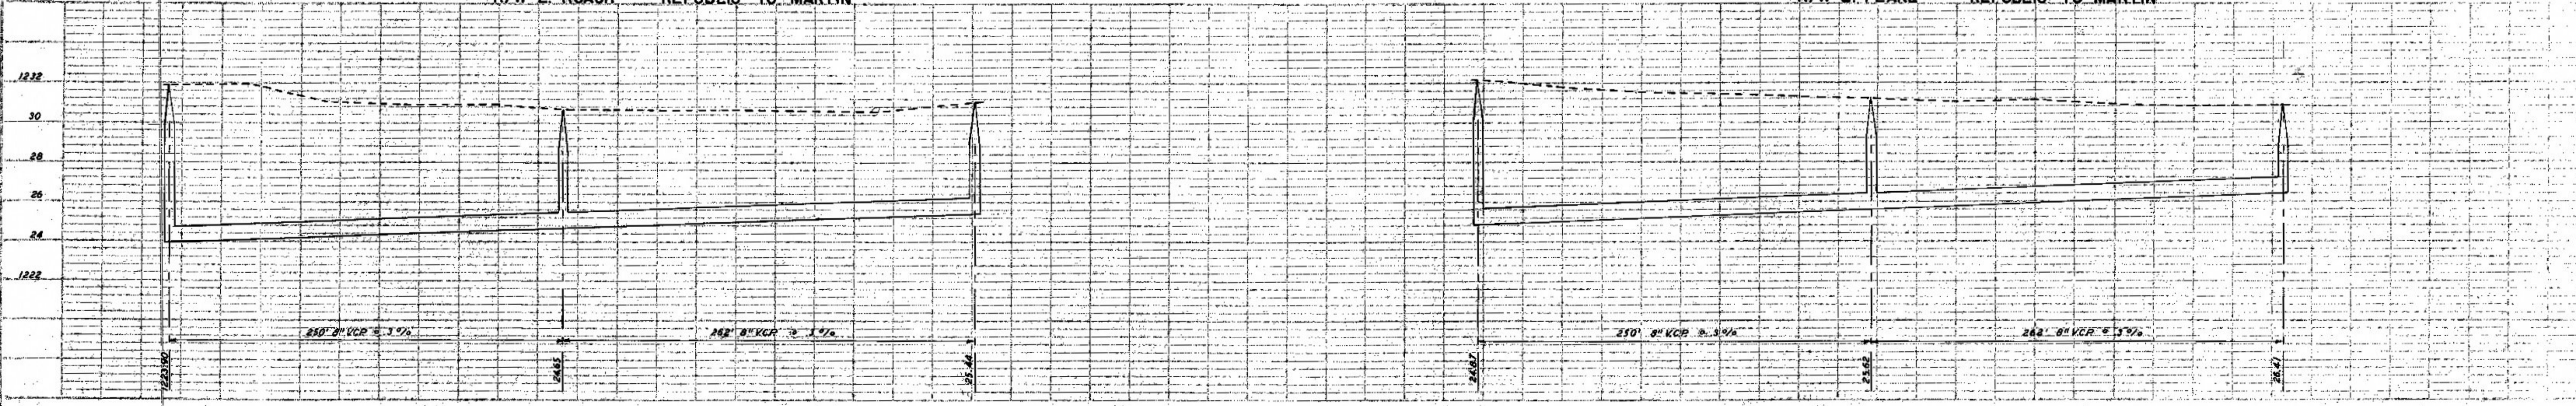

Lat. 27A

Lat. 27S