


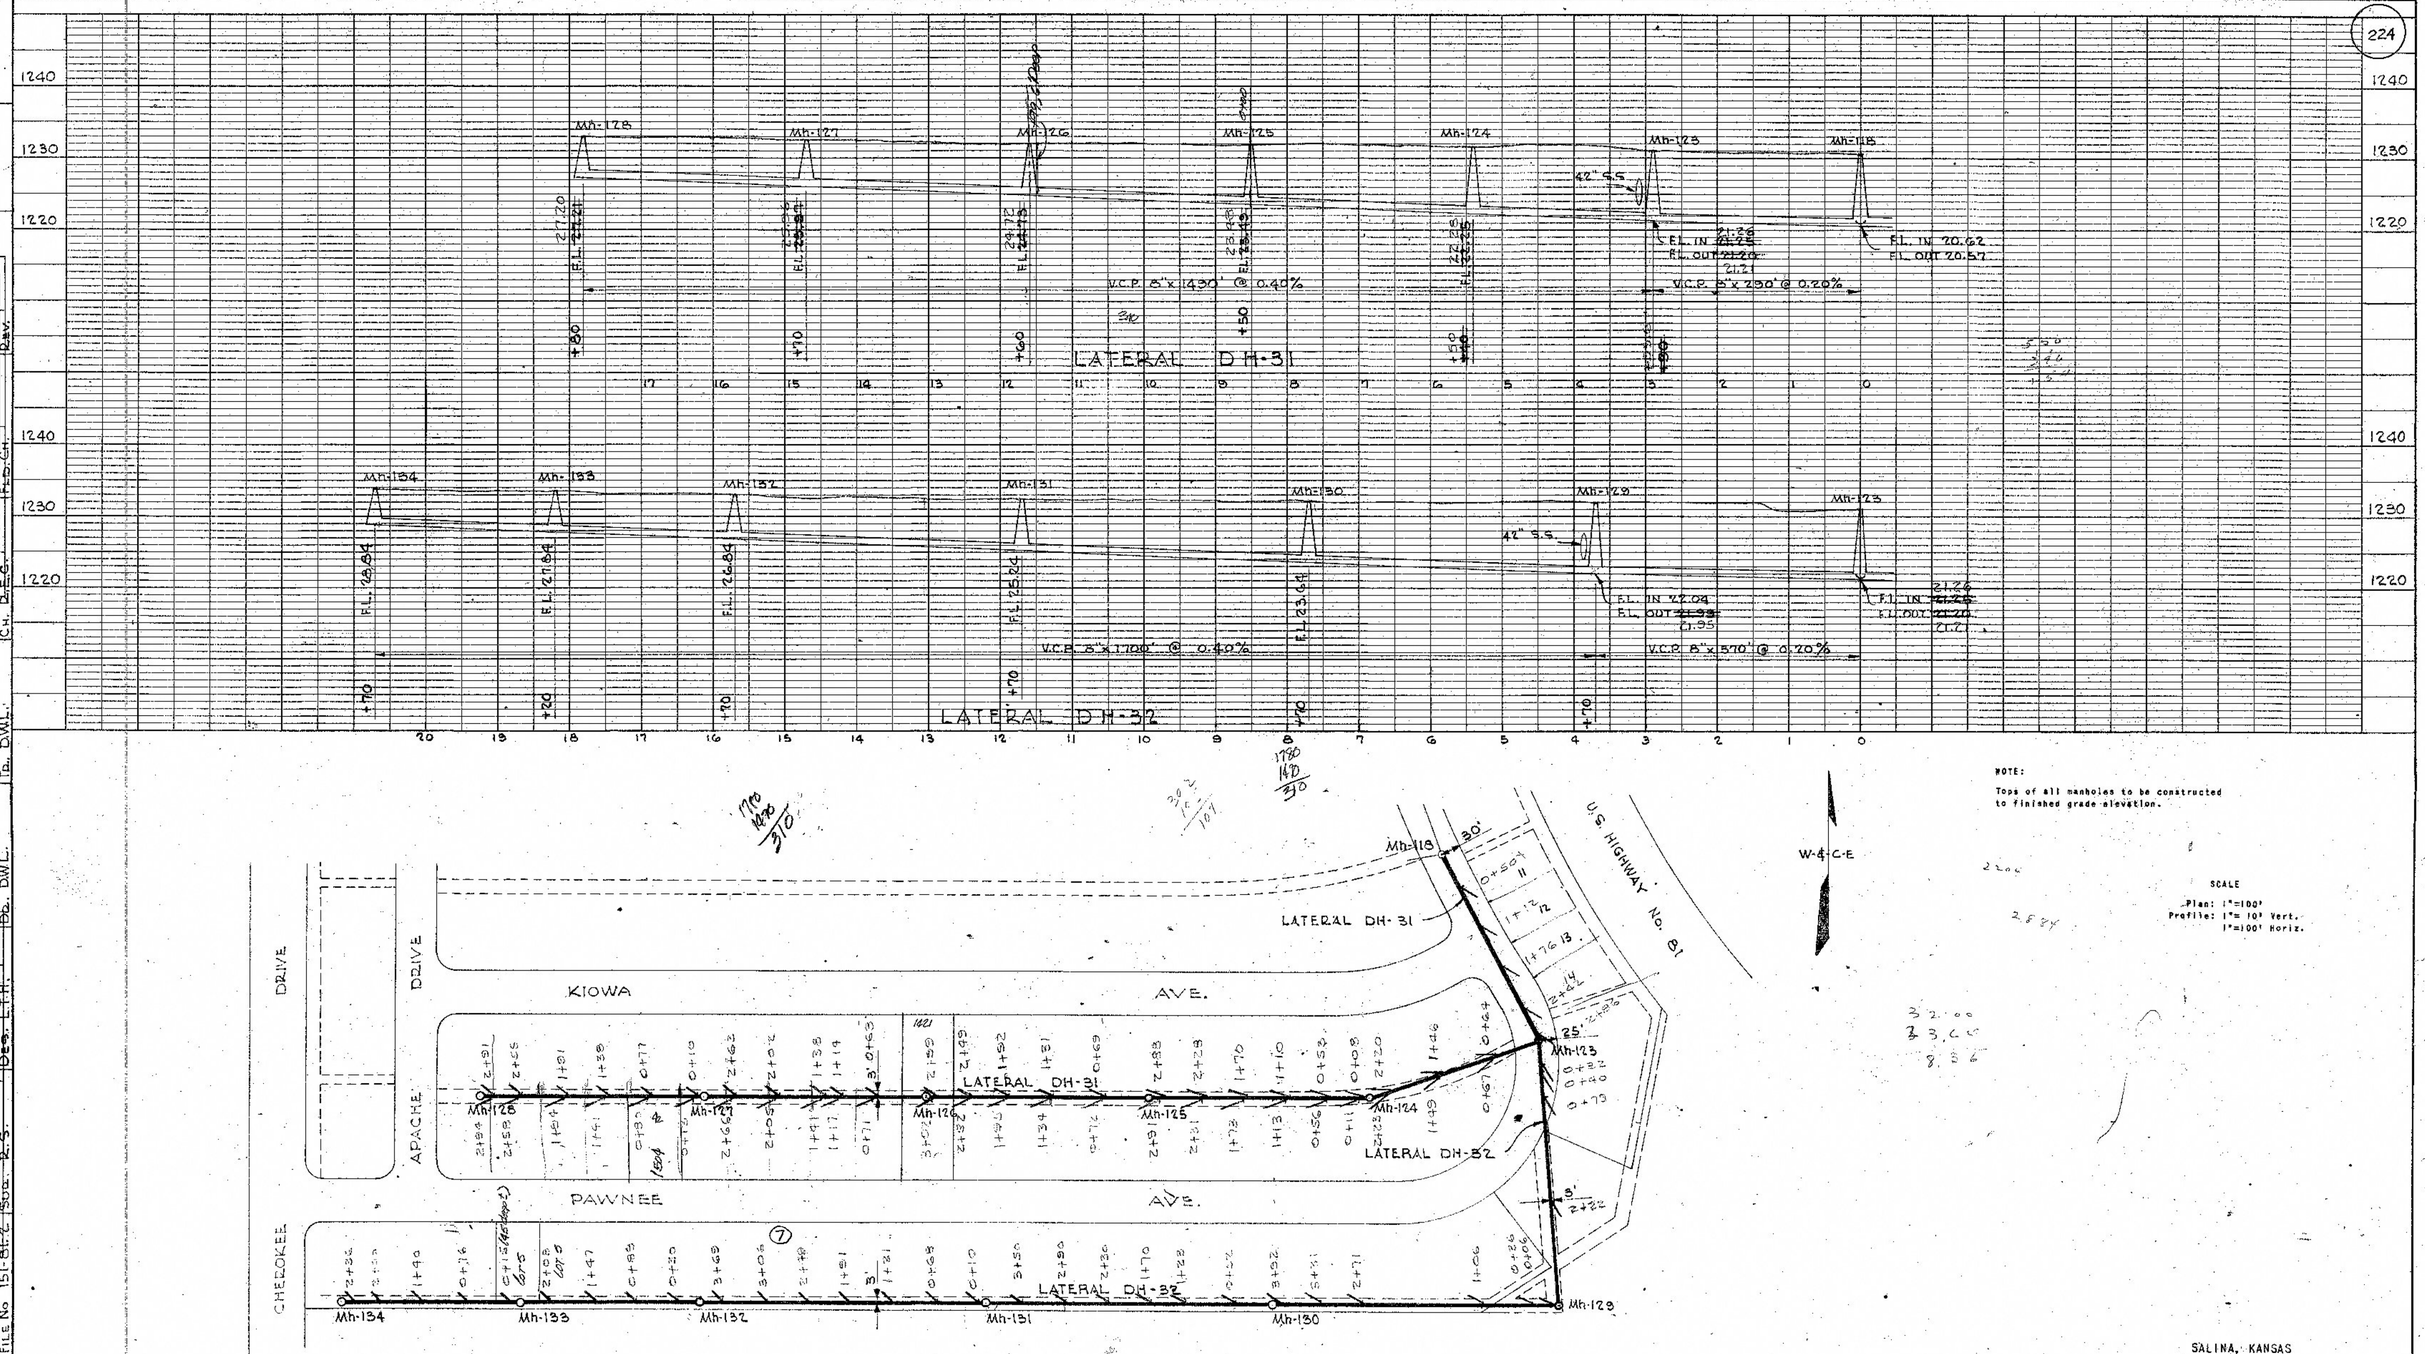


NOTE:

Tops of all manholes to be constructed to finished grade elevation.

SCALE

Plan: 1"=100'
Profile: 1"= 10' Vert.
1"=100' Horiz.

SALINA, KANSAS
SANITARY SEWER EXTENSIONS
LAT DH-31 & DH-32

Scale as Noted

WILSON & COMPANY
- ENGINEERS -
Salina -- Kansas
1952

AS CONSTRUCTED DRAWING
By _____ Date APR 14 1953

11/13

151-81.2

| | | | |
|---|---|---|---|
| No. | REVISIONS | By | Date |
| | | | |

| | | | |
|---|---|---|---|
| | | | |

| | | | |
|---|---|---|---|
| | | | |

| | | | |
|---|---|---|---|