238

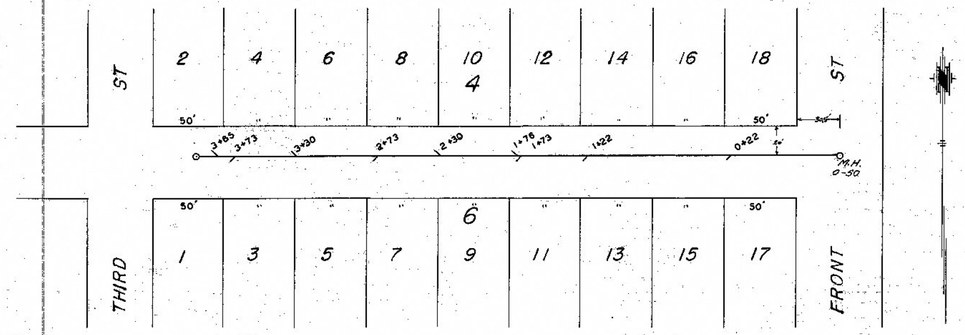

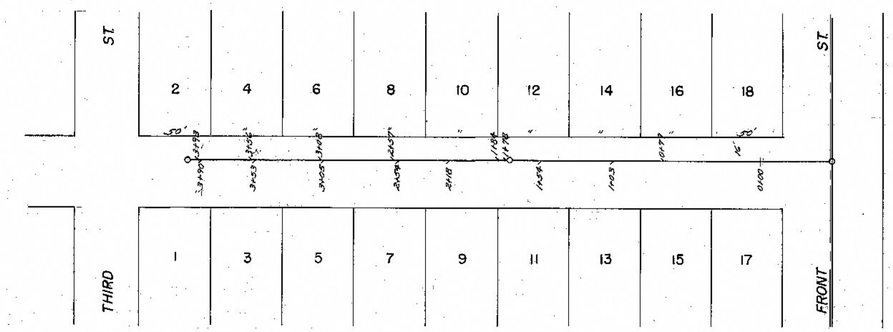

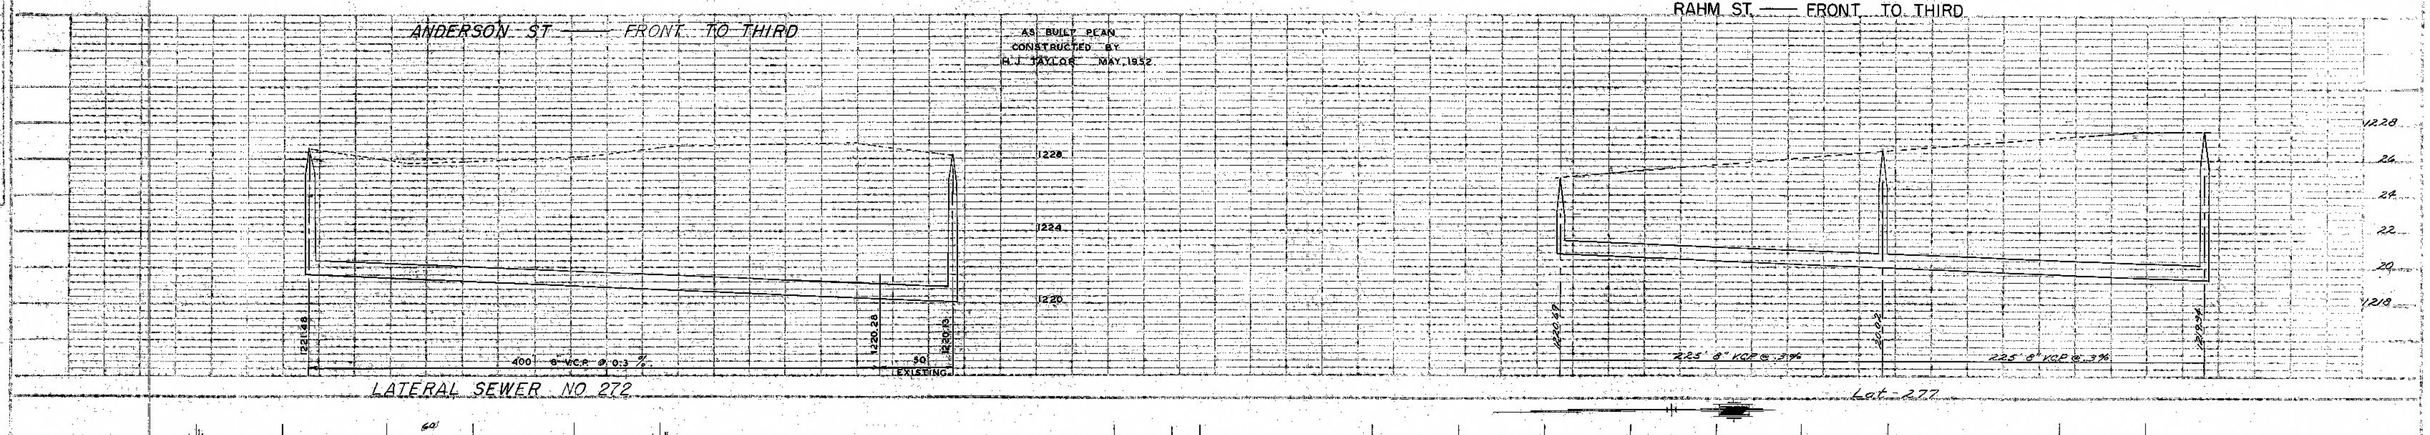

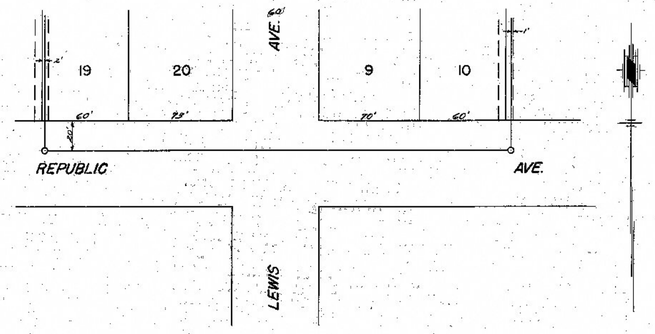

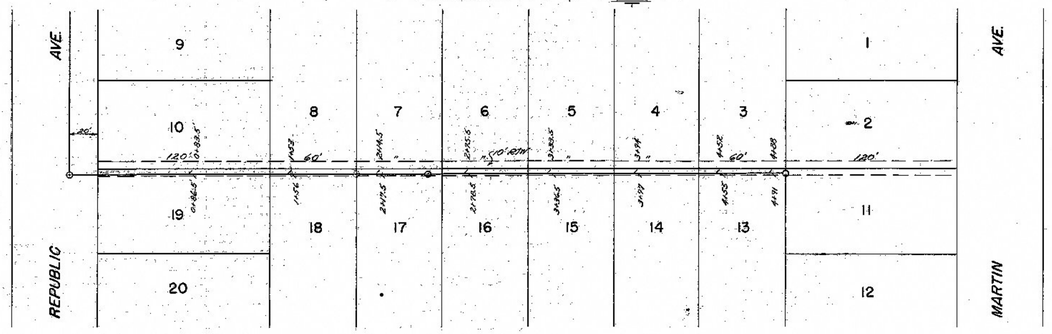

REPUBLIC —— R/W E. PEARL TO R/W E. LEWIS
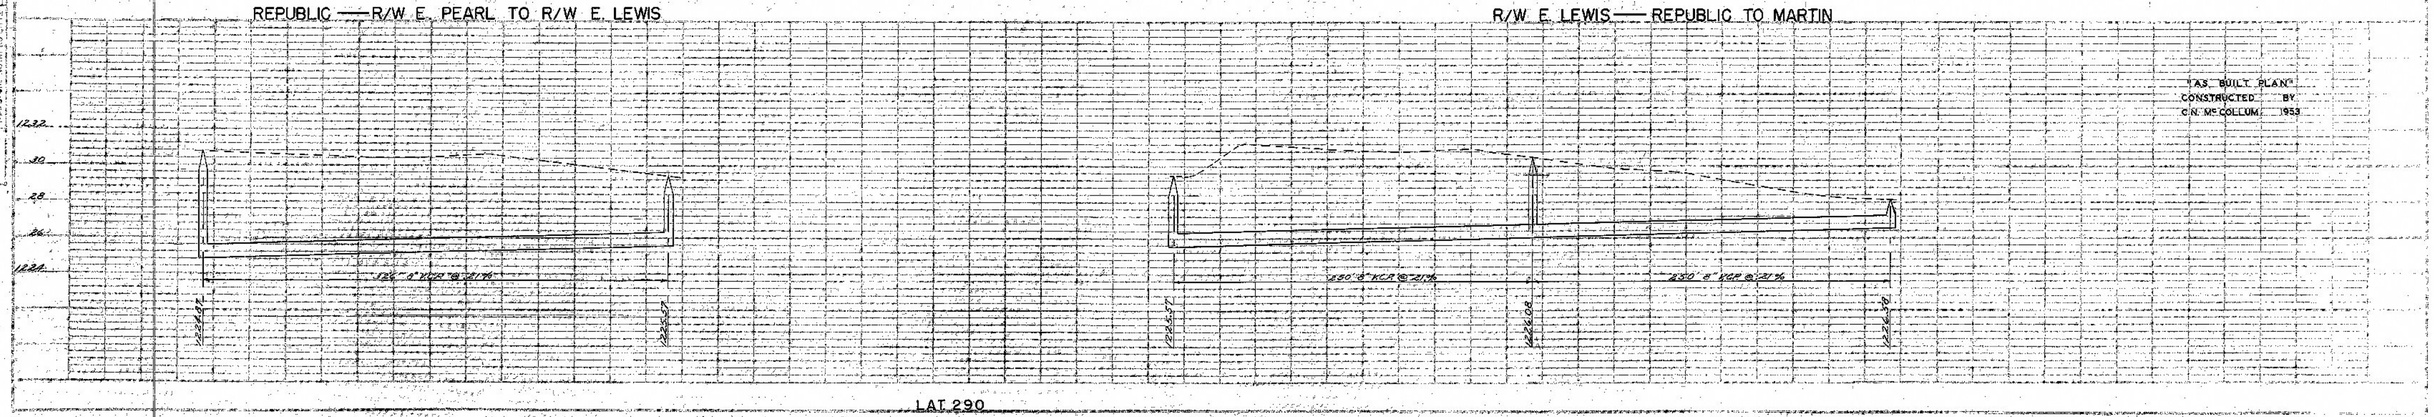
R/W E. LEWIS —— REPUBLIC TO MARTIN