239

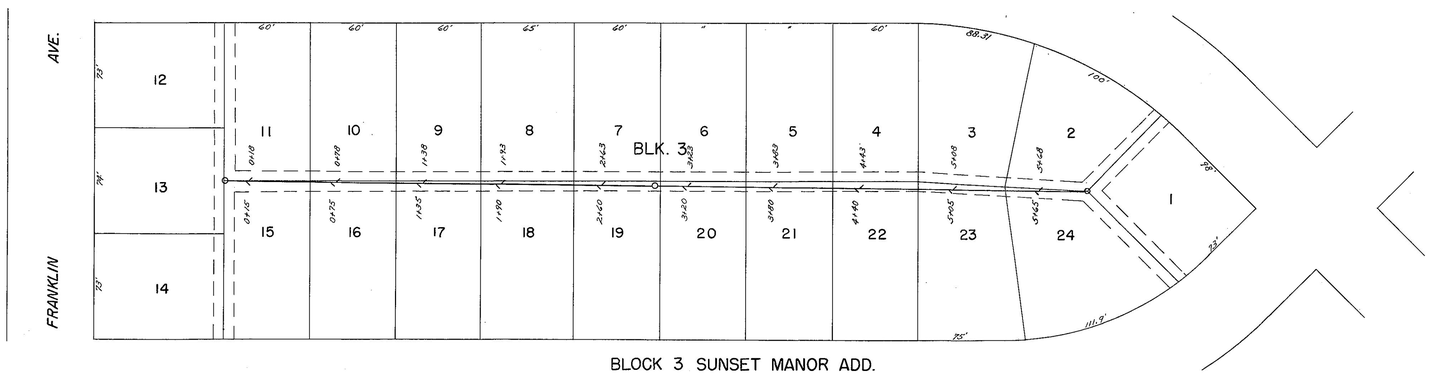

BLOCK 3 SUNSET MANOR ADD.

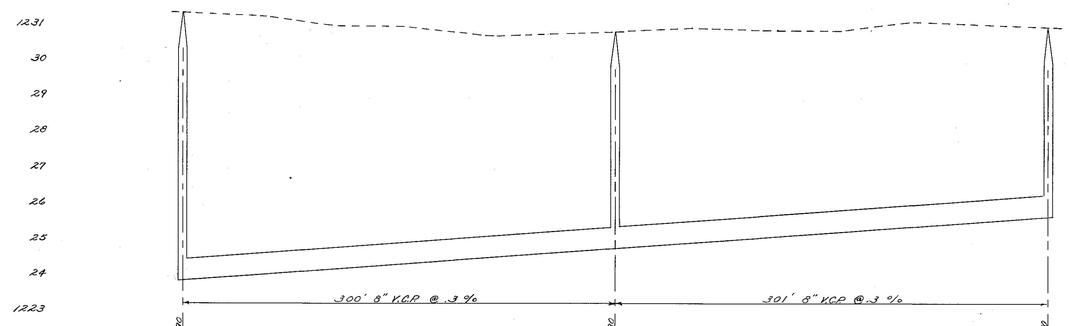

"AS BUILT" PLAN"
CONSTRUCTED BY
C. N. McCOLLUM 1953

LAT. 287

MO. P. R.R. R/W

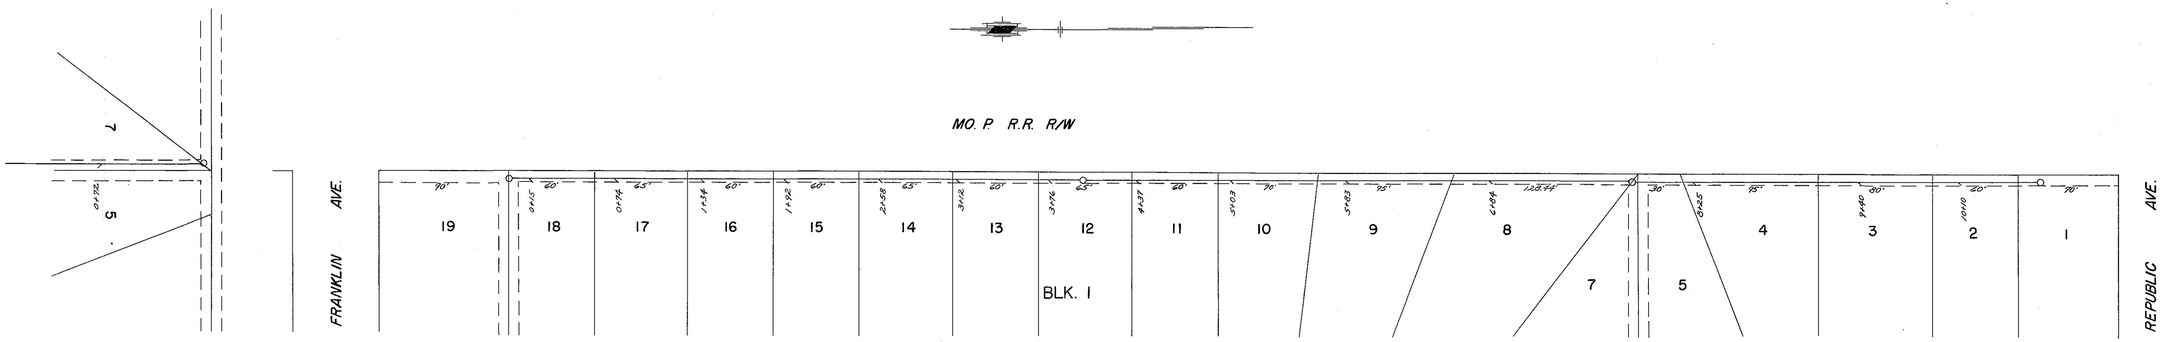

BLOCK 1 SUNSET MANOR ADD.

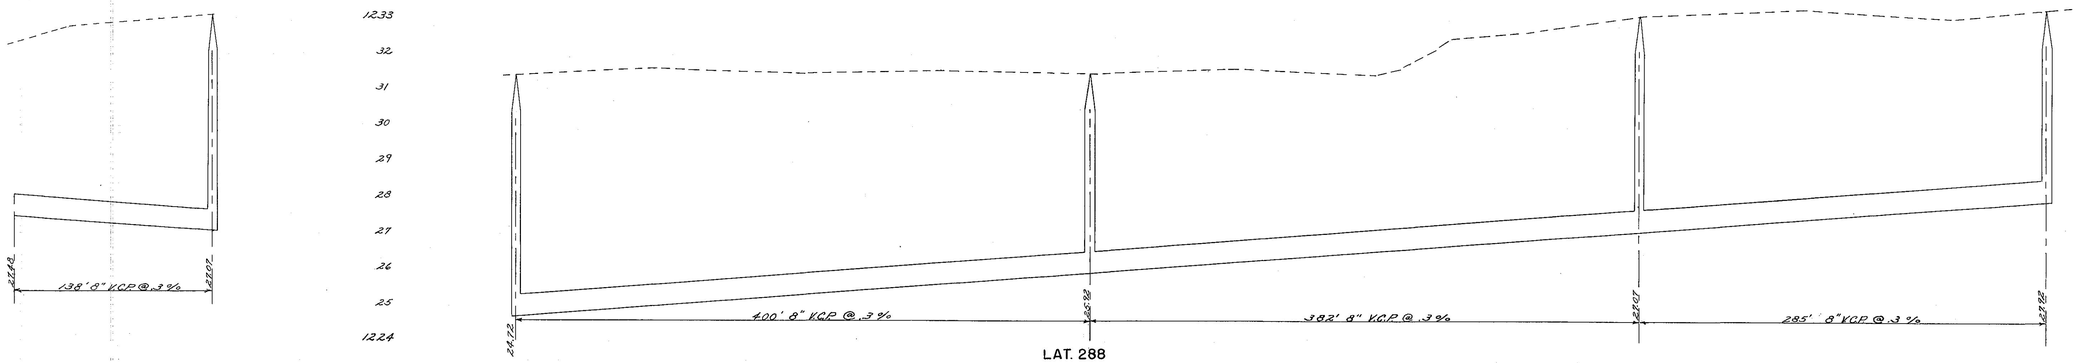

LAT. 288