


US HIGHWAY 81 BYPASS

CRAWFORD

BROADWAY BLVD. — CRAWFORD TO 1442' N.

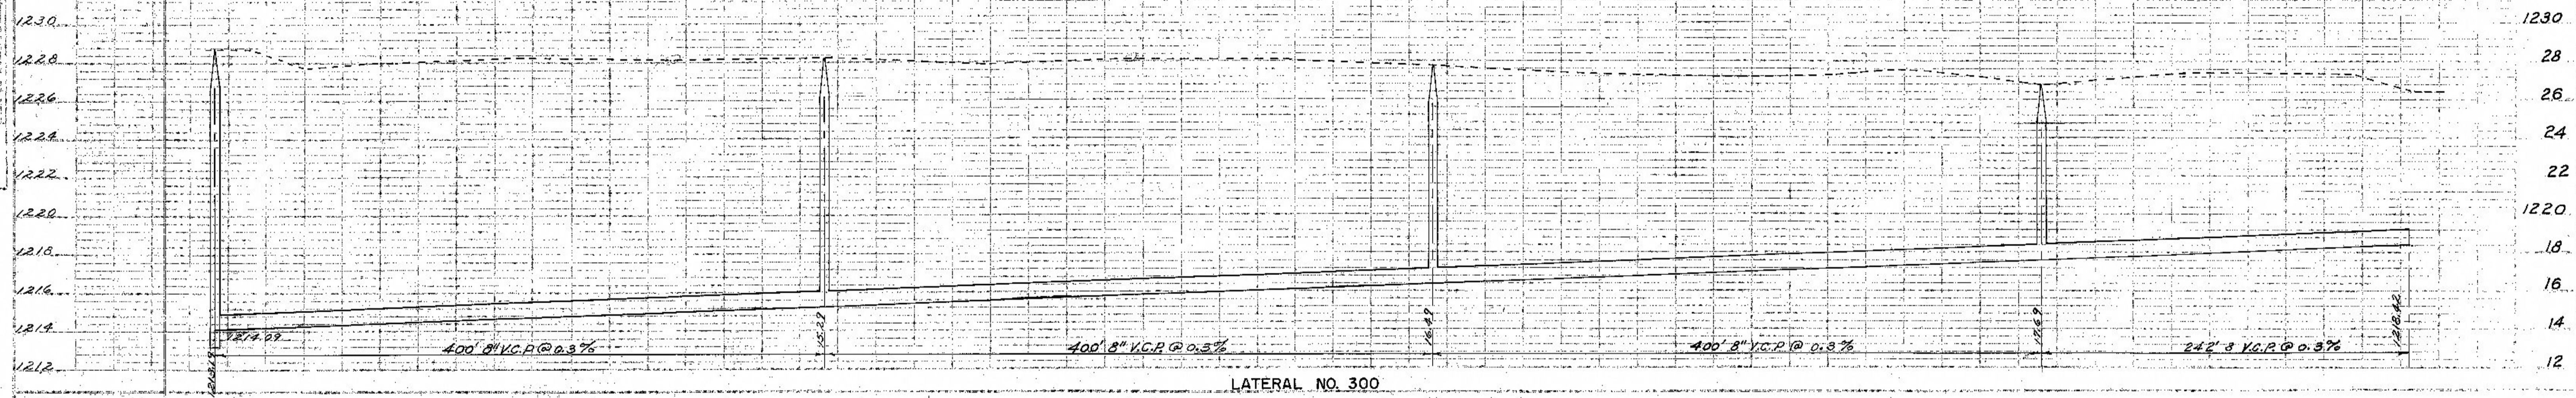

LATERAL NO. 300

