



PLAN SURVEYED BY DATE
 PLOTTED BY
 NOTE BOOK NO. OF SHEETS
 NO. OF SHEETS CHECKED
 BY OF WAY CHECKED


PROFILE SURVEYED BY DATE
 PLOTTED BY
 NOTE BOOK NO. OF SHEETS
 NO. OF SHEETS CHECKED
 BY OF WAY CHECKED

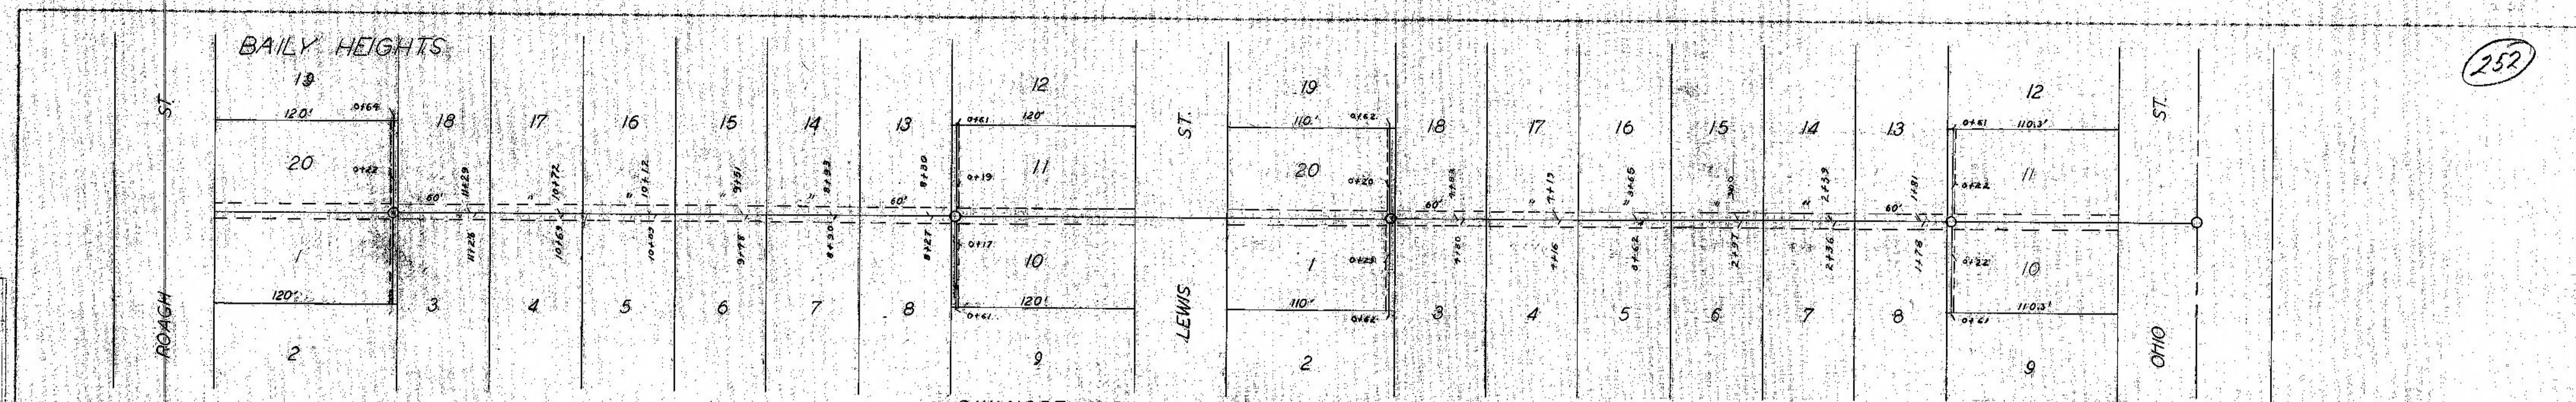

R/W NORTH KIRWIN - ROACH TO OHIO

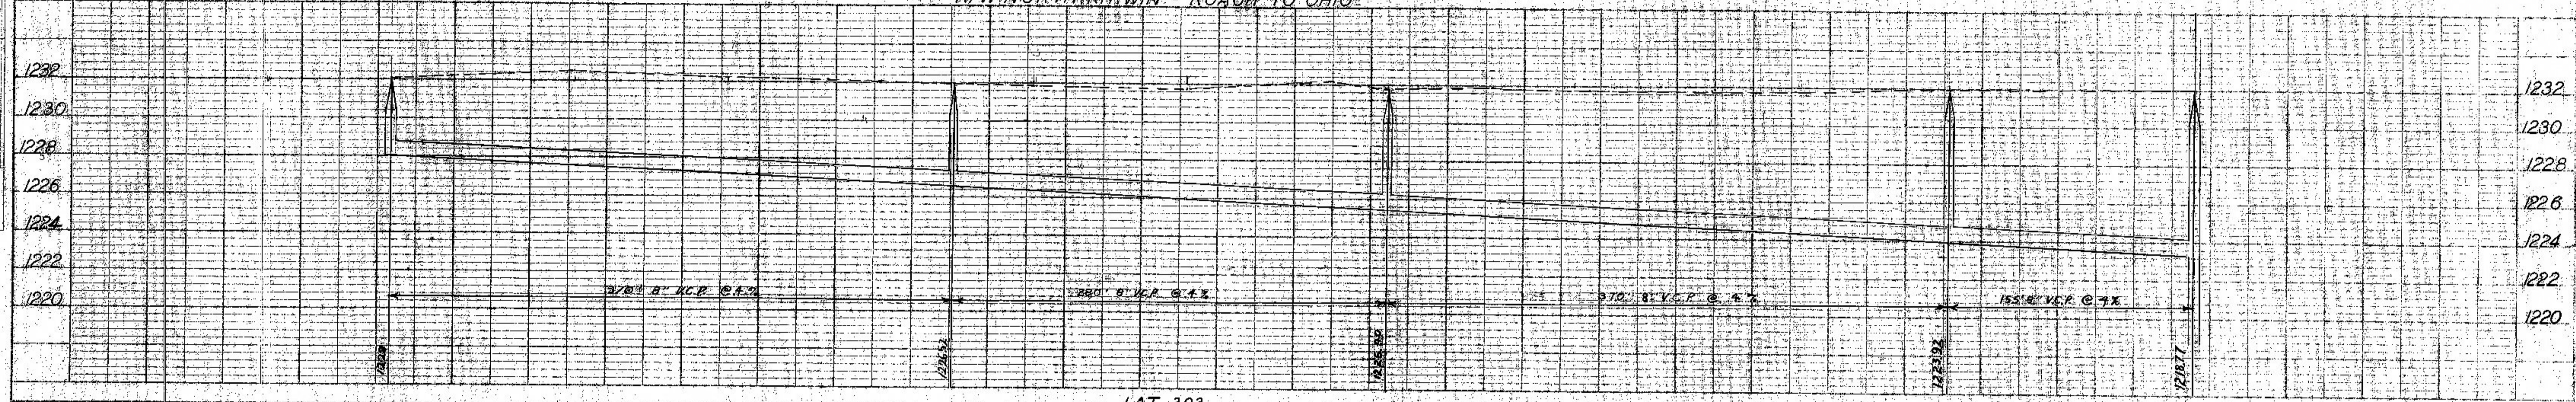


LAT. 303

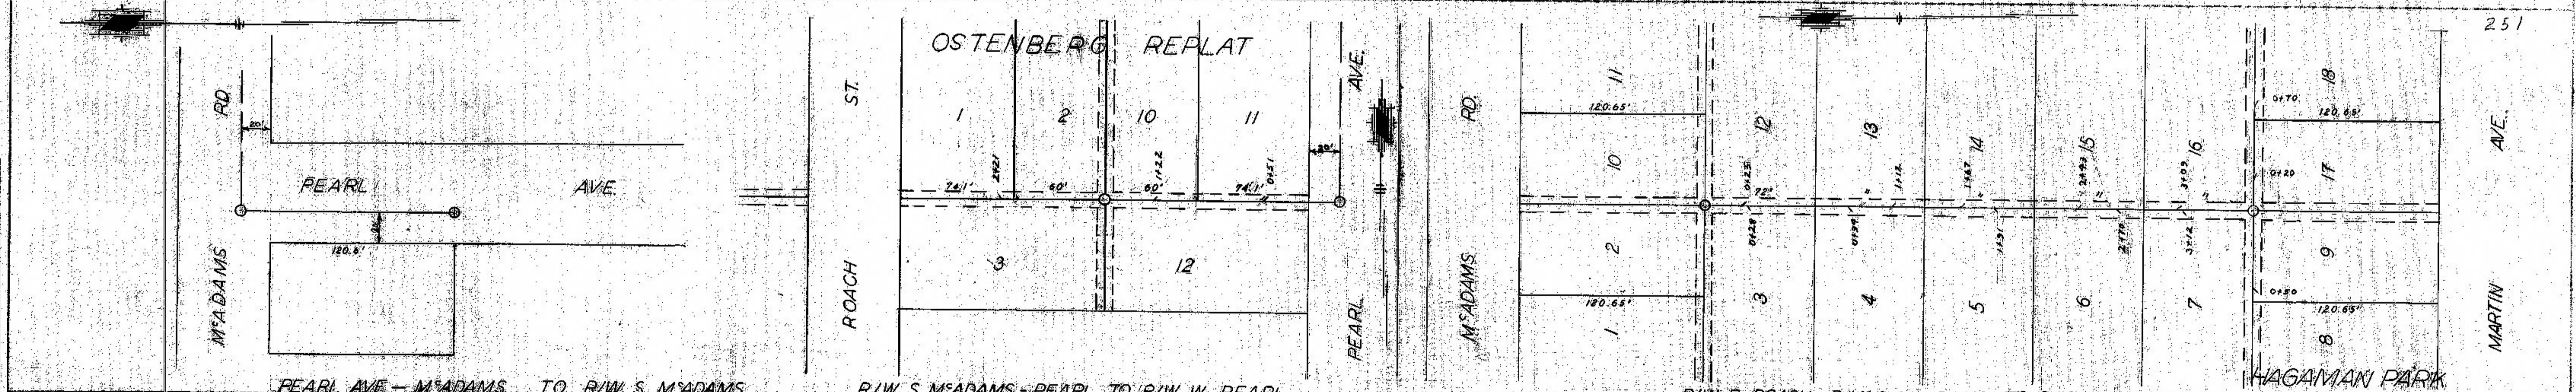

PEARL AVE - M'ADAMS TO R/W S. M'ADAMS

R/W S. M'ADAMS - PEARL TO R/W W. PEARL

R/W E. ROACH - R/W S. M'ADAMS TO R/W N. MARTIN

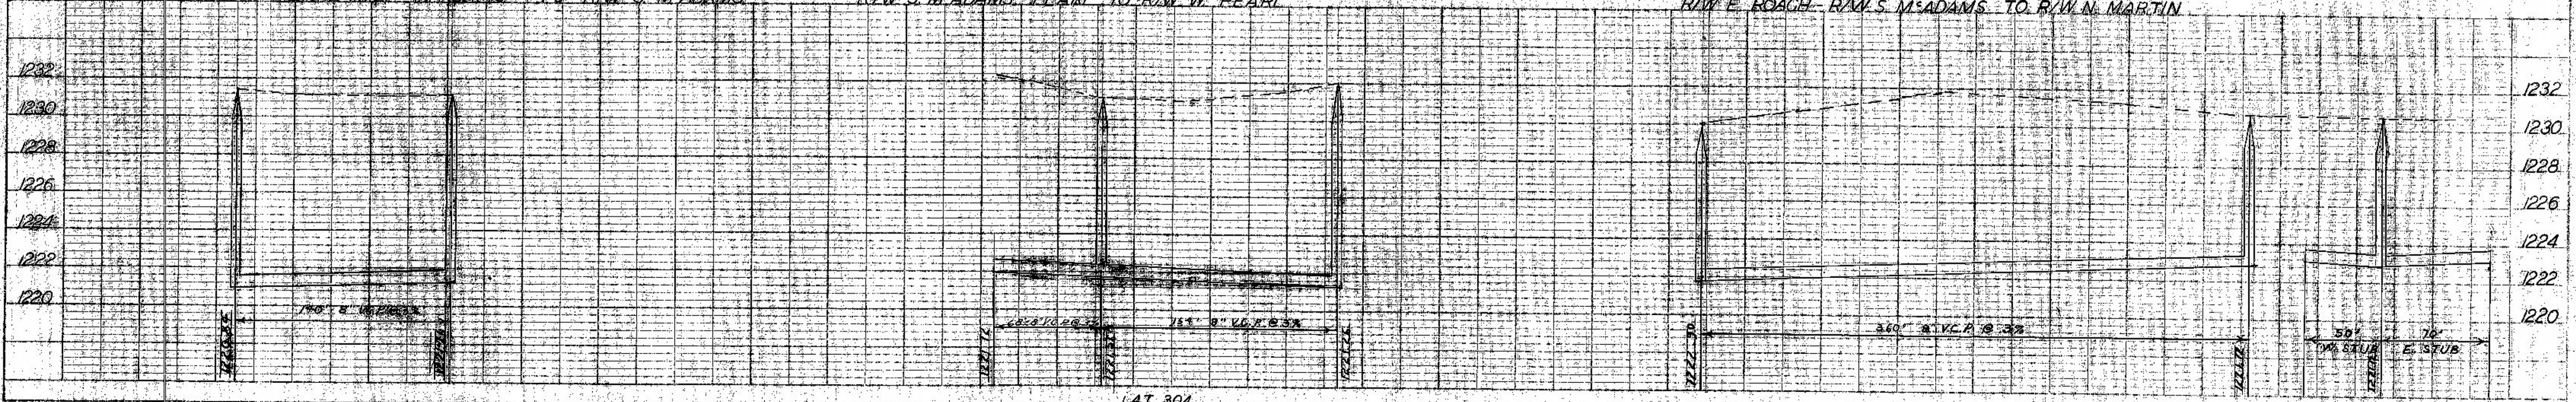

LAT. 304