281

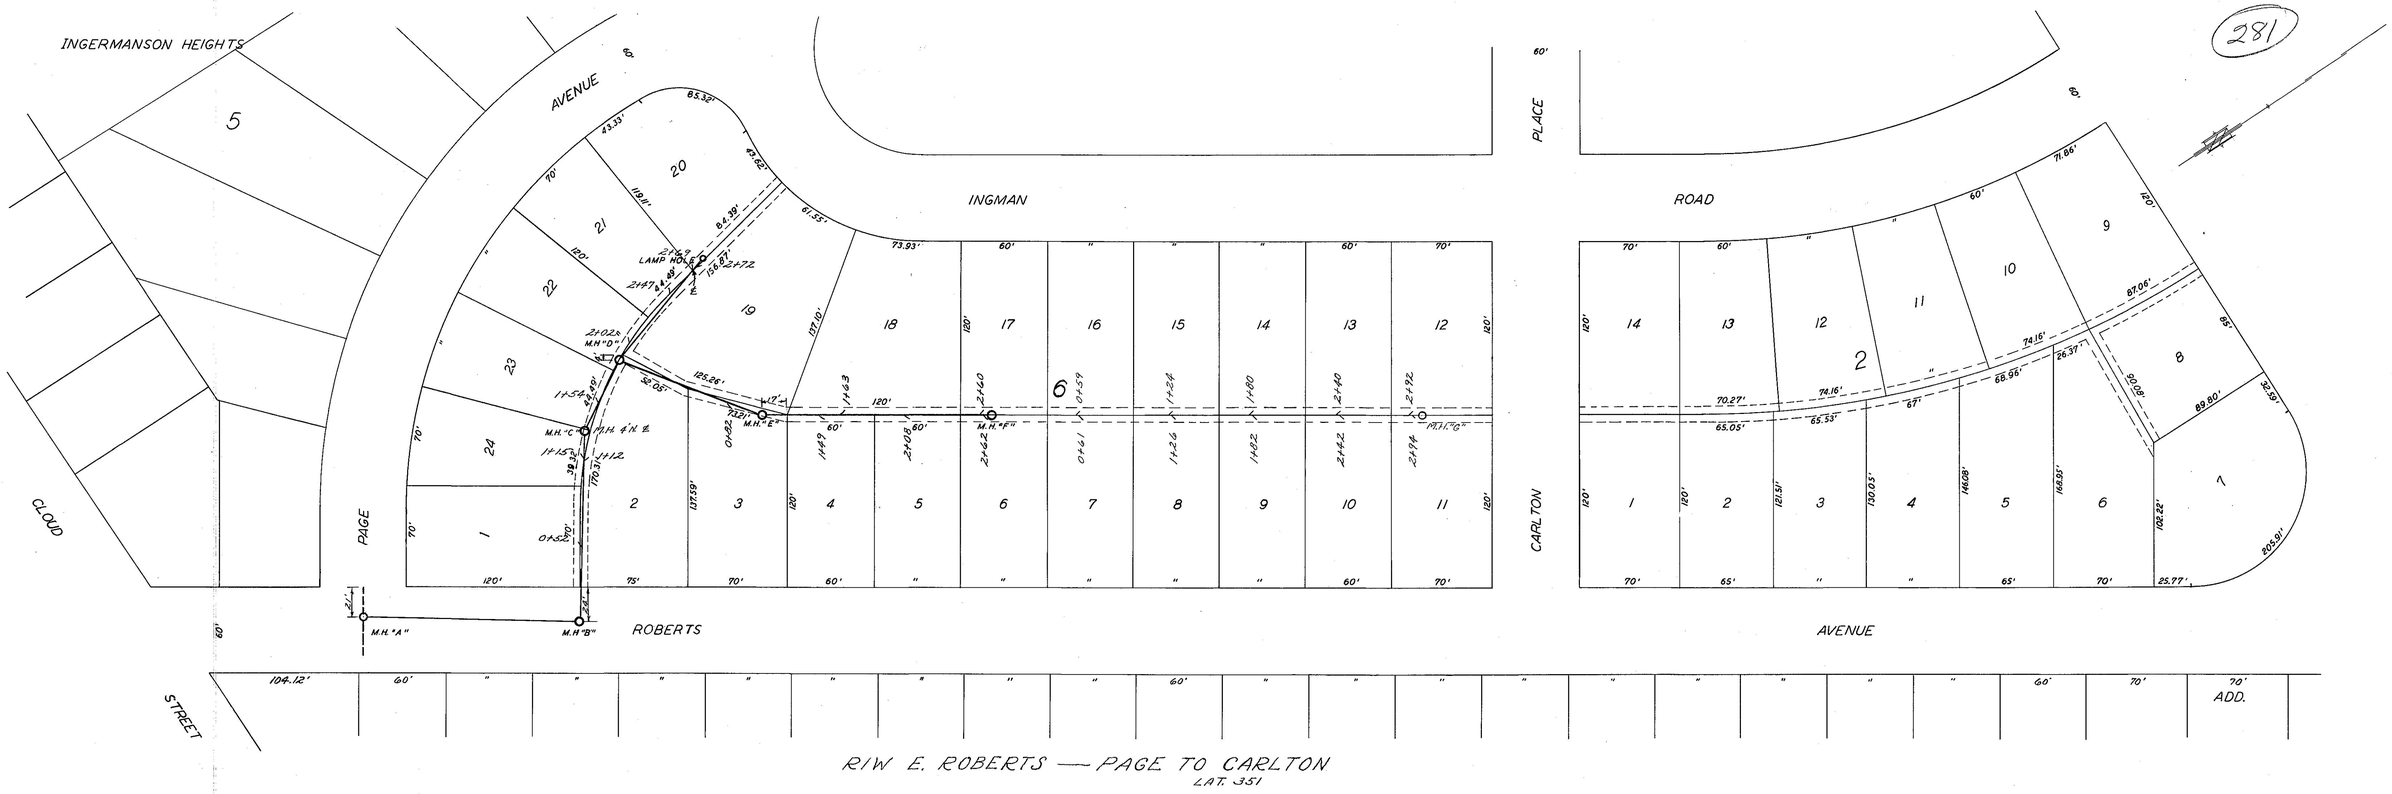
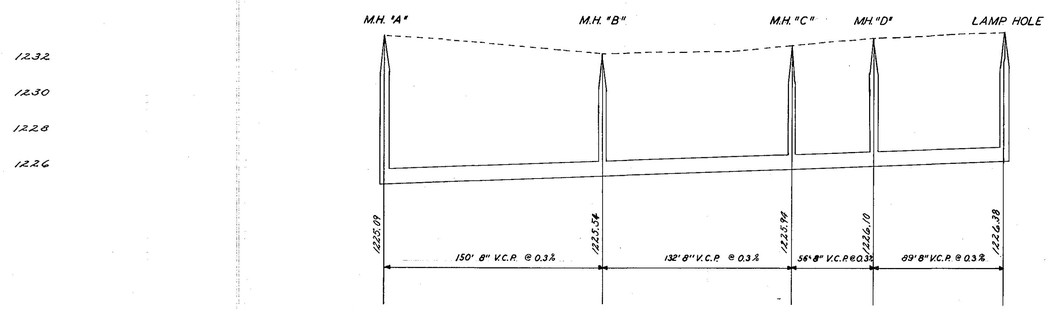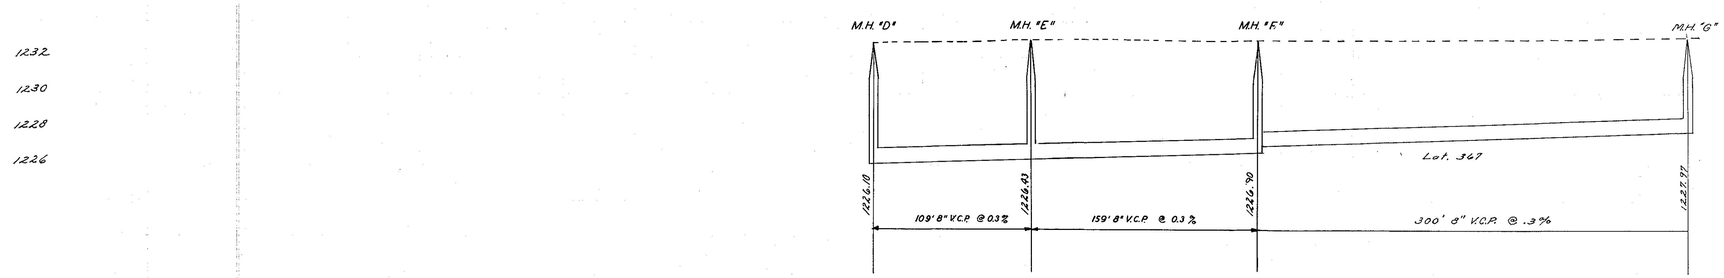
R/W E. ROBERTS — PAGE TO CARLTON
L.A.T. 351