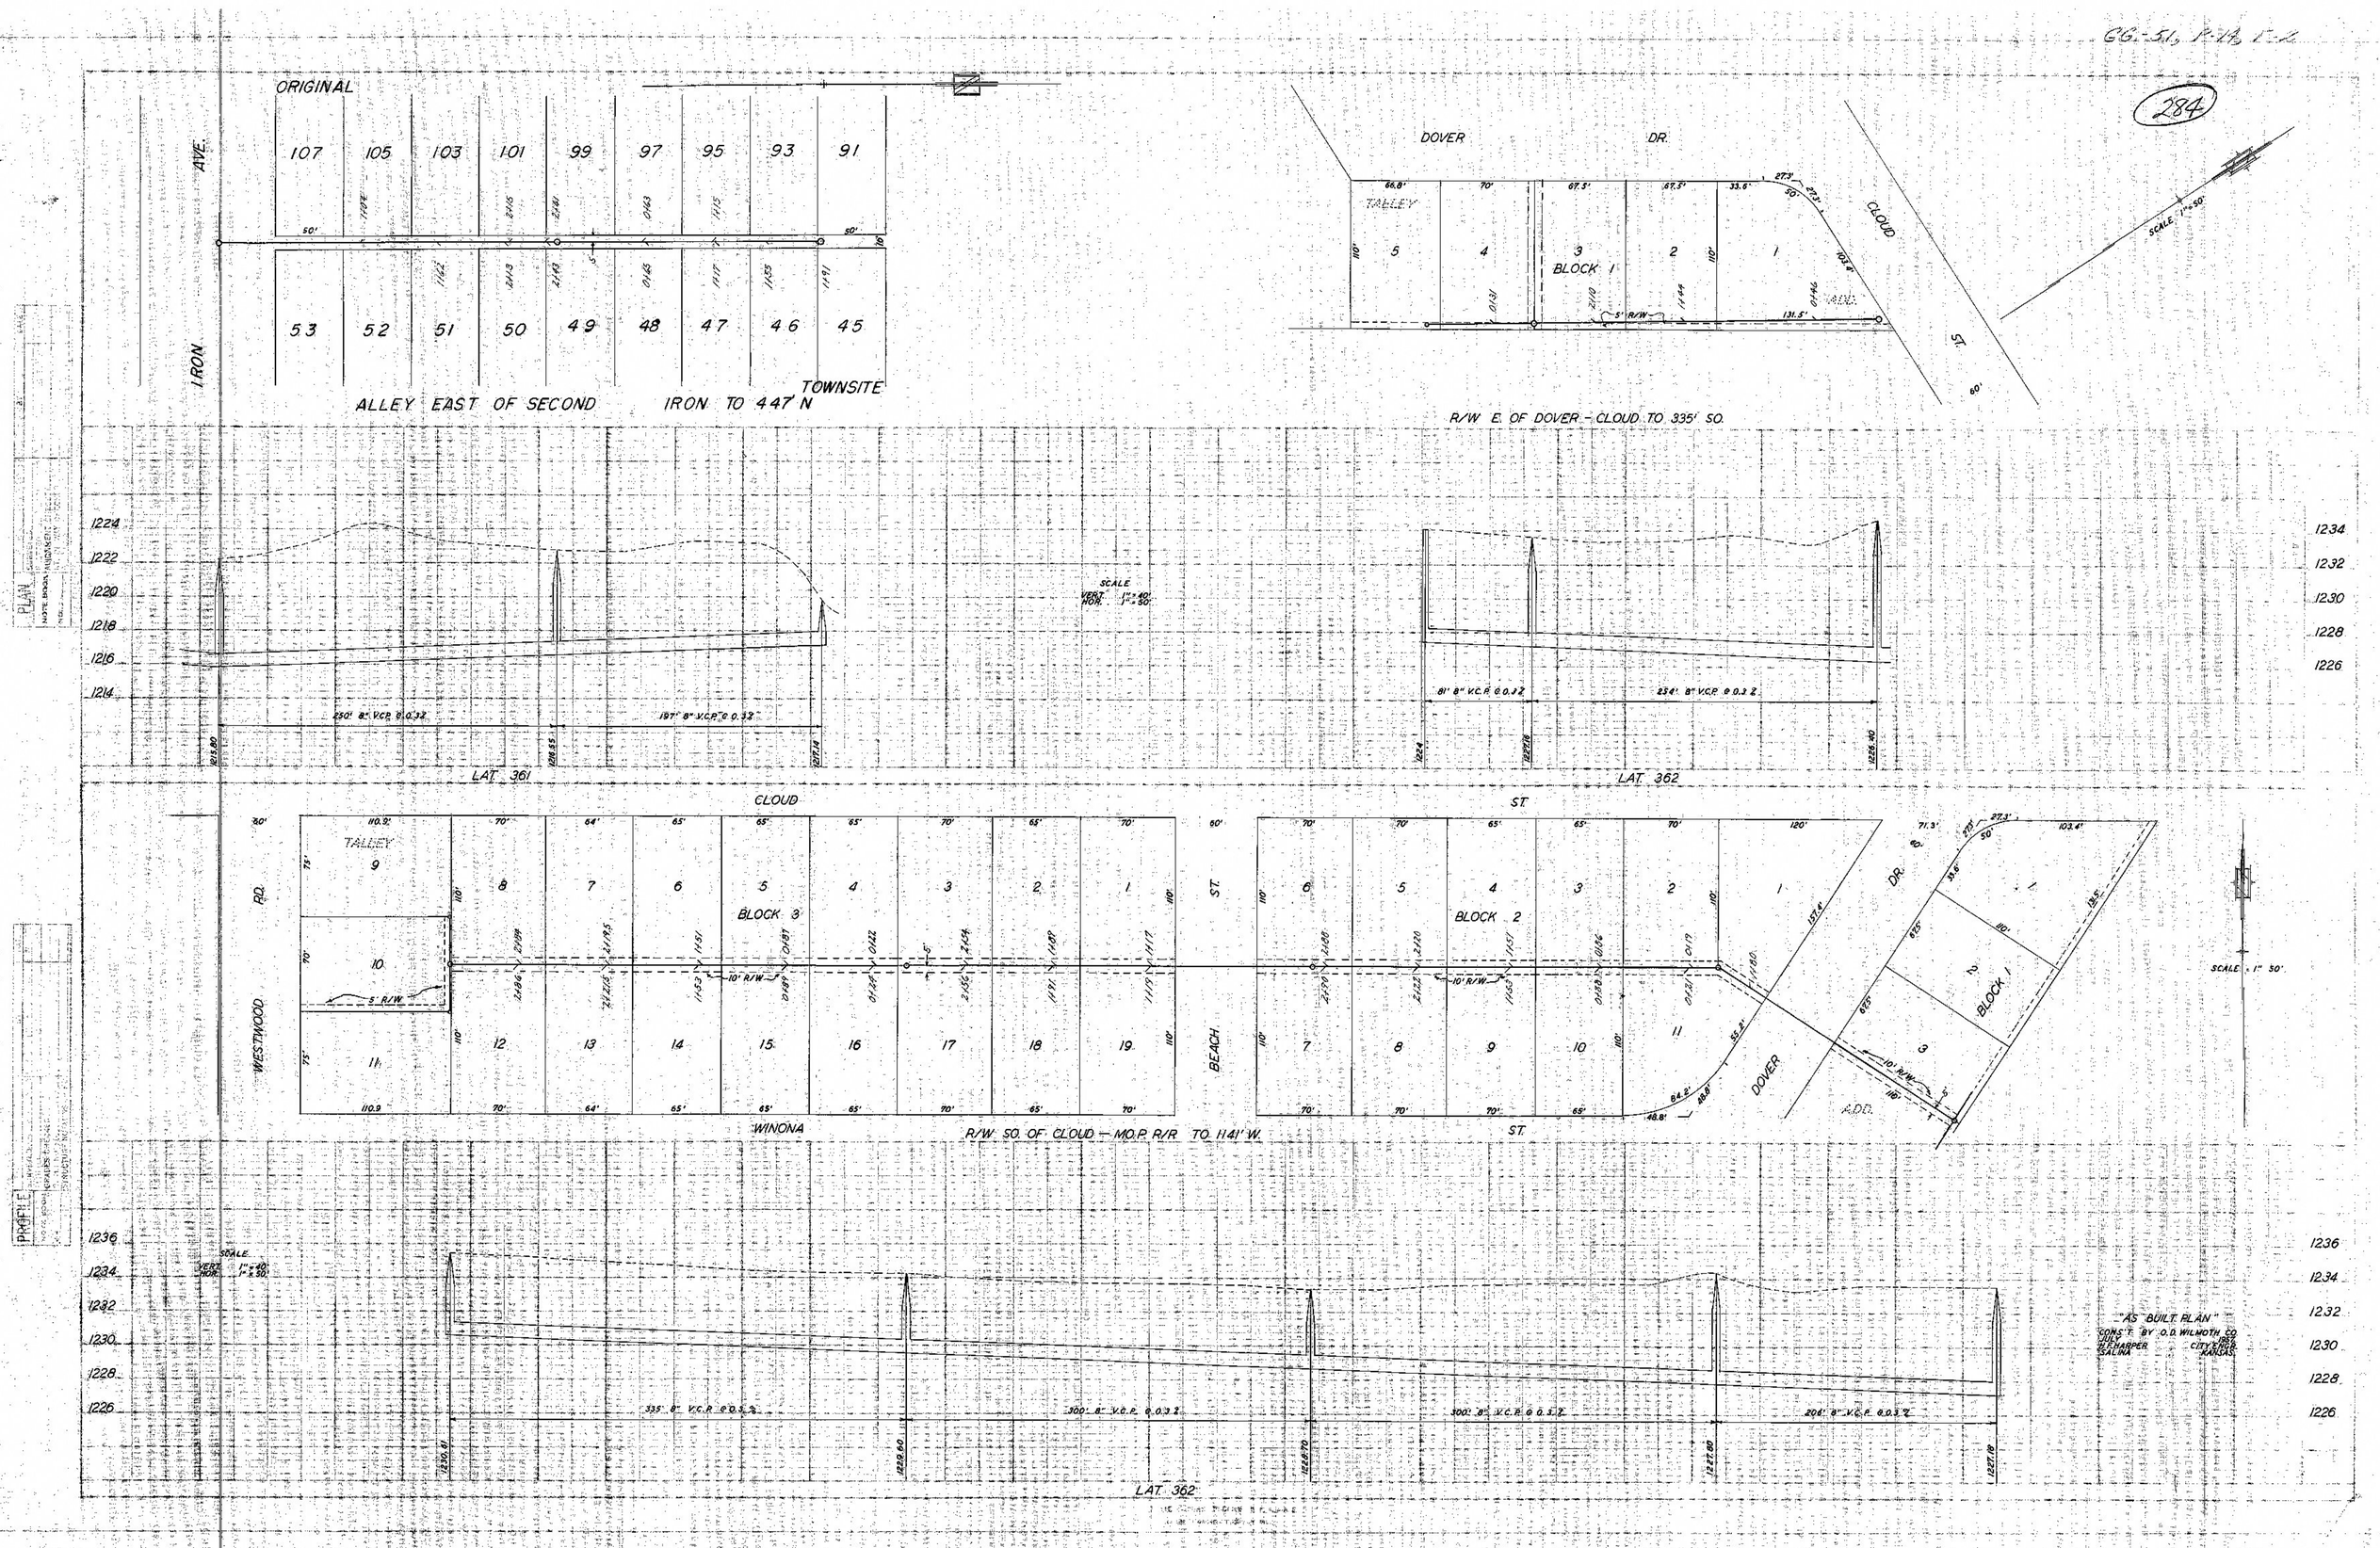

GG-51, P-14, F-2
284
ORIGINAL
IRON AVE.
107 105 103 101 99 97 95 93 91
53 52 51 50 49 48 47 46 45
TOWNSITE
ALLEY EAST OF SECOND IRON TO 447' N
DOVER DR.
TALLEY
BLOCK 1
CLOUD ST.
SCALE 1"=50'
R/W E. OF DOVER - CLOUD TO 335' SO.
LAT. 361
LAT. 362
CLOUD ST.
WESTWOOD RD.
BEACH ST.
BLOCK 3
BLOCK 2
BLOCK 1
WINONA ST.
DOVER DR.
ADD.
R/W SO. OF CLOUD - MO.P. R/R TO 1141' W.
SCALE 1" 50'
"AS BUILT PLAN"
CONS'T. BY O.D. WILMOTH CO.
JULY 1957
H.F. HARPER CITY ENGR.
SALINA KANSAS