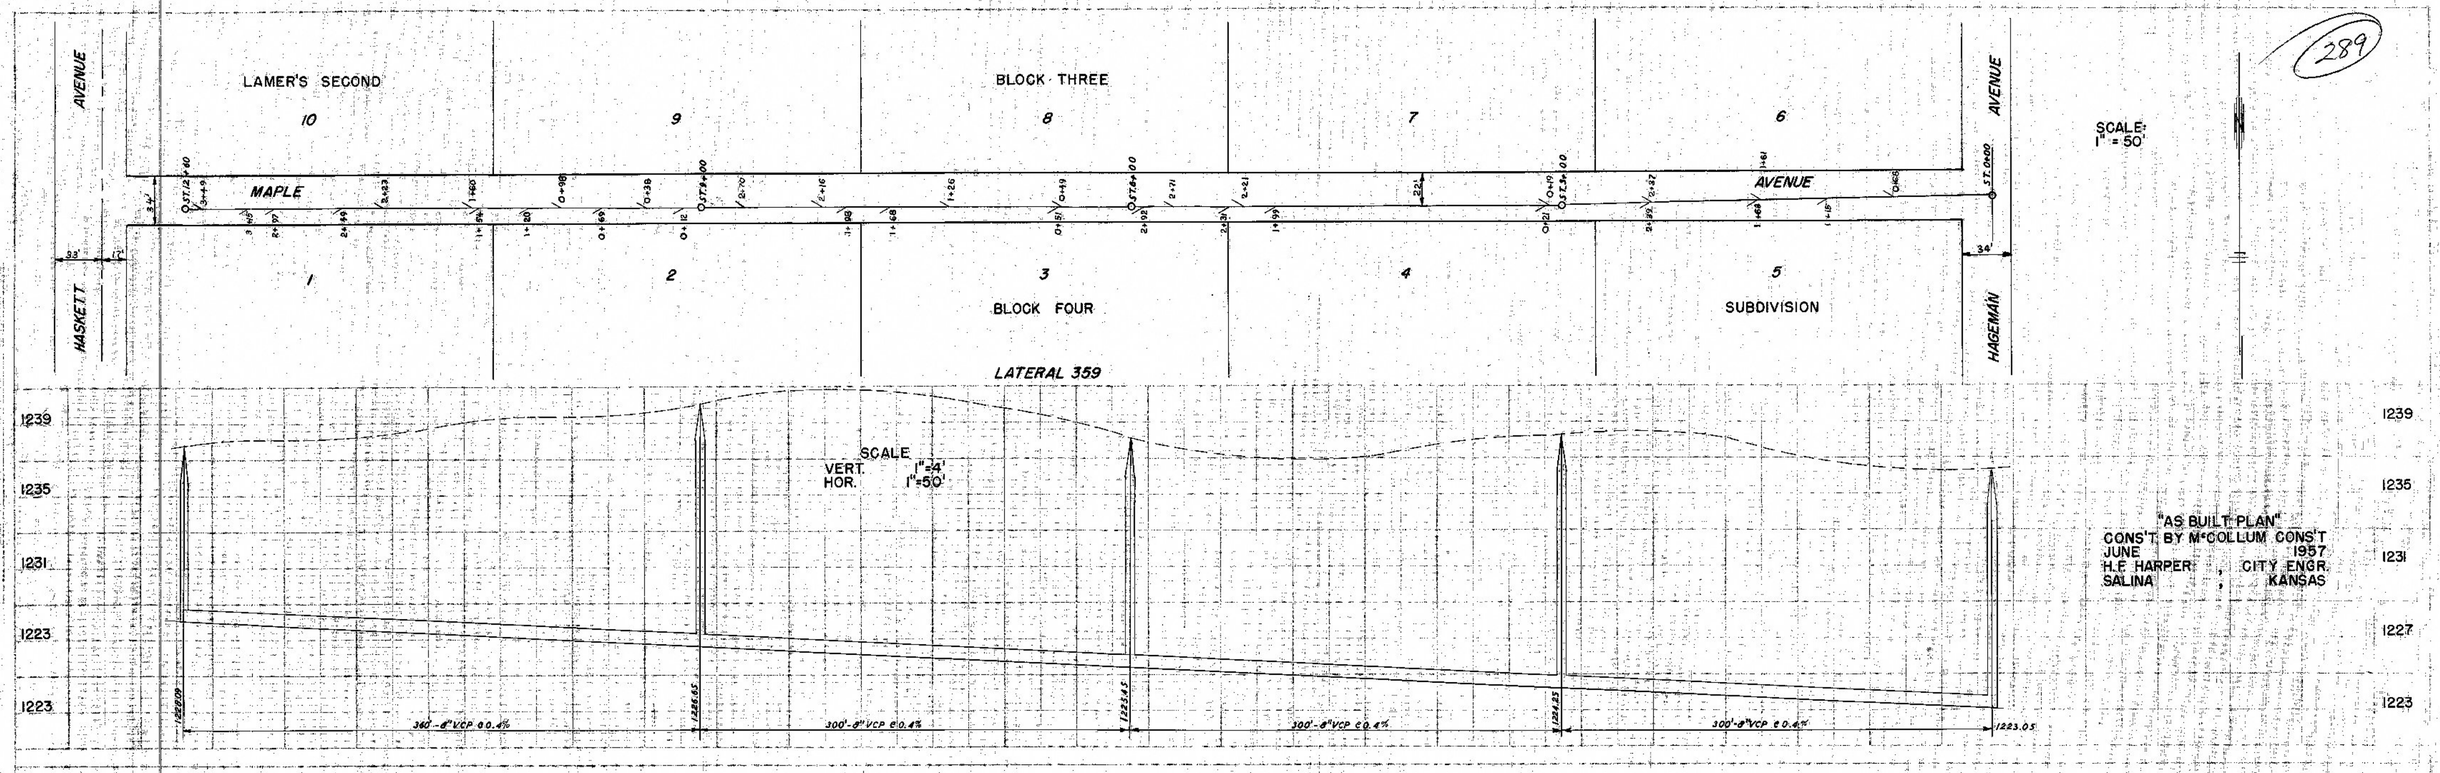
LAMER'S SECOND
BLOCK THREE
BLOCK FOUR
SUBDIVISION
MAPLE
AVENUE
HASKETT
HAGEMAN
LATERAL 359
SCALE:
1" = 50'
SCALE
VERT. 1"=4'
HOR. 1"=50'
"AS BUILT PLAN"
CONS'T. BY McCOLLUM CONS'T
JUNE 1957
H.E HARPER , CITY ENGR.
SALINA , KANSAS
360'-8" VCP @ 0.4%
300'-8" VCP @ 0.4%
300'-8" VCP @ 0.4%
300'-8" VCP @ 0.4%
1223.05