G.G-68 P-14 F-2

Sheet 2

312

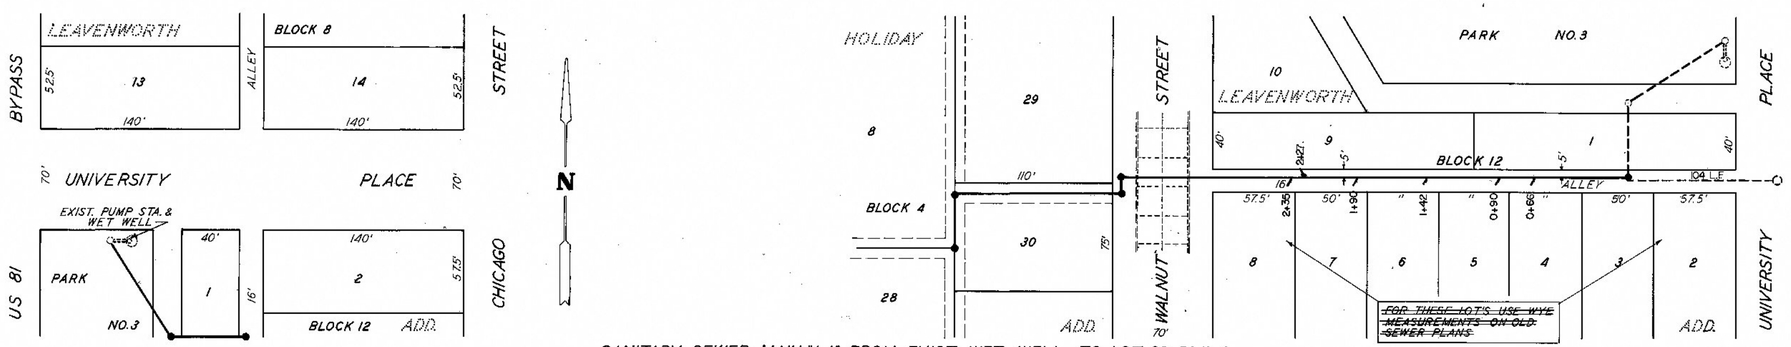

SANITARY SEWER MAIN "AJ" FROM EXIST. WET WELL TO LOT 28 BLK. 4

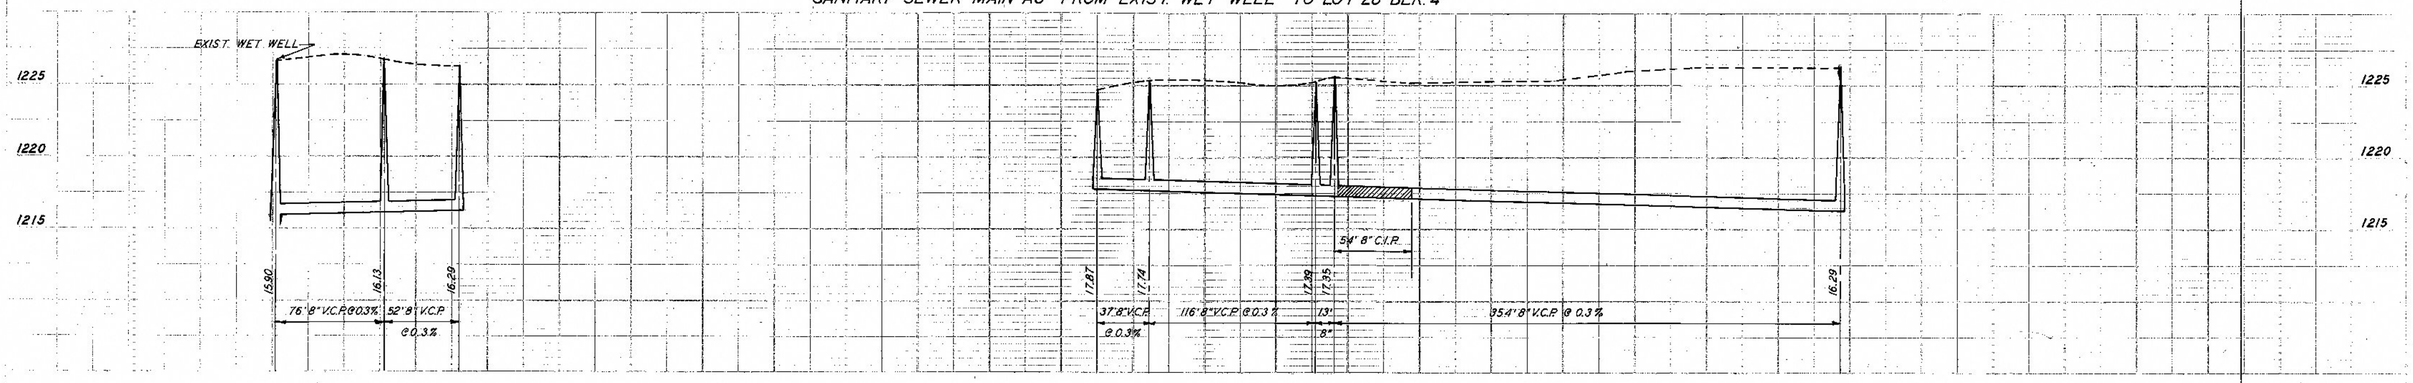

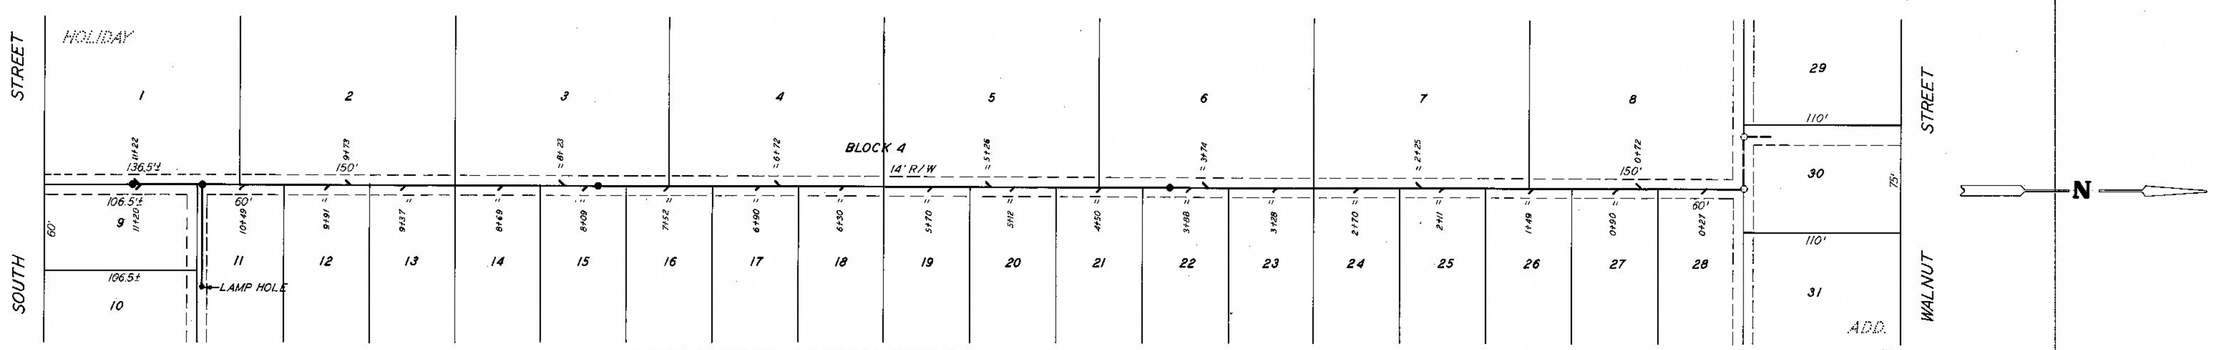

SANITARY SEWER MAIN "AJ" FROM LOT 28 TO LOT 1 BLK. 4 HOLIDAY ADD.

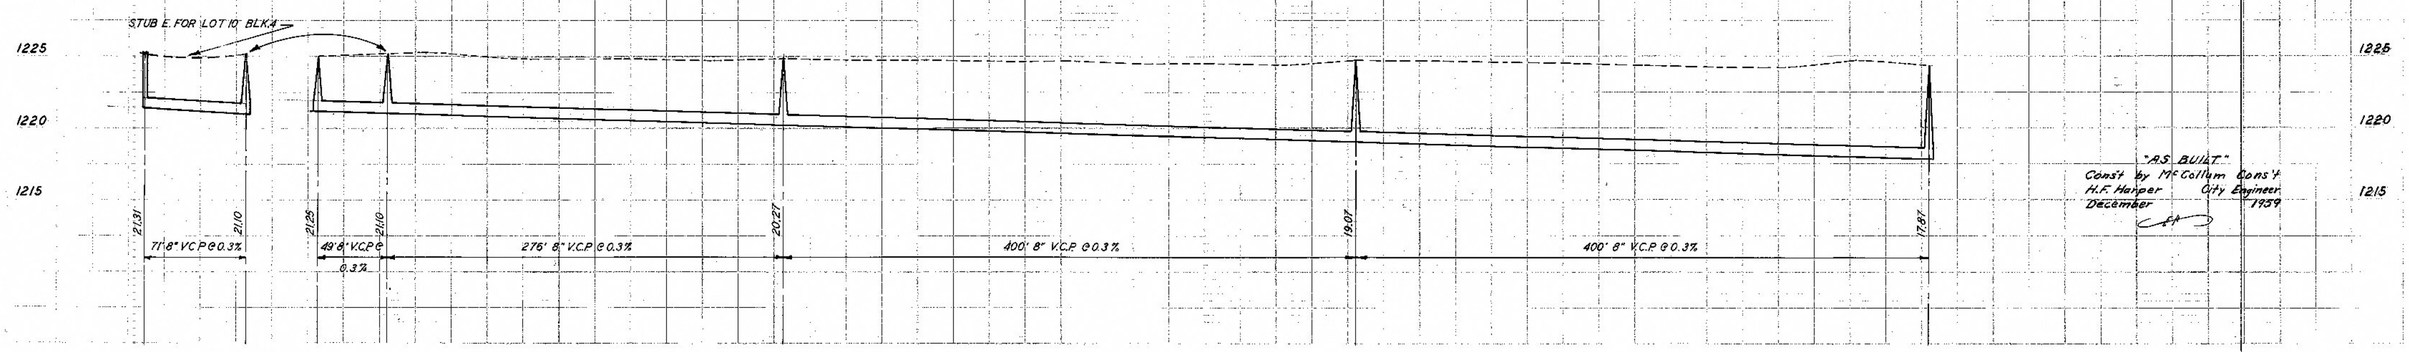

"AS BUILT"
Const by McCollum Const'
H.F. Harper City Engineer
December 1939