GG77 P-14 . 12 Sheet 1.

322

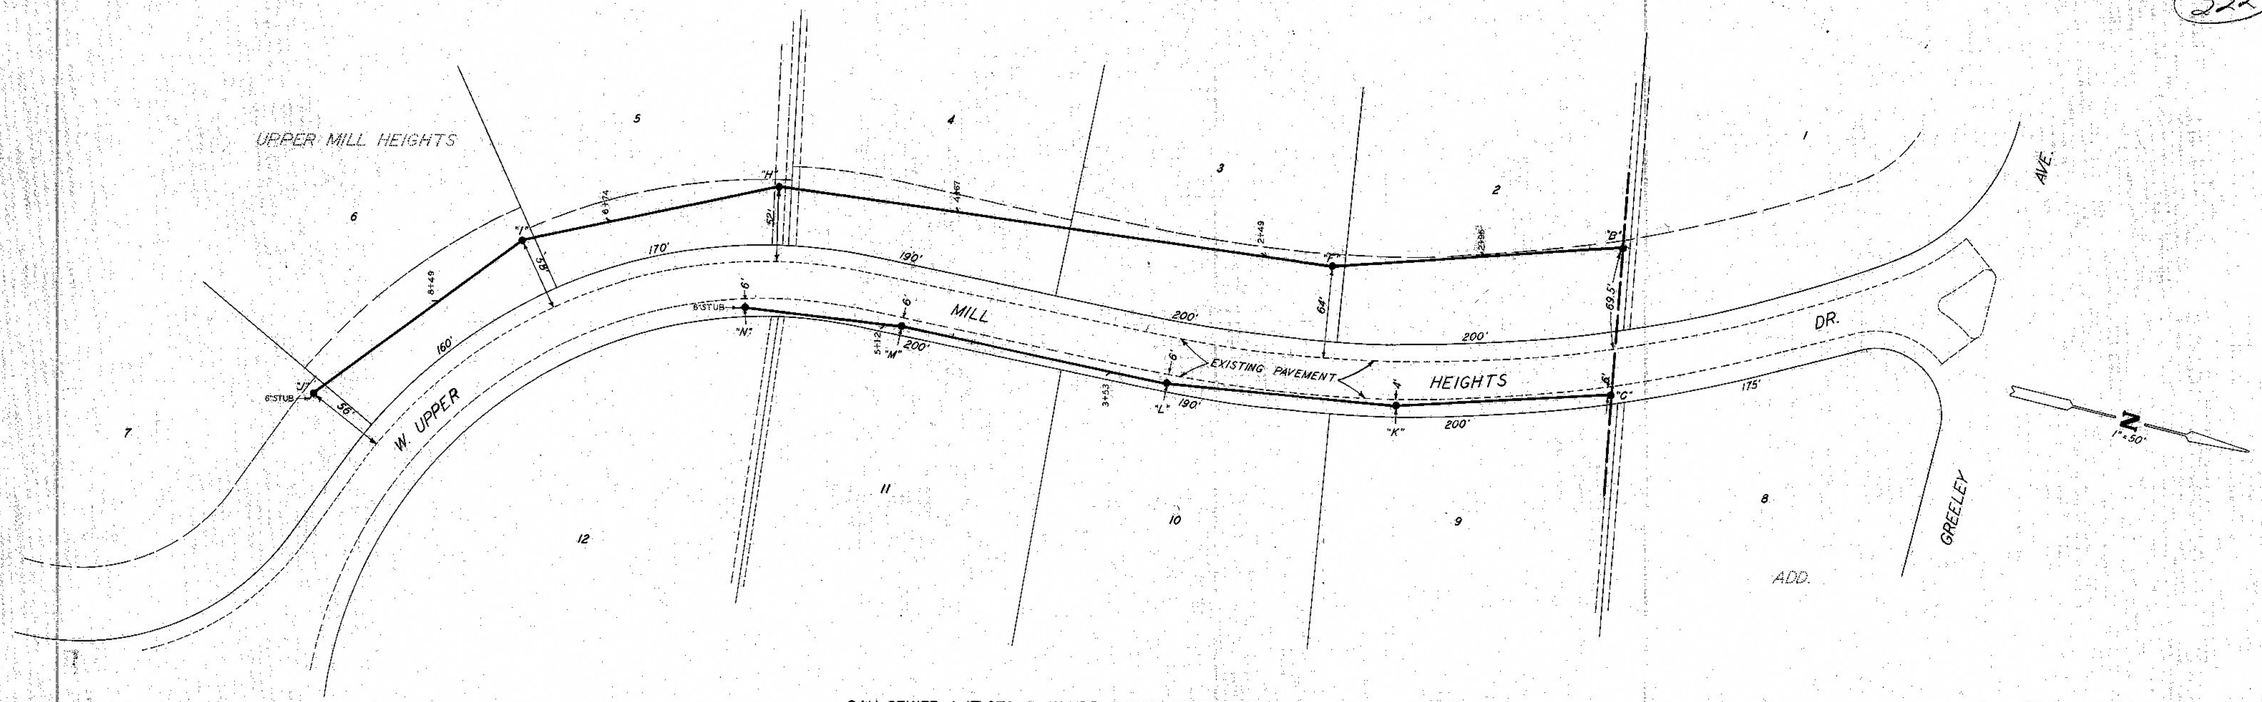

SAN. SEWER LAT. 379-A W. UPPER MILL HEIGHTS DR.

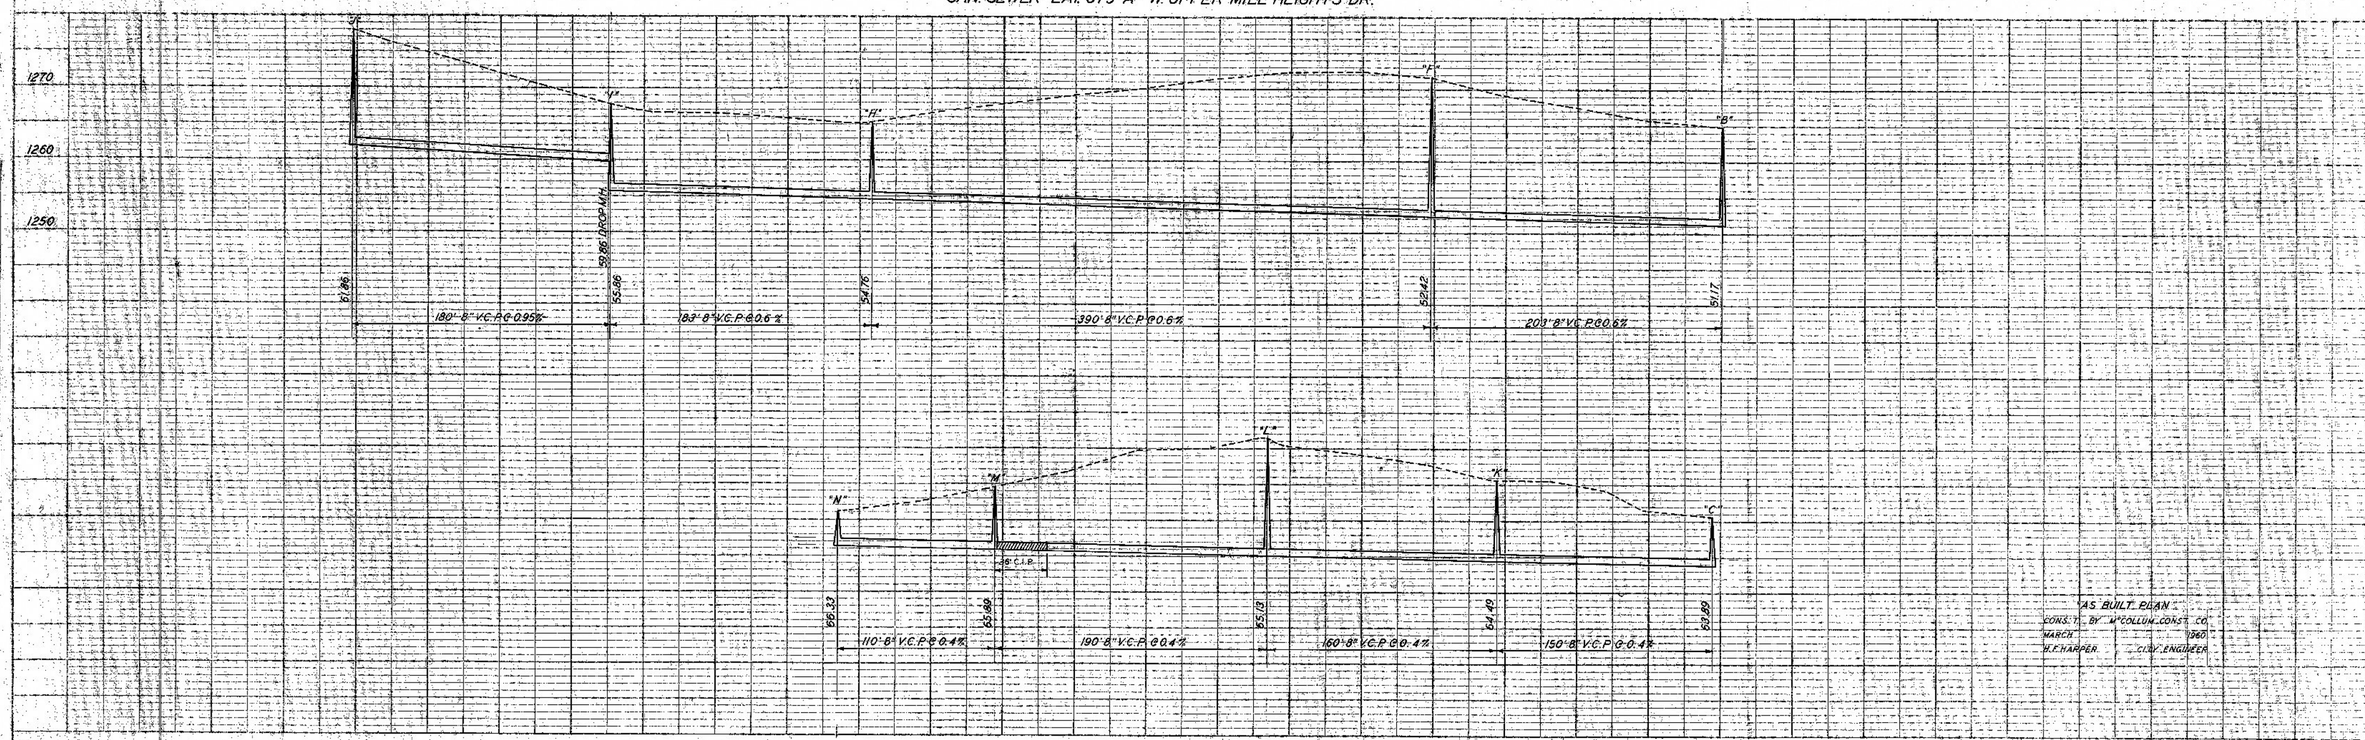

"AS BUILT" PLAN
CONS'T. BY McCOLLUM CONST. CO.
MARCH 1960

PLATE 1 - PLAN - PROFILE O. P. W. & R. E. STANDARD
BY HEPPEL & ESSER CO., NEW YORK.

R & E Co No. 348-1C