GG77 P-14 F2 Sheet 1

(323)

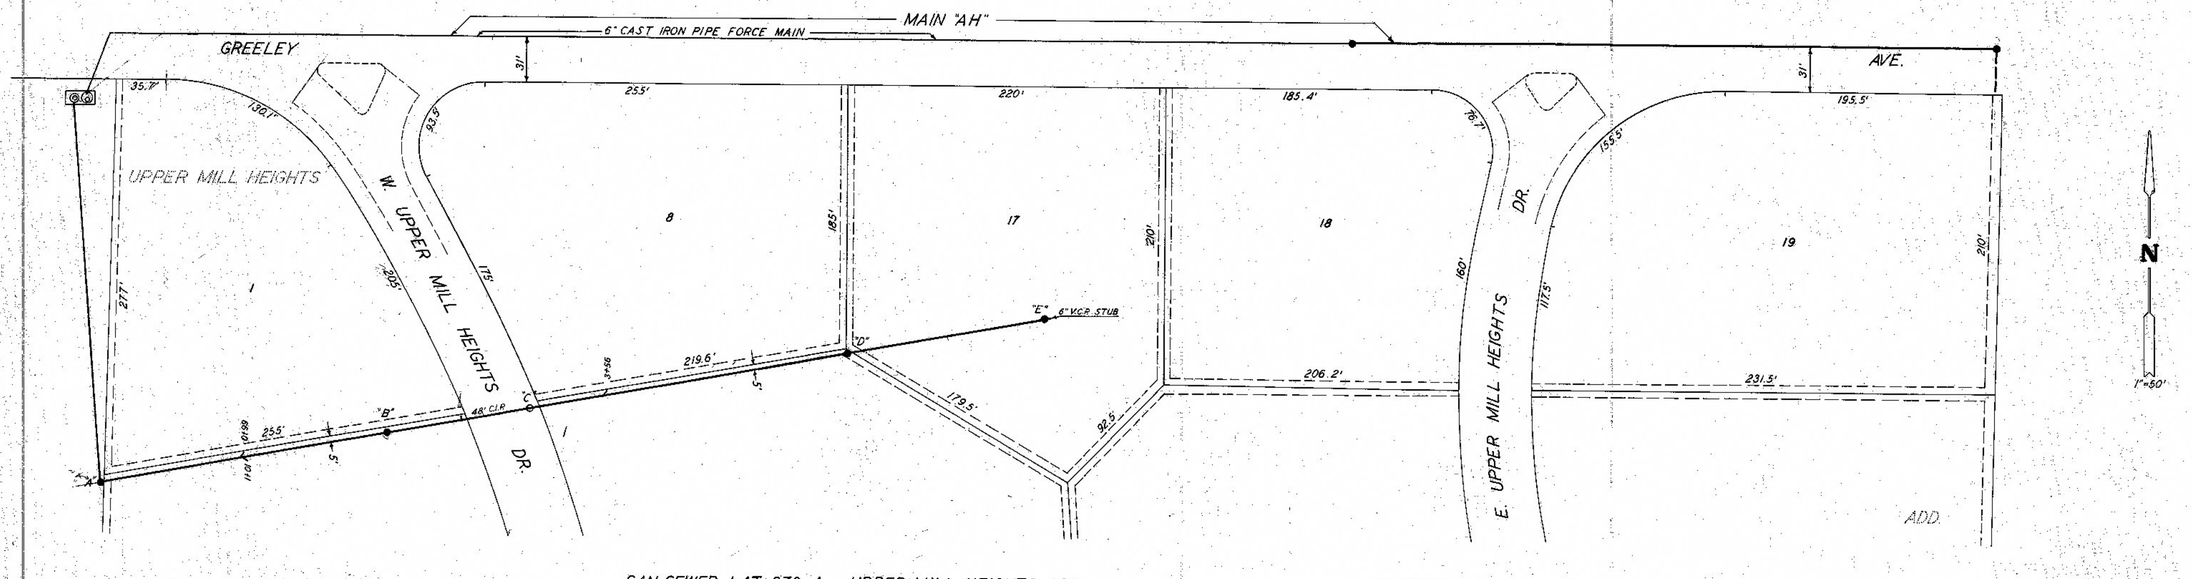

SAN. SEWER LAT. 379-A - UPPER MILL HEIGHTS ADD.

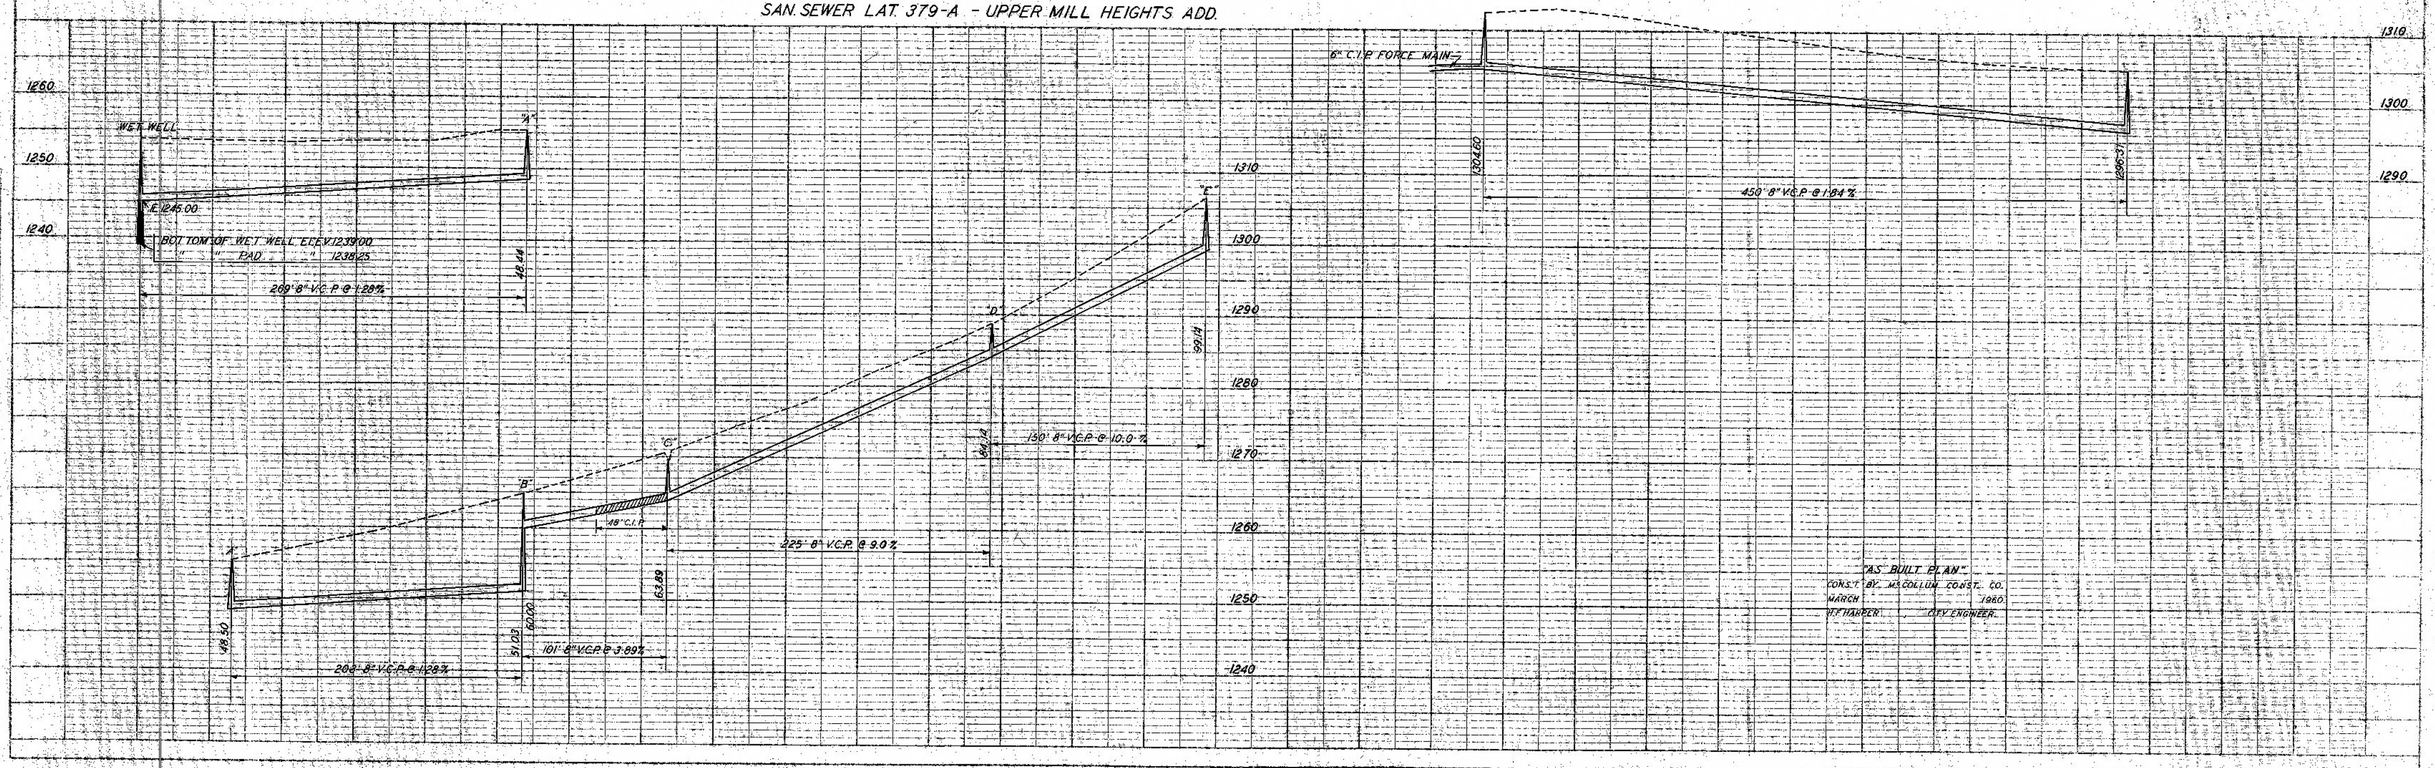

PLAN
PROFILE
NOTE BOOK
NO.
SUBMITTED
CHIEF ENGINEER
DATE
S. M.A. NOTES
STRUCTURE NOTES
PLAN
PROFILE
NOTE BOOK
NO.
SUBMITTED
CHIEF ENGINEER
DATE
S. M.A. NOTES
STRUCTURE NOTES
BY
DATE

PLATE 1 PLAN - PROFILE O. P. R. & R. E. STANDARD
HUFFEL & ESSEE CO., NEW YORK.

K & E Co. No. 346-K
IMPERIAL TRACING CLOTH
20x10