GG77 P-14 F-2

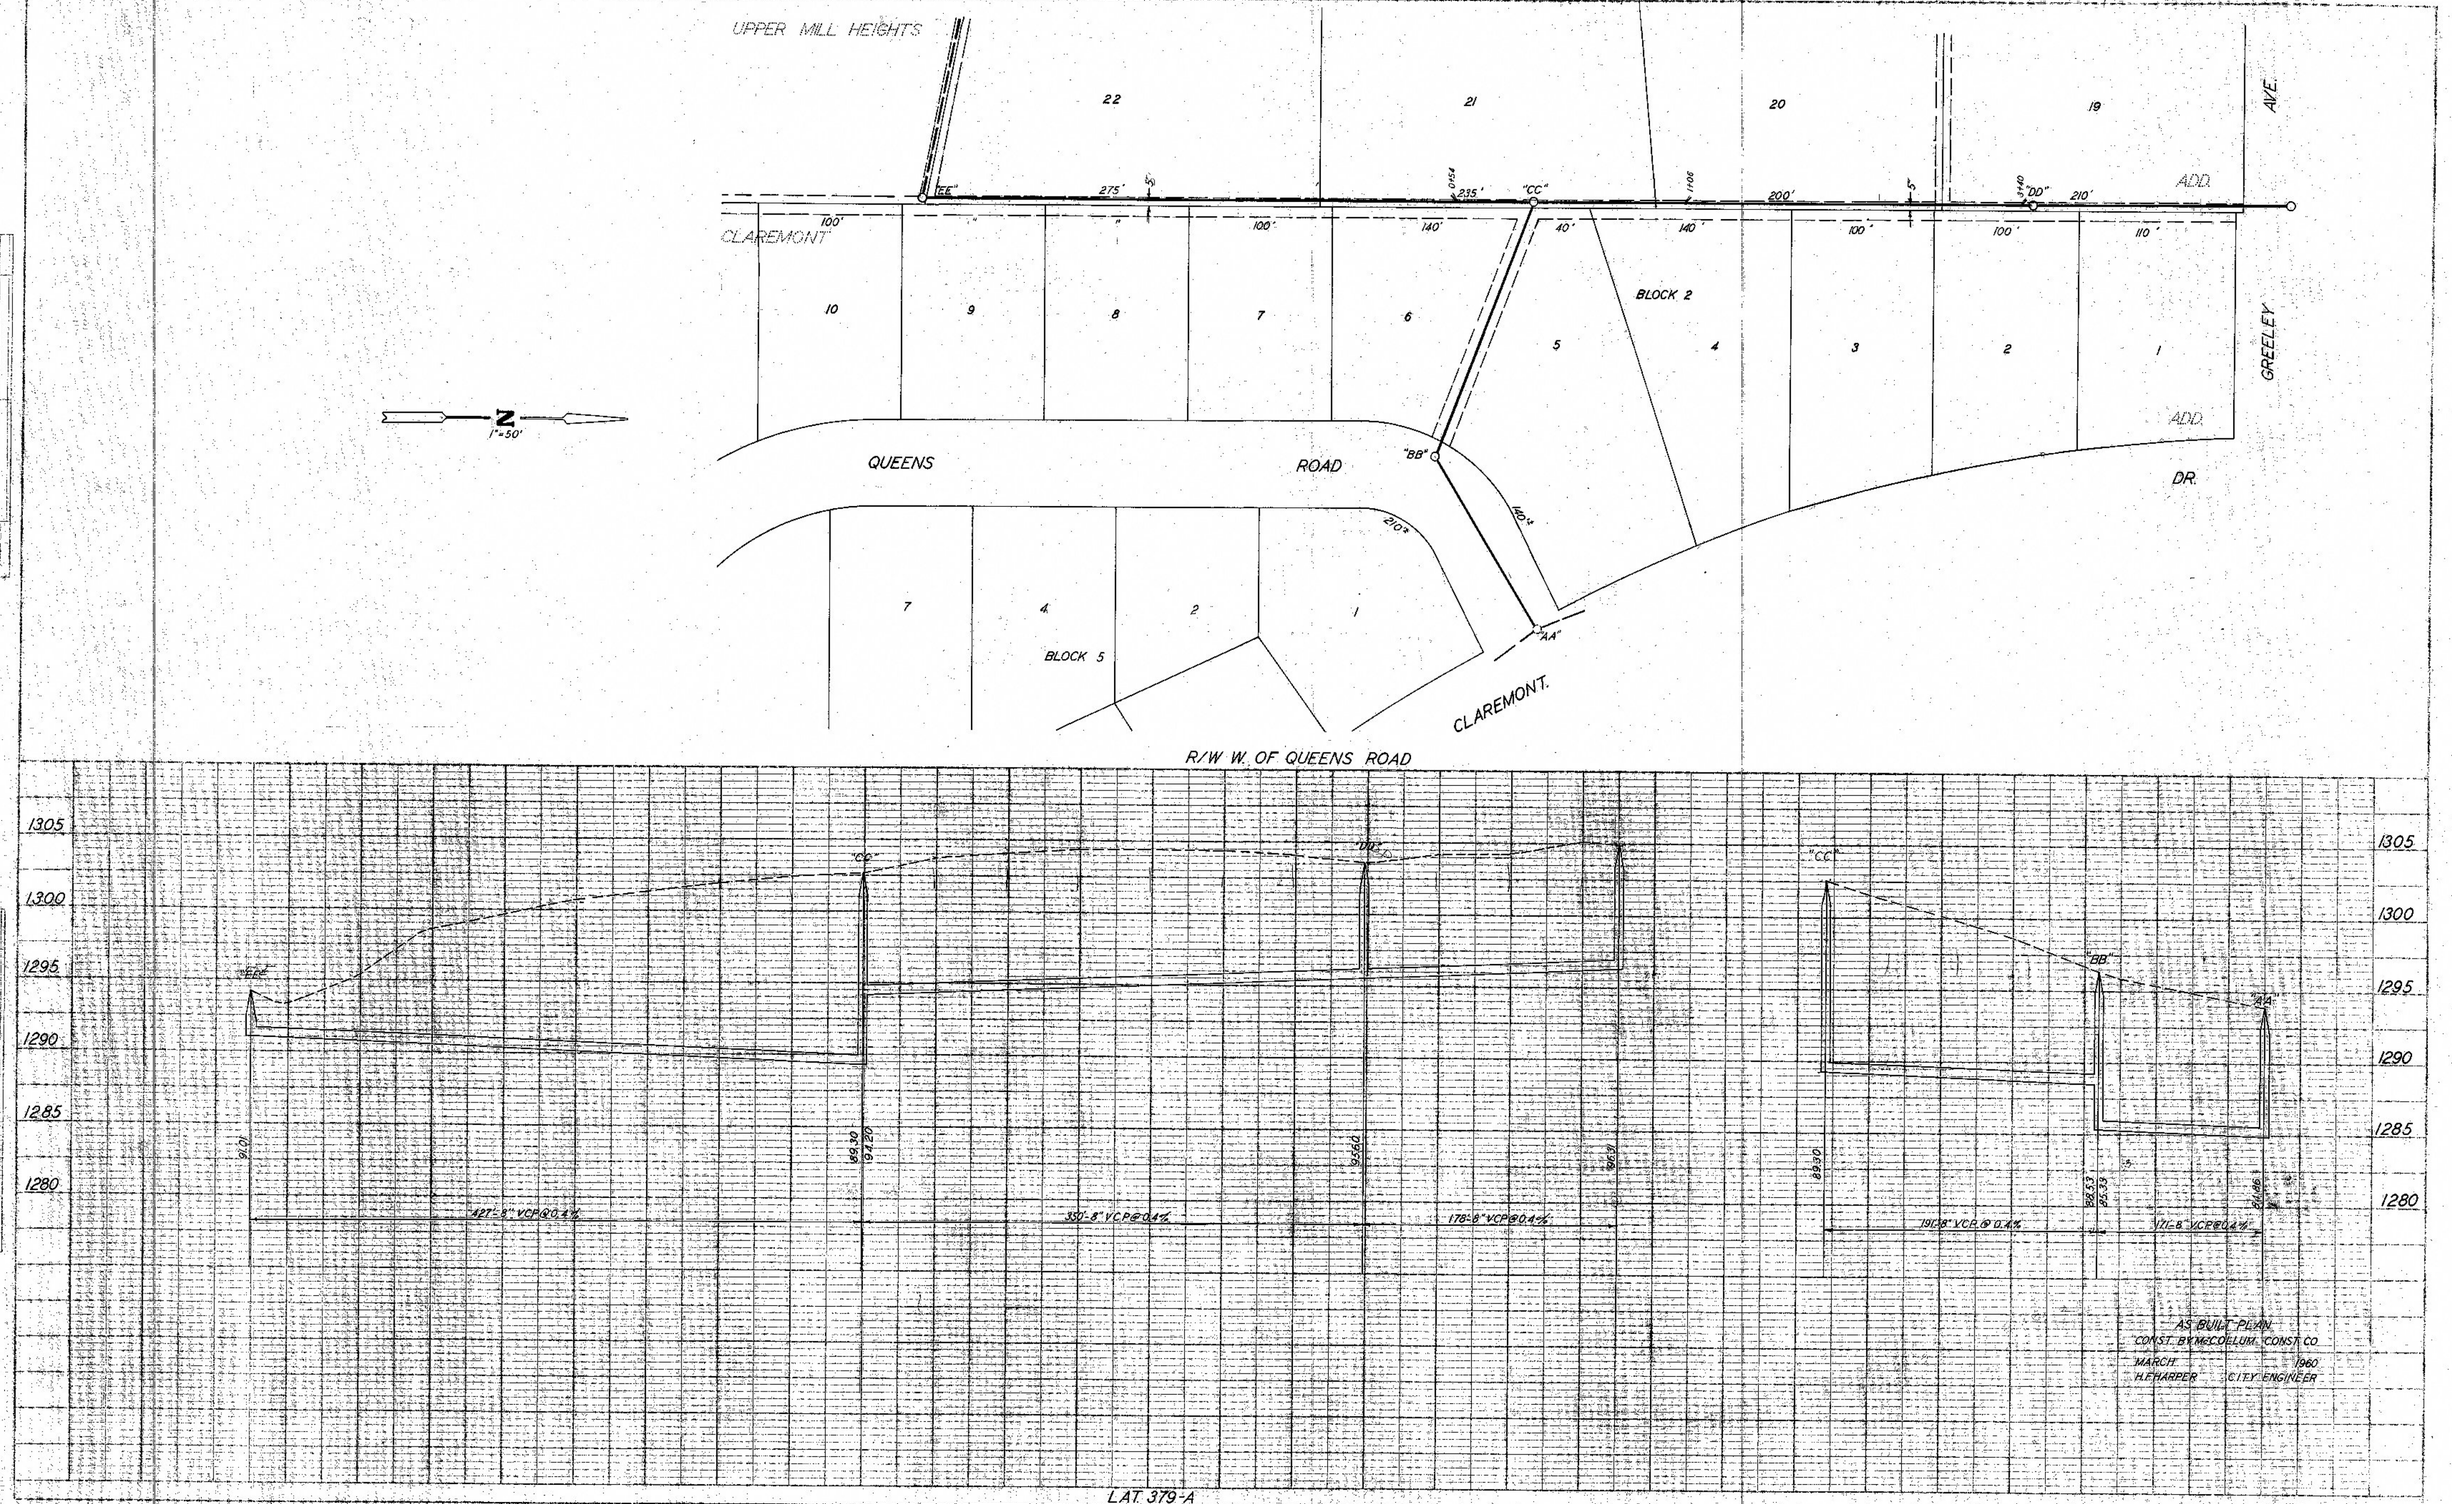

LAT. 379-A

K.A.E.Co. No. 1968-C