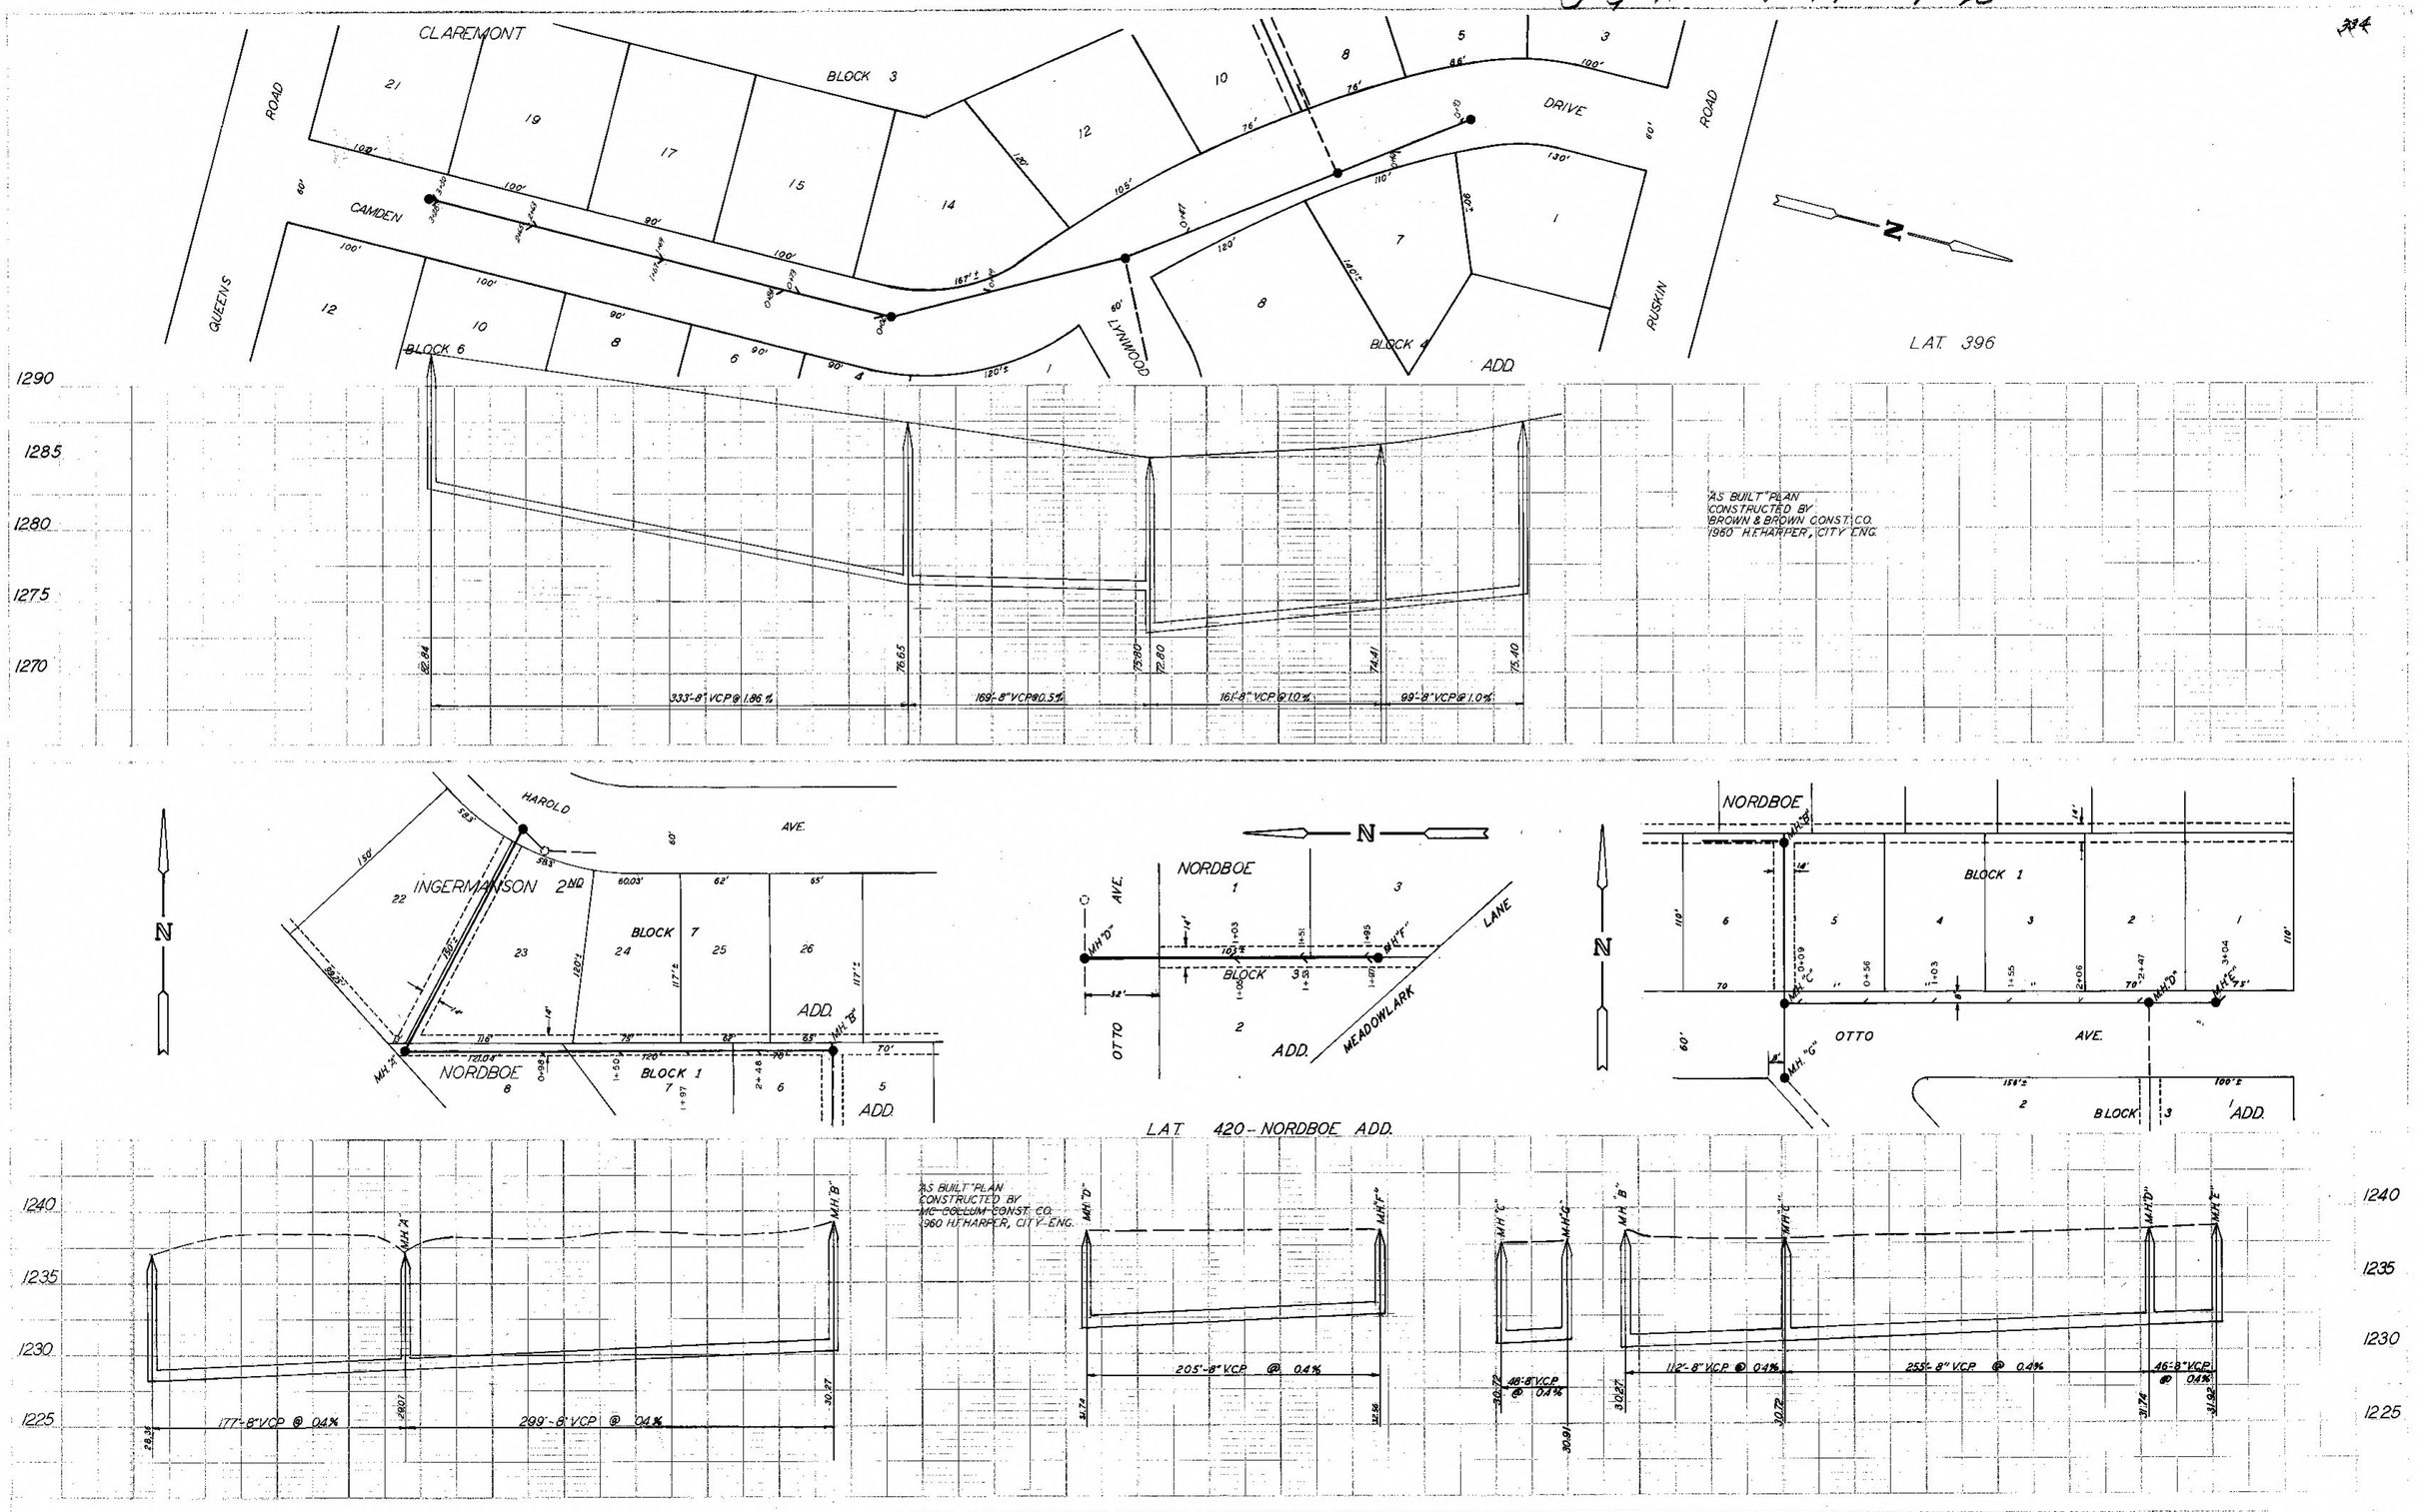
CLAREMONT
BLOCK 3
DRIVE
ROAD
CAMDEN
QUEENS
RUSKIN
LYNWOOD
BLOCK 6
BLOCK 4
ADD
LAT. 396
"AS BUILT" PLAN
CONSTRUCTED BY
BROWN & BROWN CONST. CO.
1960 H.F. HARPER, CITY ENG.
333'-8" VCP @ 1.86%
169'-8" VCP @ 0.5%
161'-8" VCP @ 1.0%
99'-8" VCP @ 1.0%
HAROLD
AVE.
INGERMANSON 2ND
BLOCK 7
ADD.
NORDBOE
BLOCK 1
OTTO
MEADOWLARK
LANE
LAT. 420 - NORDBOE ADD.
"AS BUILT" PLAN
CONSTRUCTED BY
MC-COLLUM CONST. CO.
1960 H.F. HARPER, CITY ENG.
177'-8" VCP @ 0.4%
299'-8" VCP @ 0.4%
205'-8" VCP @ 0.4%
48'-8" VCP @ 0.4%
112'-8" VCP @ 0.4%
255'-8" VCP @ 0.4%
46'-8" VCP @ 0.4%