GG93 P-14 F-2
393
343

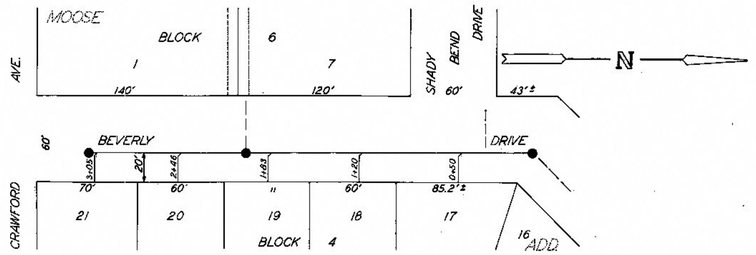

SANITARY SEWER - BEVERLY - CRAWFORD TO SHADY BEND

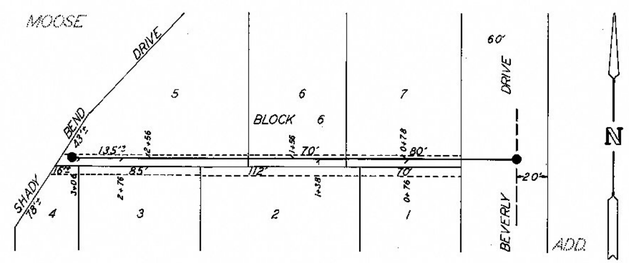

SANITARY SEWER - R/W N. OF CRAWFORD - BEVERLY TO SHADY BEND

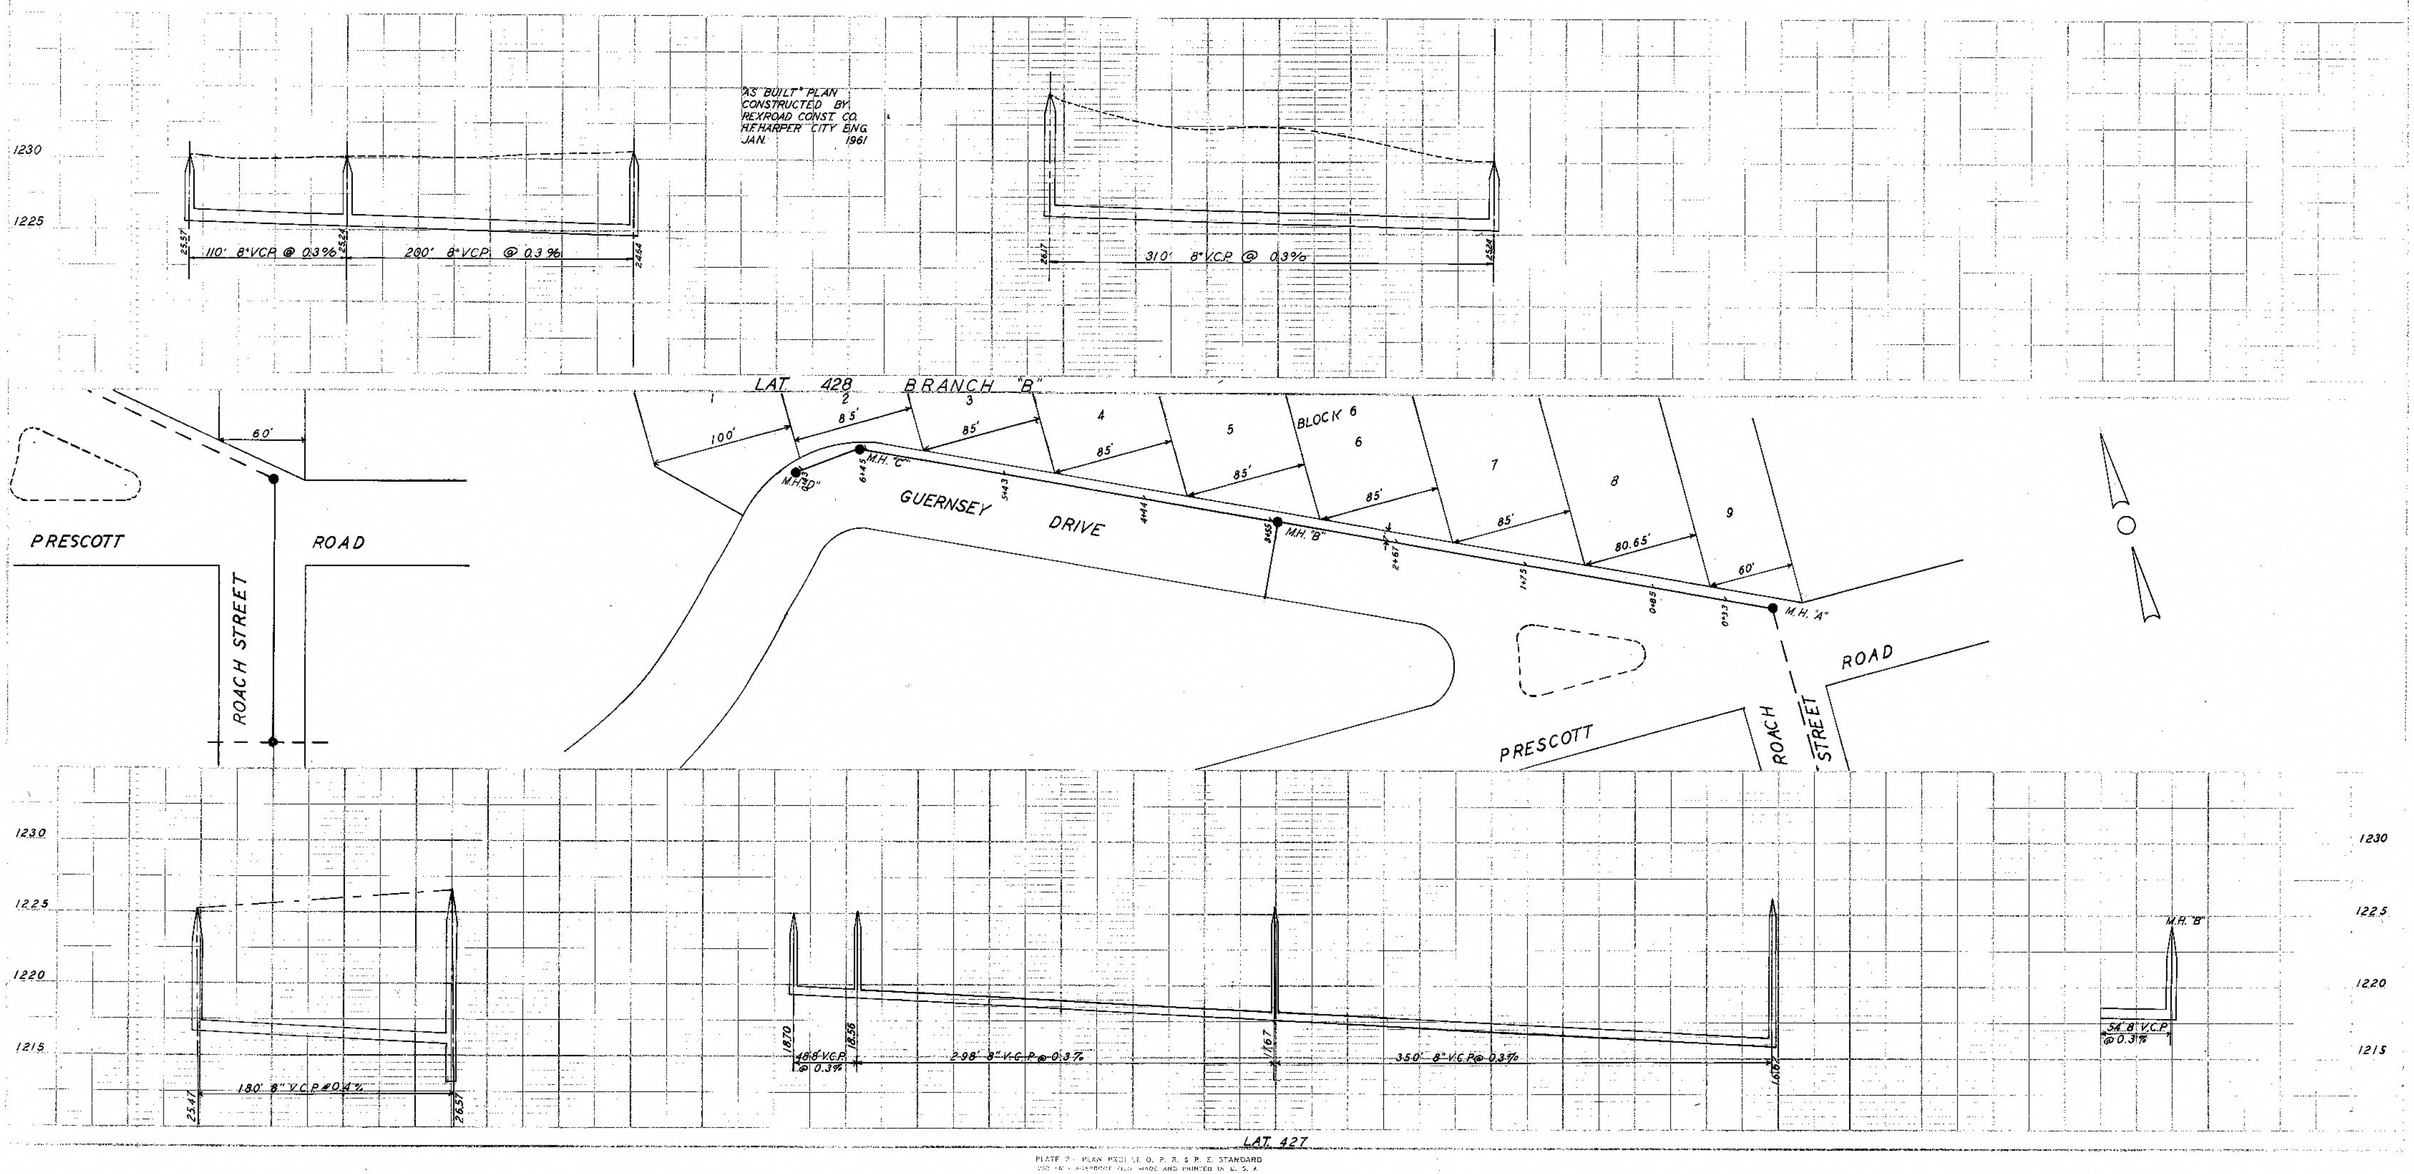

PLATE 2 - PLAN PROFILE O. P. A. & P. E. STANDARD
