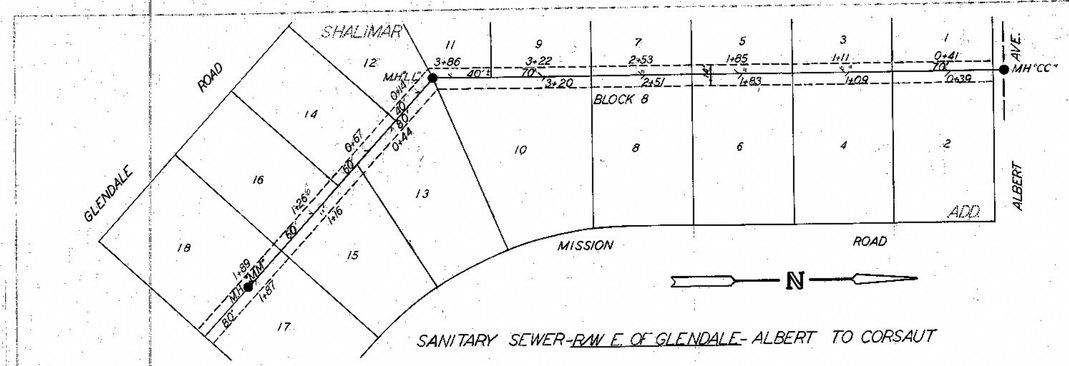

SANITARY SEWER-R/W E. OF GLENDALE- ALBERT TO CORSAUT

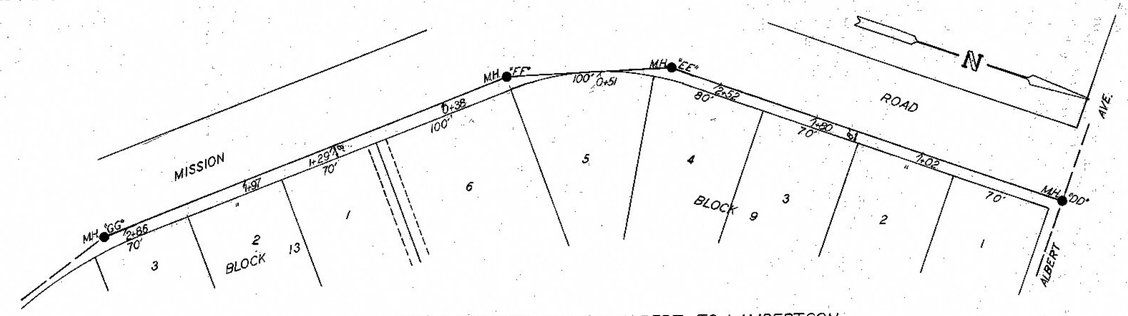

SANITARY SEWER-MISSION-ALBERT TO LAMBERTSON

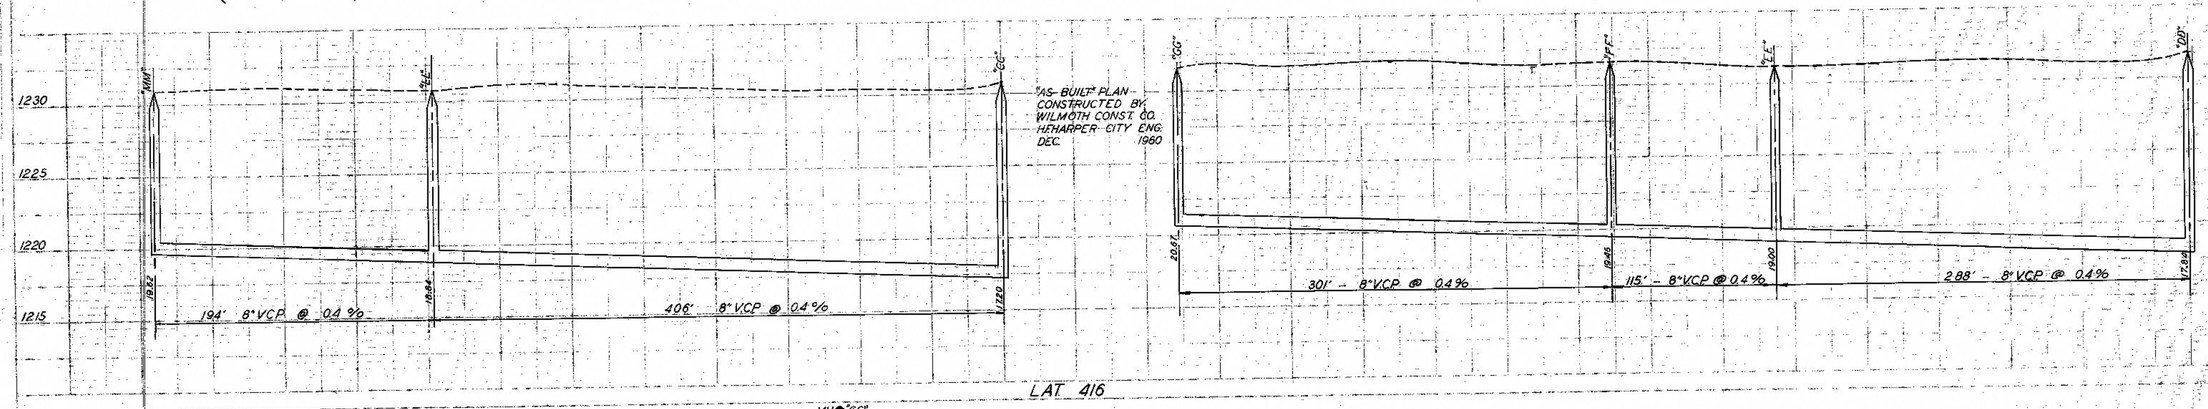

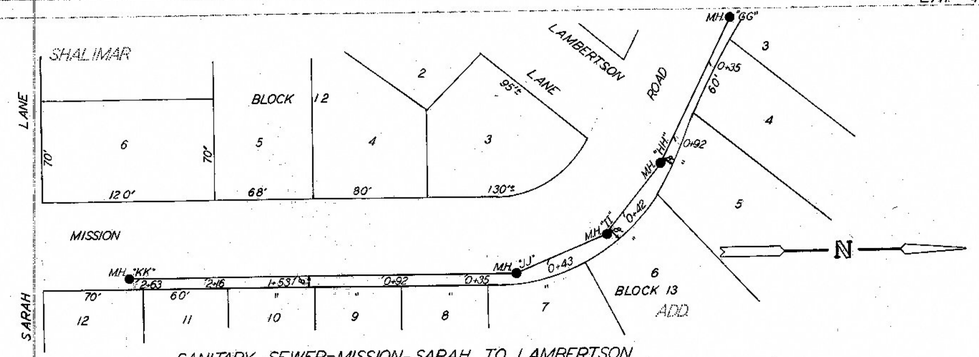
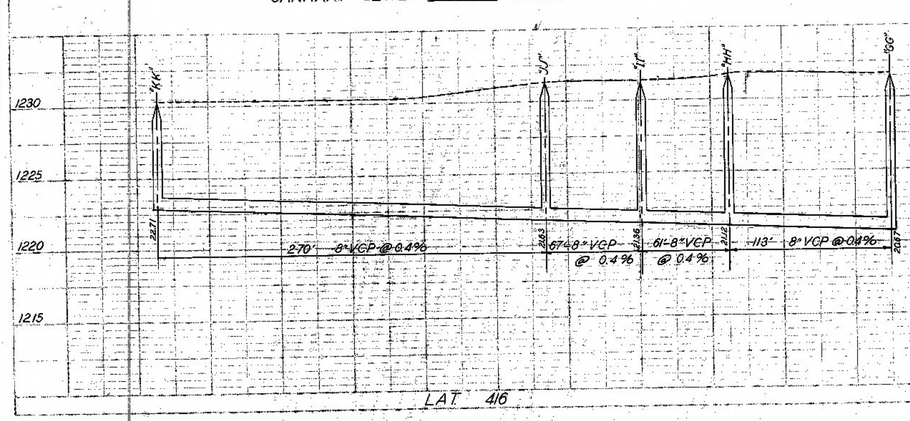
SANITARY SEWER-MISSION- SARAH TO LAMBERTSON