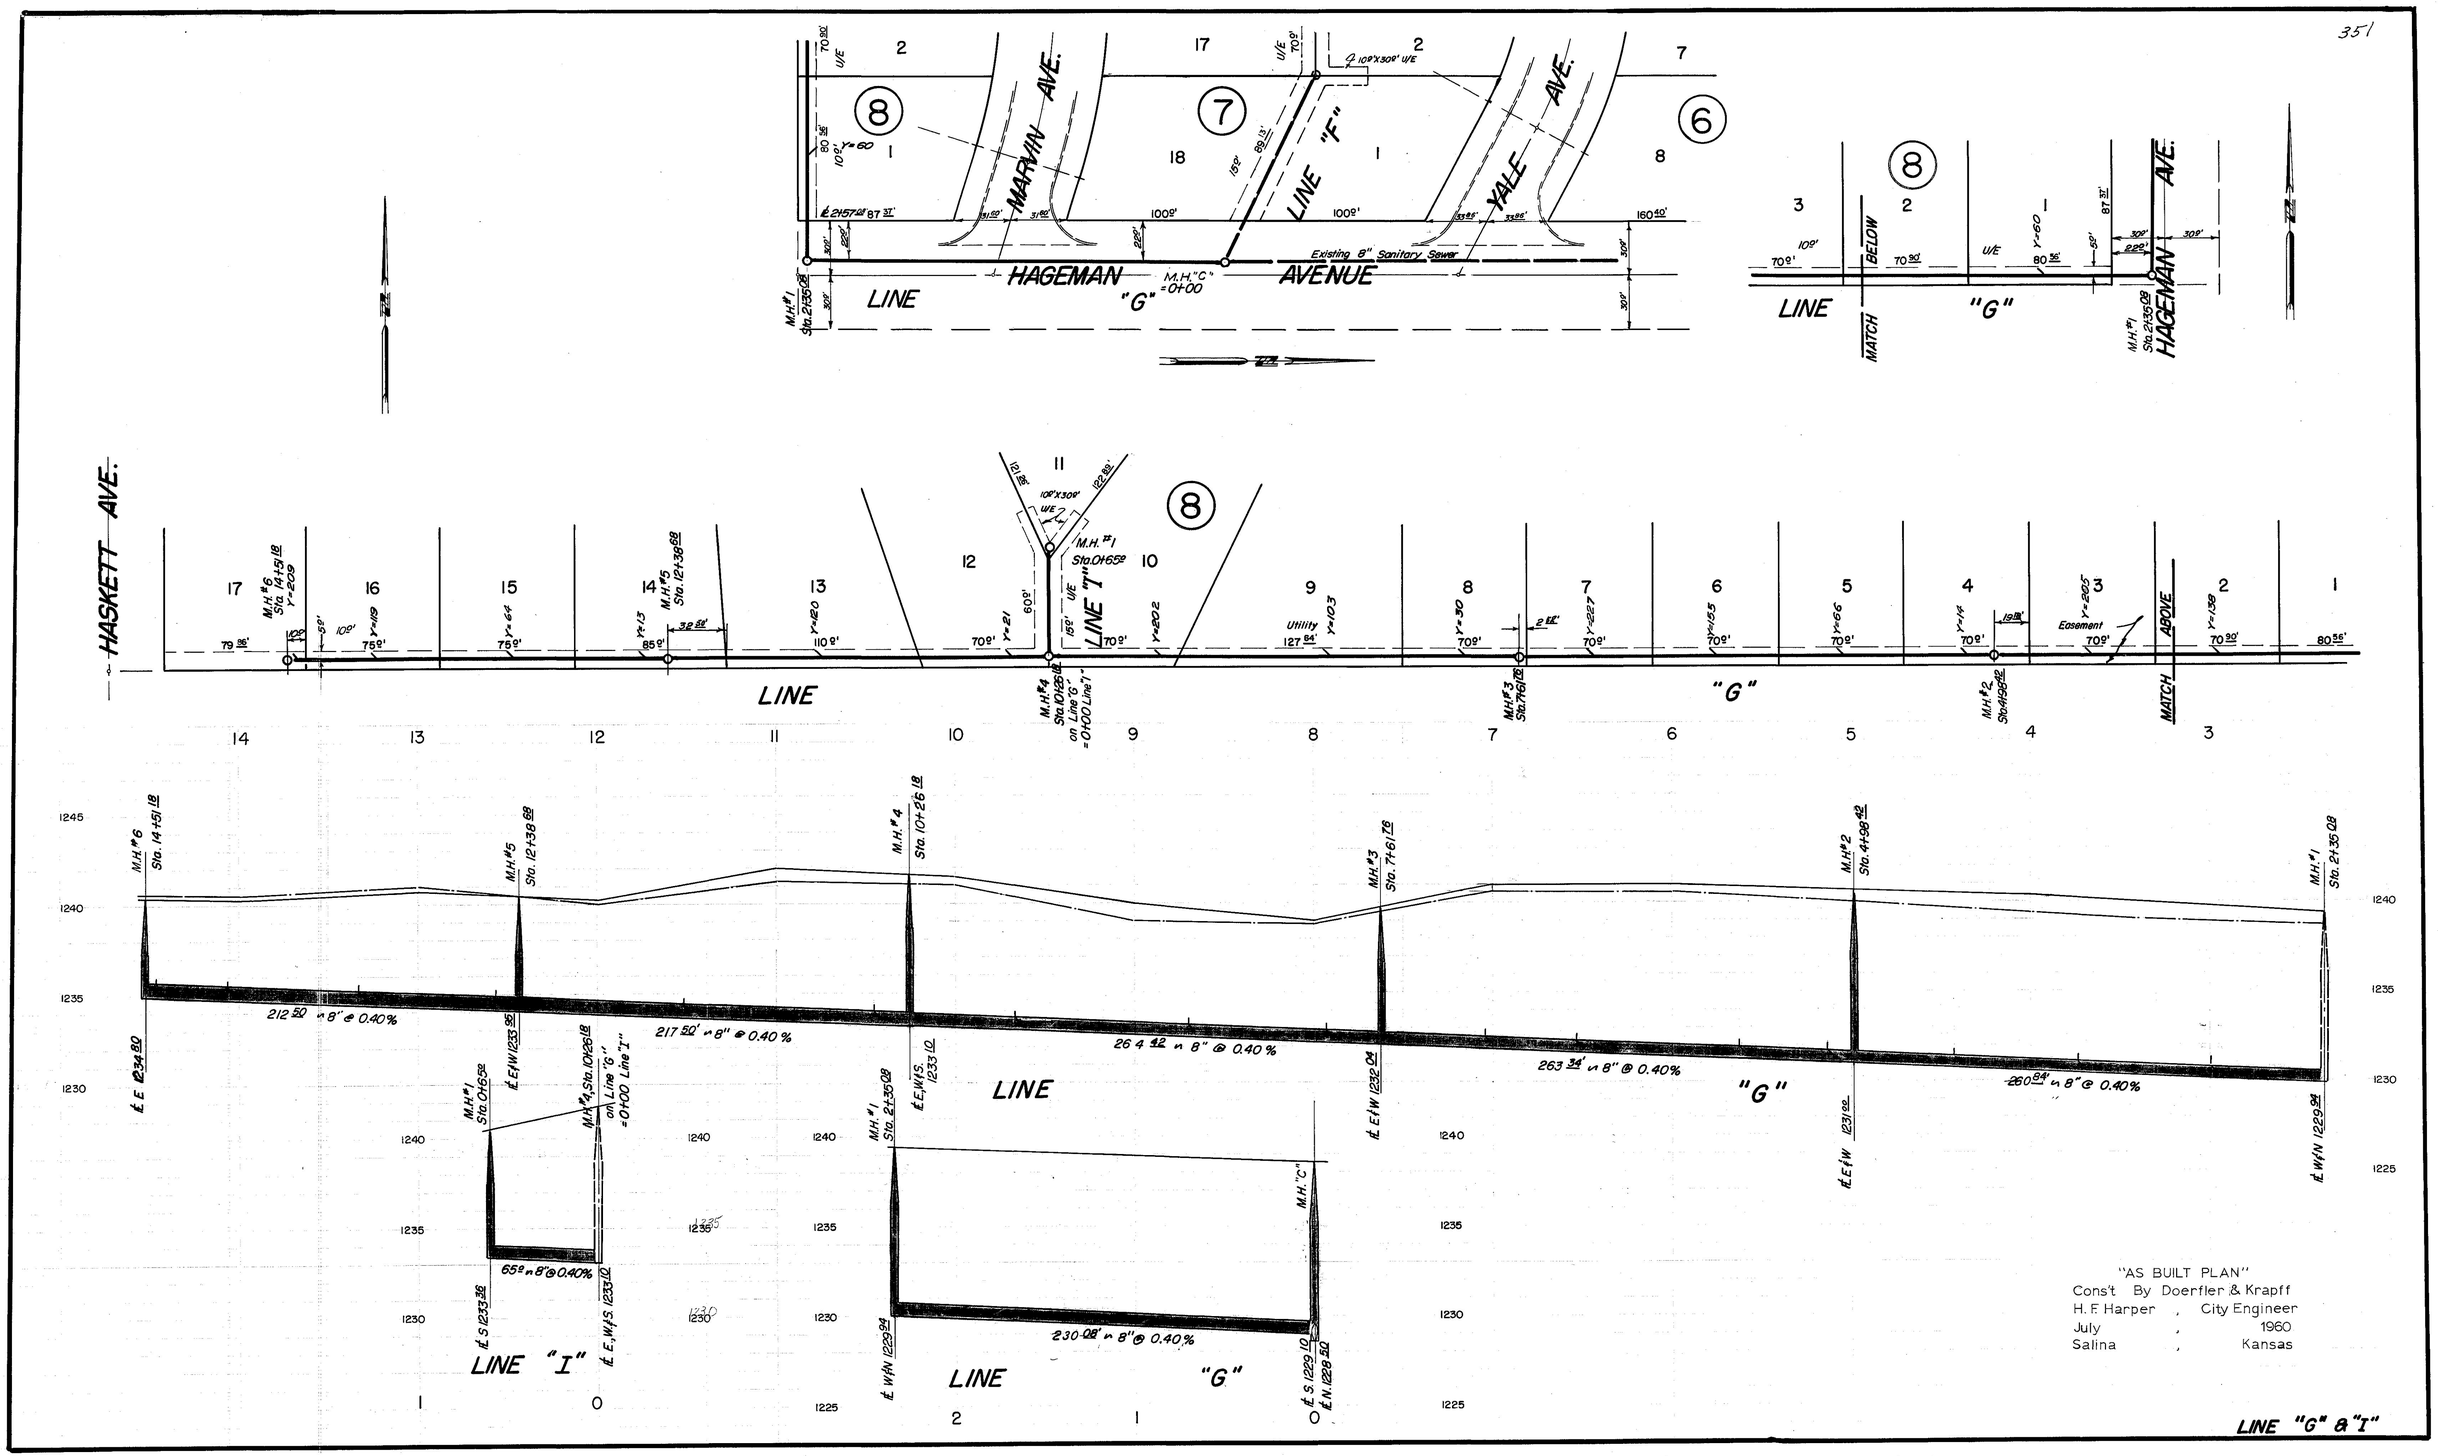

JARVIS ADDITION
Sewer Plans Sheet 6 of 6 Sheets