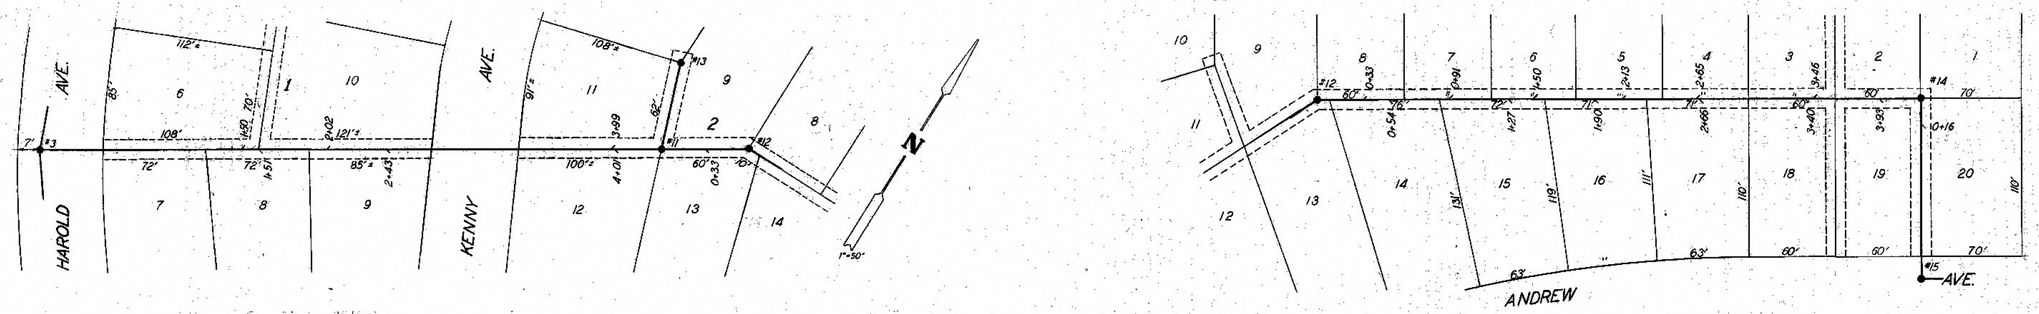

SANITARY SEWER - BLOCKS 1&2 INGERMANSON HEIGHTS 2ND ADD.

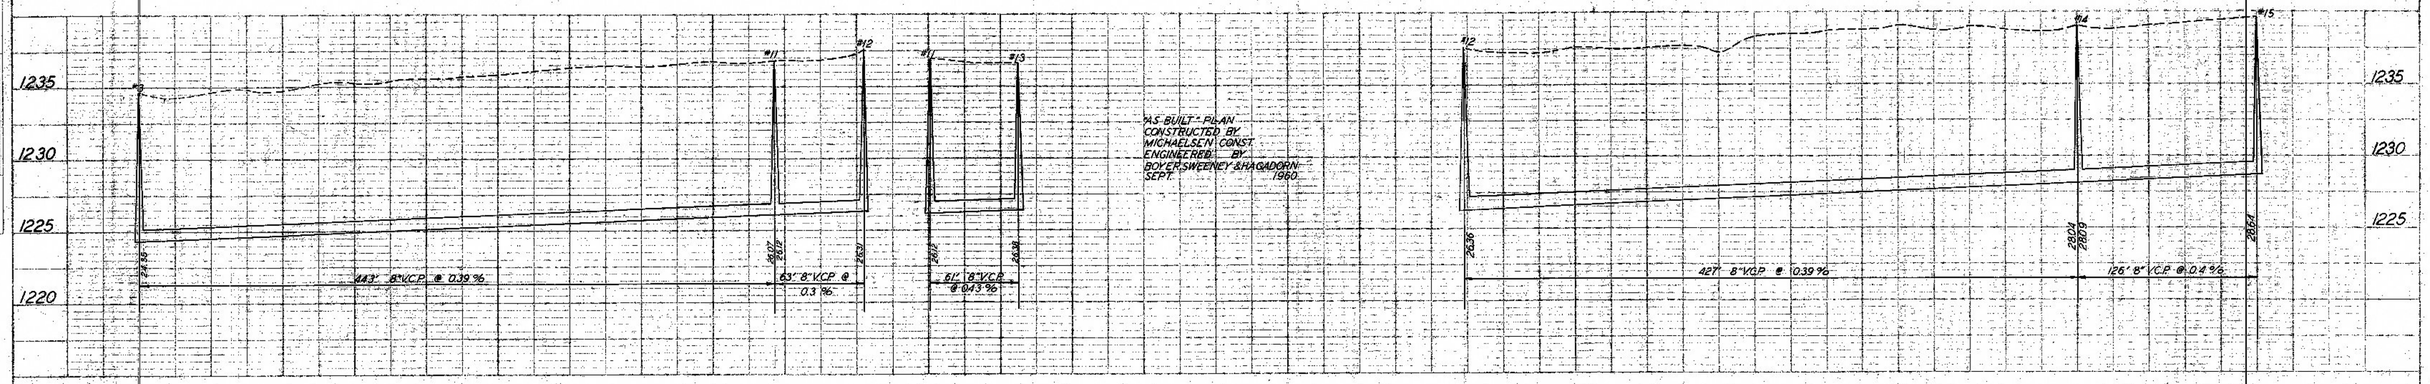

AS BUILT PLAN
CONSTRUCTED BY
MICHAELSEN CONST.
ENGINEERED BY
BOYER SWEENEY & HAGADORN
SEPT. 1960

PLAN
SURVEYED
PLOTTED
NOTE BOOK
RT. OF WAY CHECK
NO.

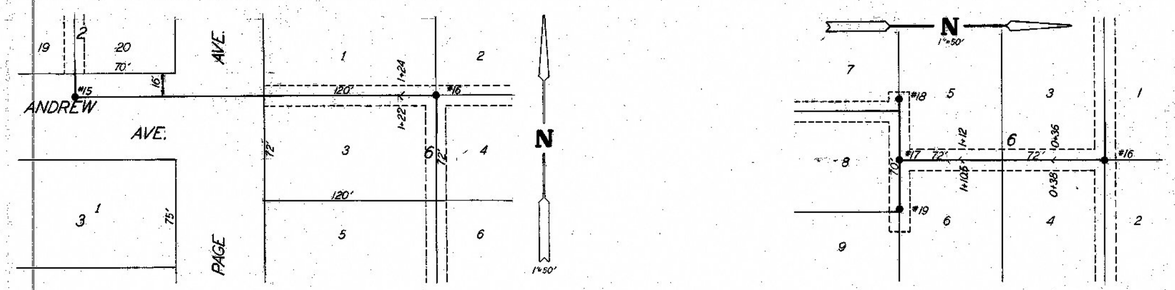

SANITARY SEWER-BLOCK 6 INGERMANSON HEIGHTS 2ND ADD.

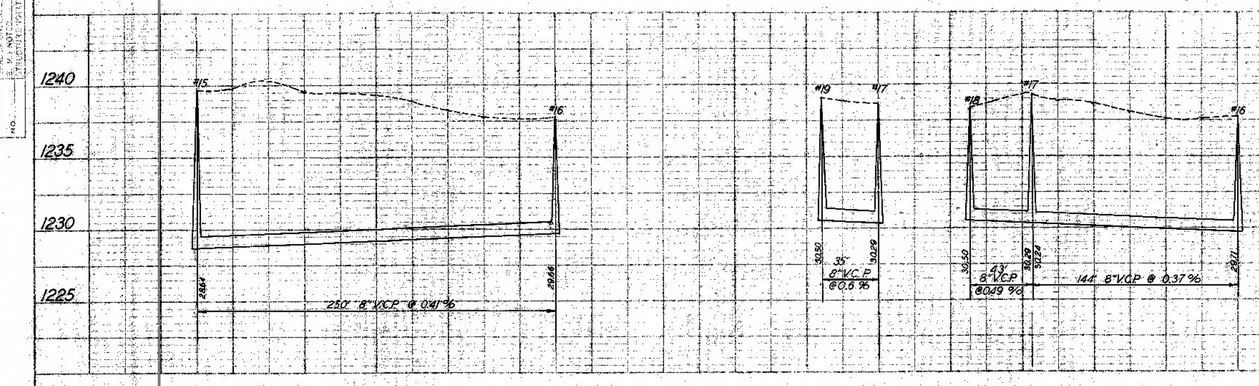

PROFILE
SURVEYED
PLOTTED
NOTE BOOK
RT. OF WAY CHECK
NO.