362

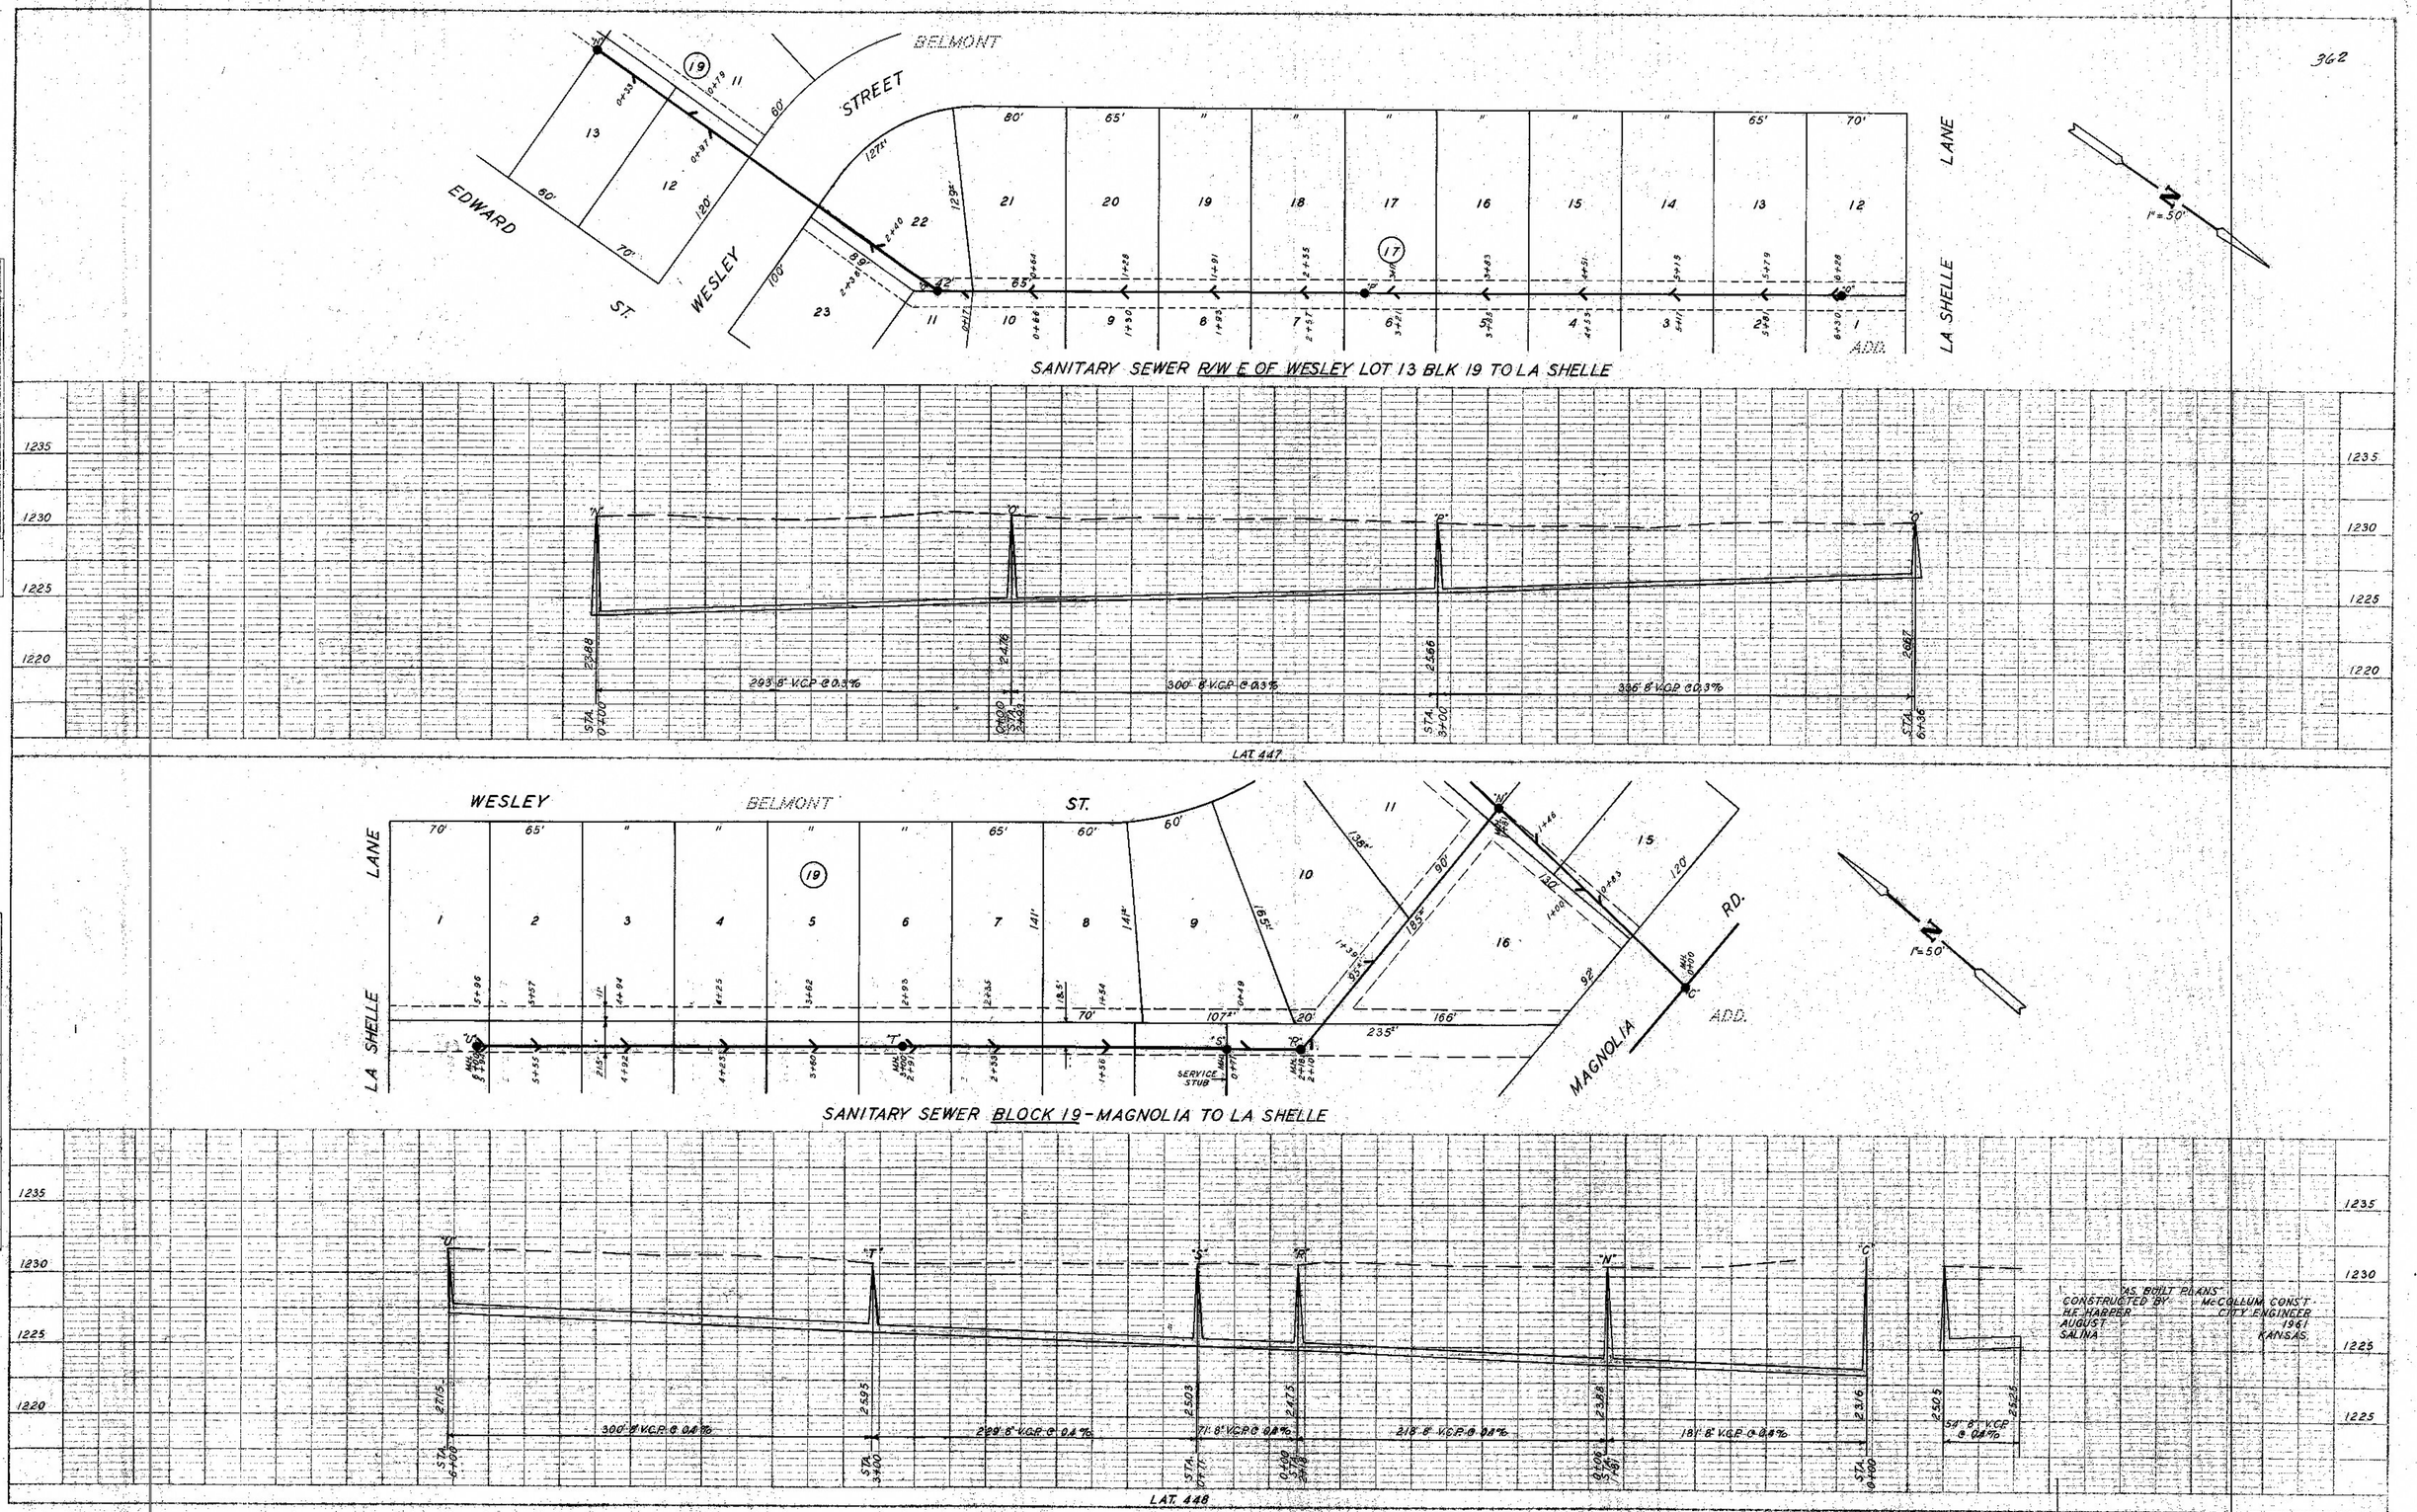

PLATE 2 - PLAN - PROFILE C.F.B. & R.O. STANDARD
NEUTEL & EGGERS CO., NEW YORK

N & E Co. No. 345-2C