


DATE	
BY	
REVISIONS	
NOTED	
PLANNING	
ENGINEER	
NO. OF WAY CHECKED	
NO.	

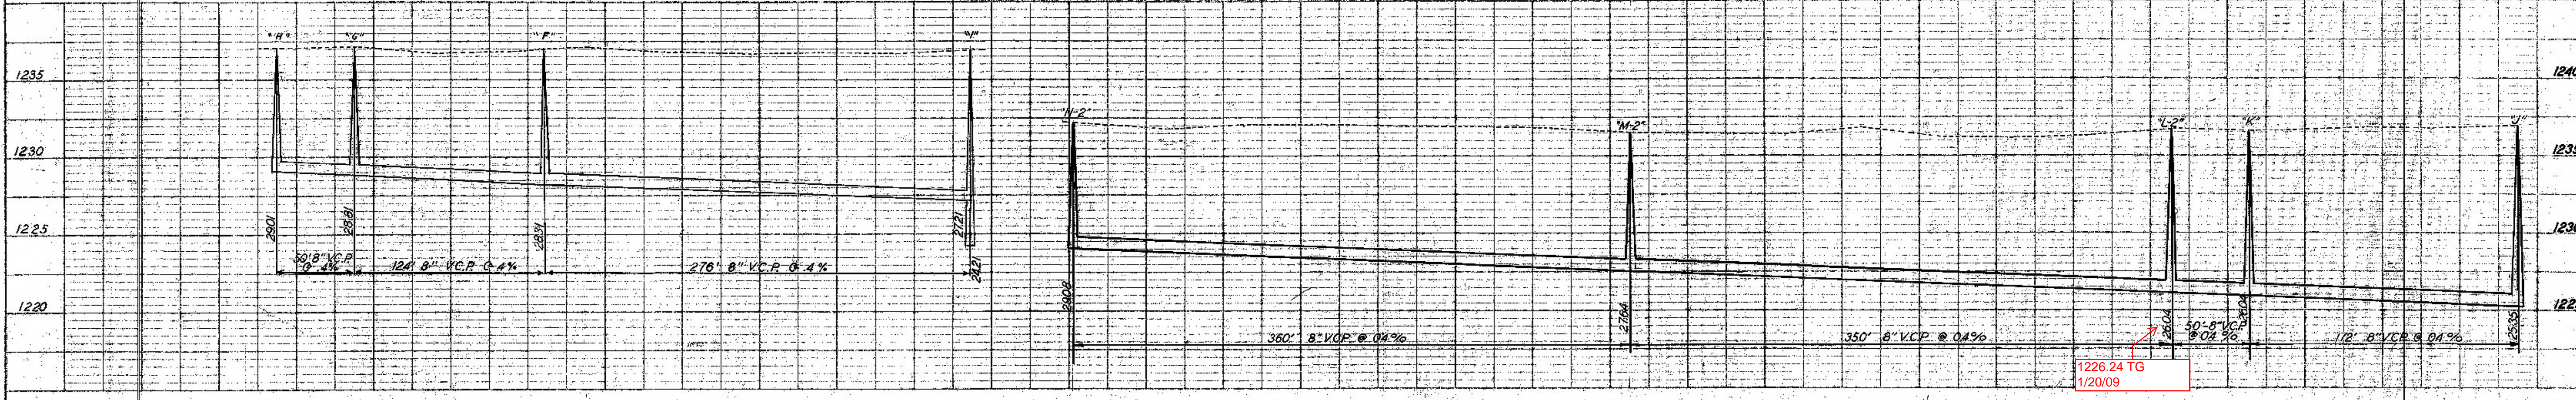

DATE	
BY	
REVISIONS	
NOTED	
PLANNING	
ENGINEER	
NO. OF WAY CHECKED	
NO.	

