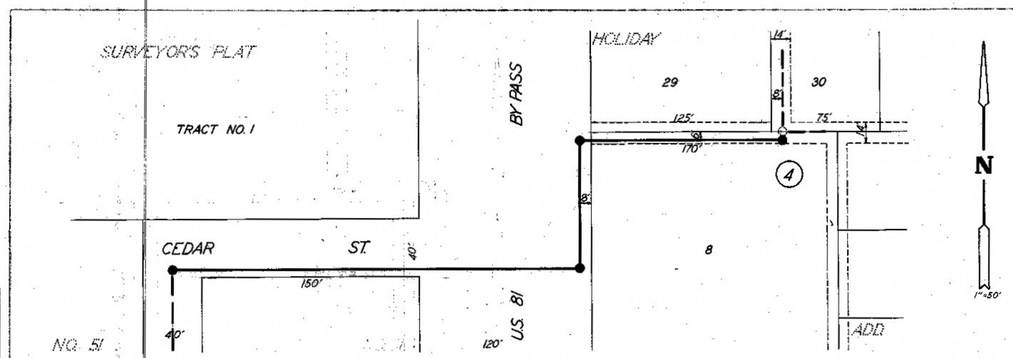

SANITARY SEWER - CEDAR - SMITHER TO R/W E. OF U.S. 81 BY PASS

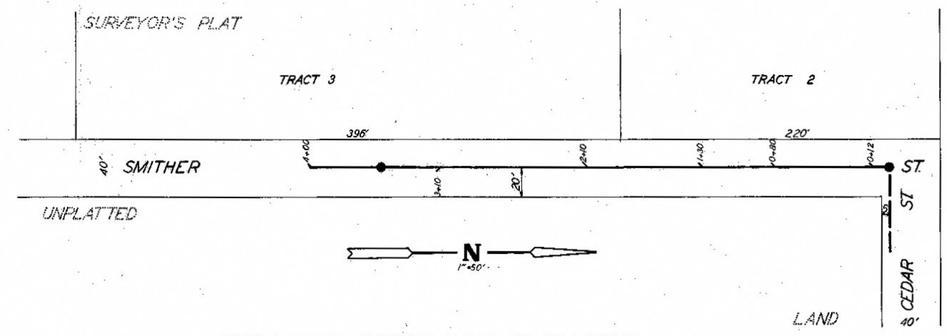

SANITARY SEWER - SMITHER - CEDAR TO 400' SOUTH

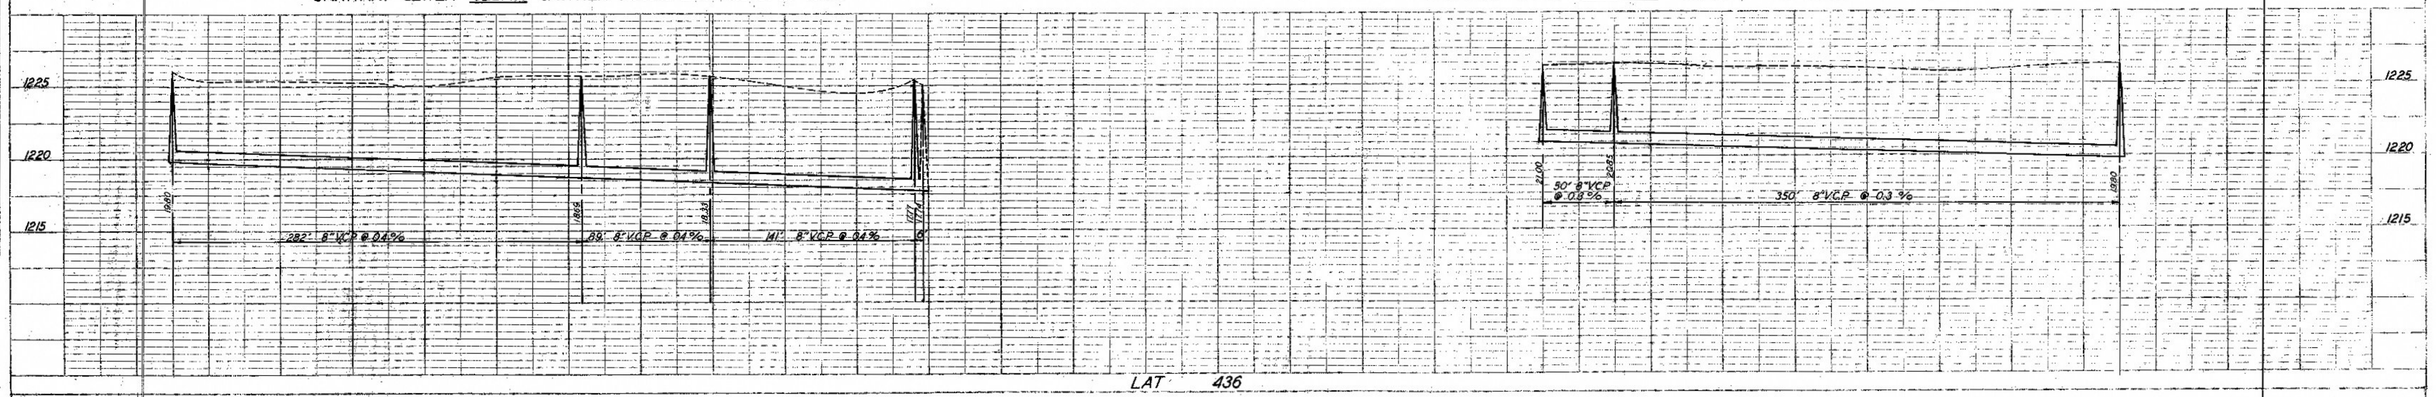

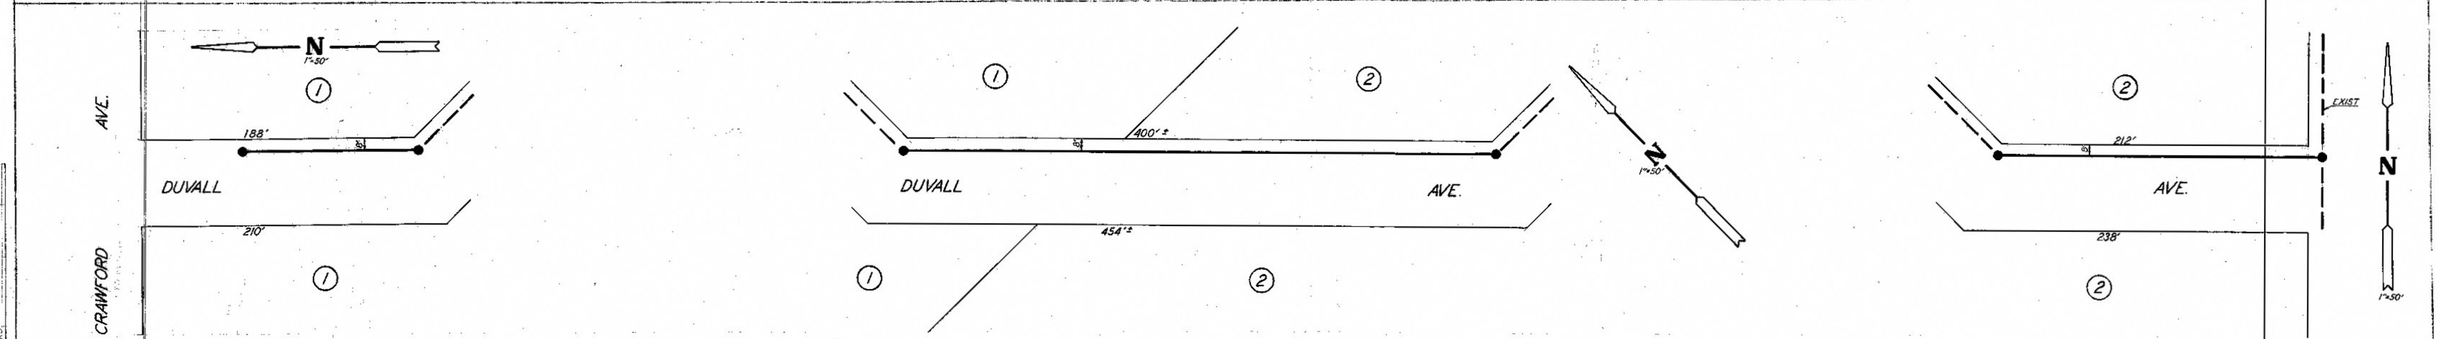

SANITARY SEWER - BLOCKS 1&2 BANKERS ADD.

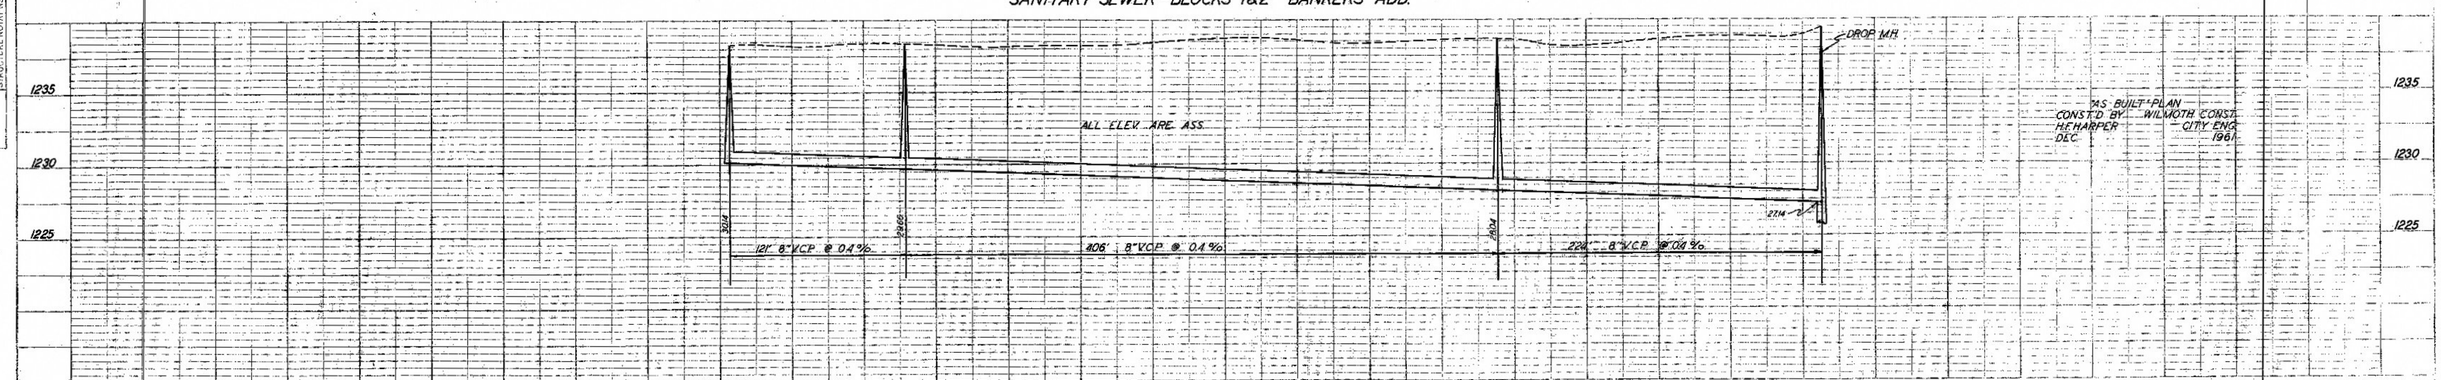

PLAN — SURVEYED, PLOTTED, NOTE BOOK, SIGNATURE, NO., DATE, BY

PROFILE — SURVEYED, PLOTTED, NOTE BOOK, PLANES CHECKED, NO., DATE, BY, STRUCTURE NOTATIONS CHECKED