




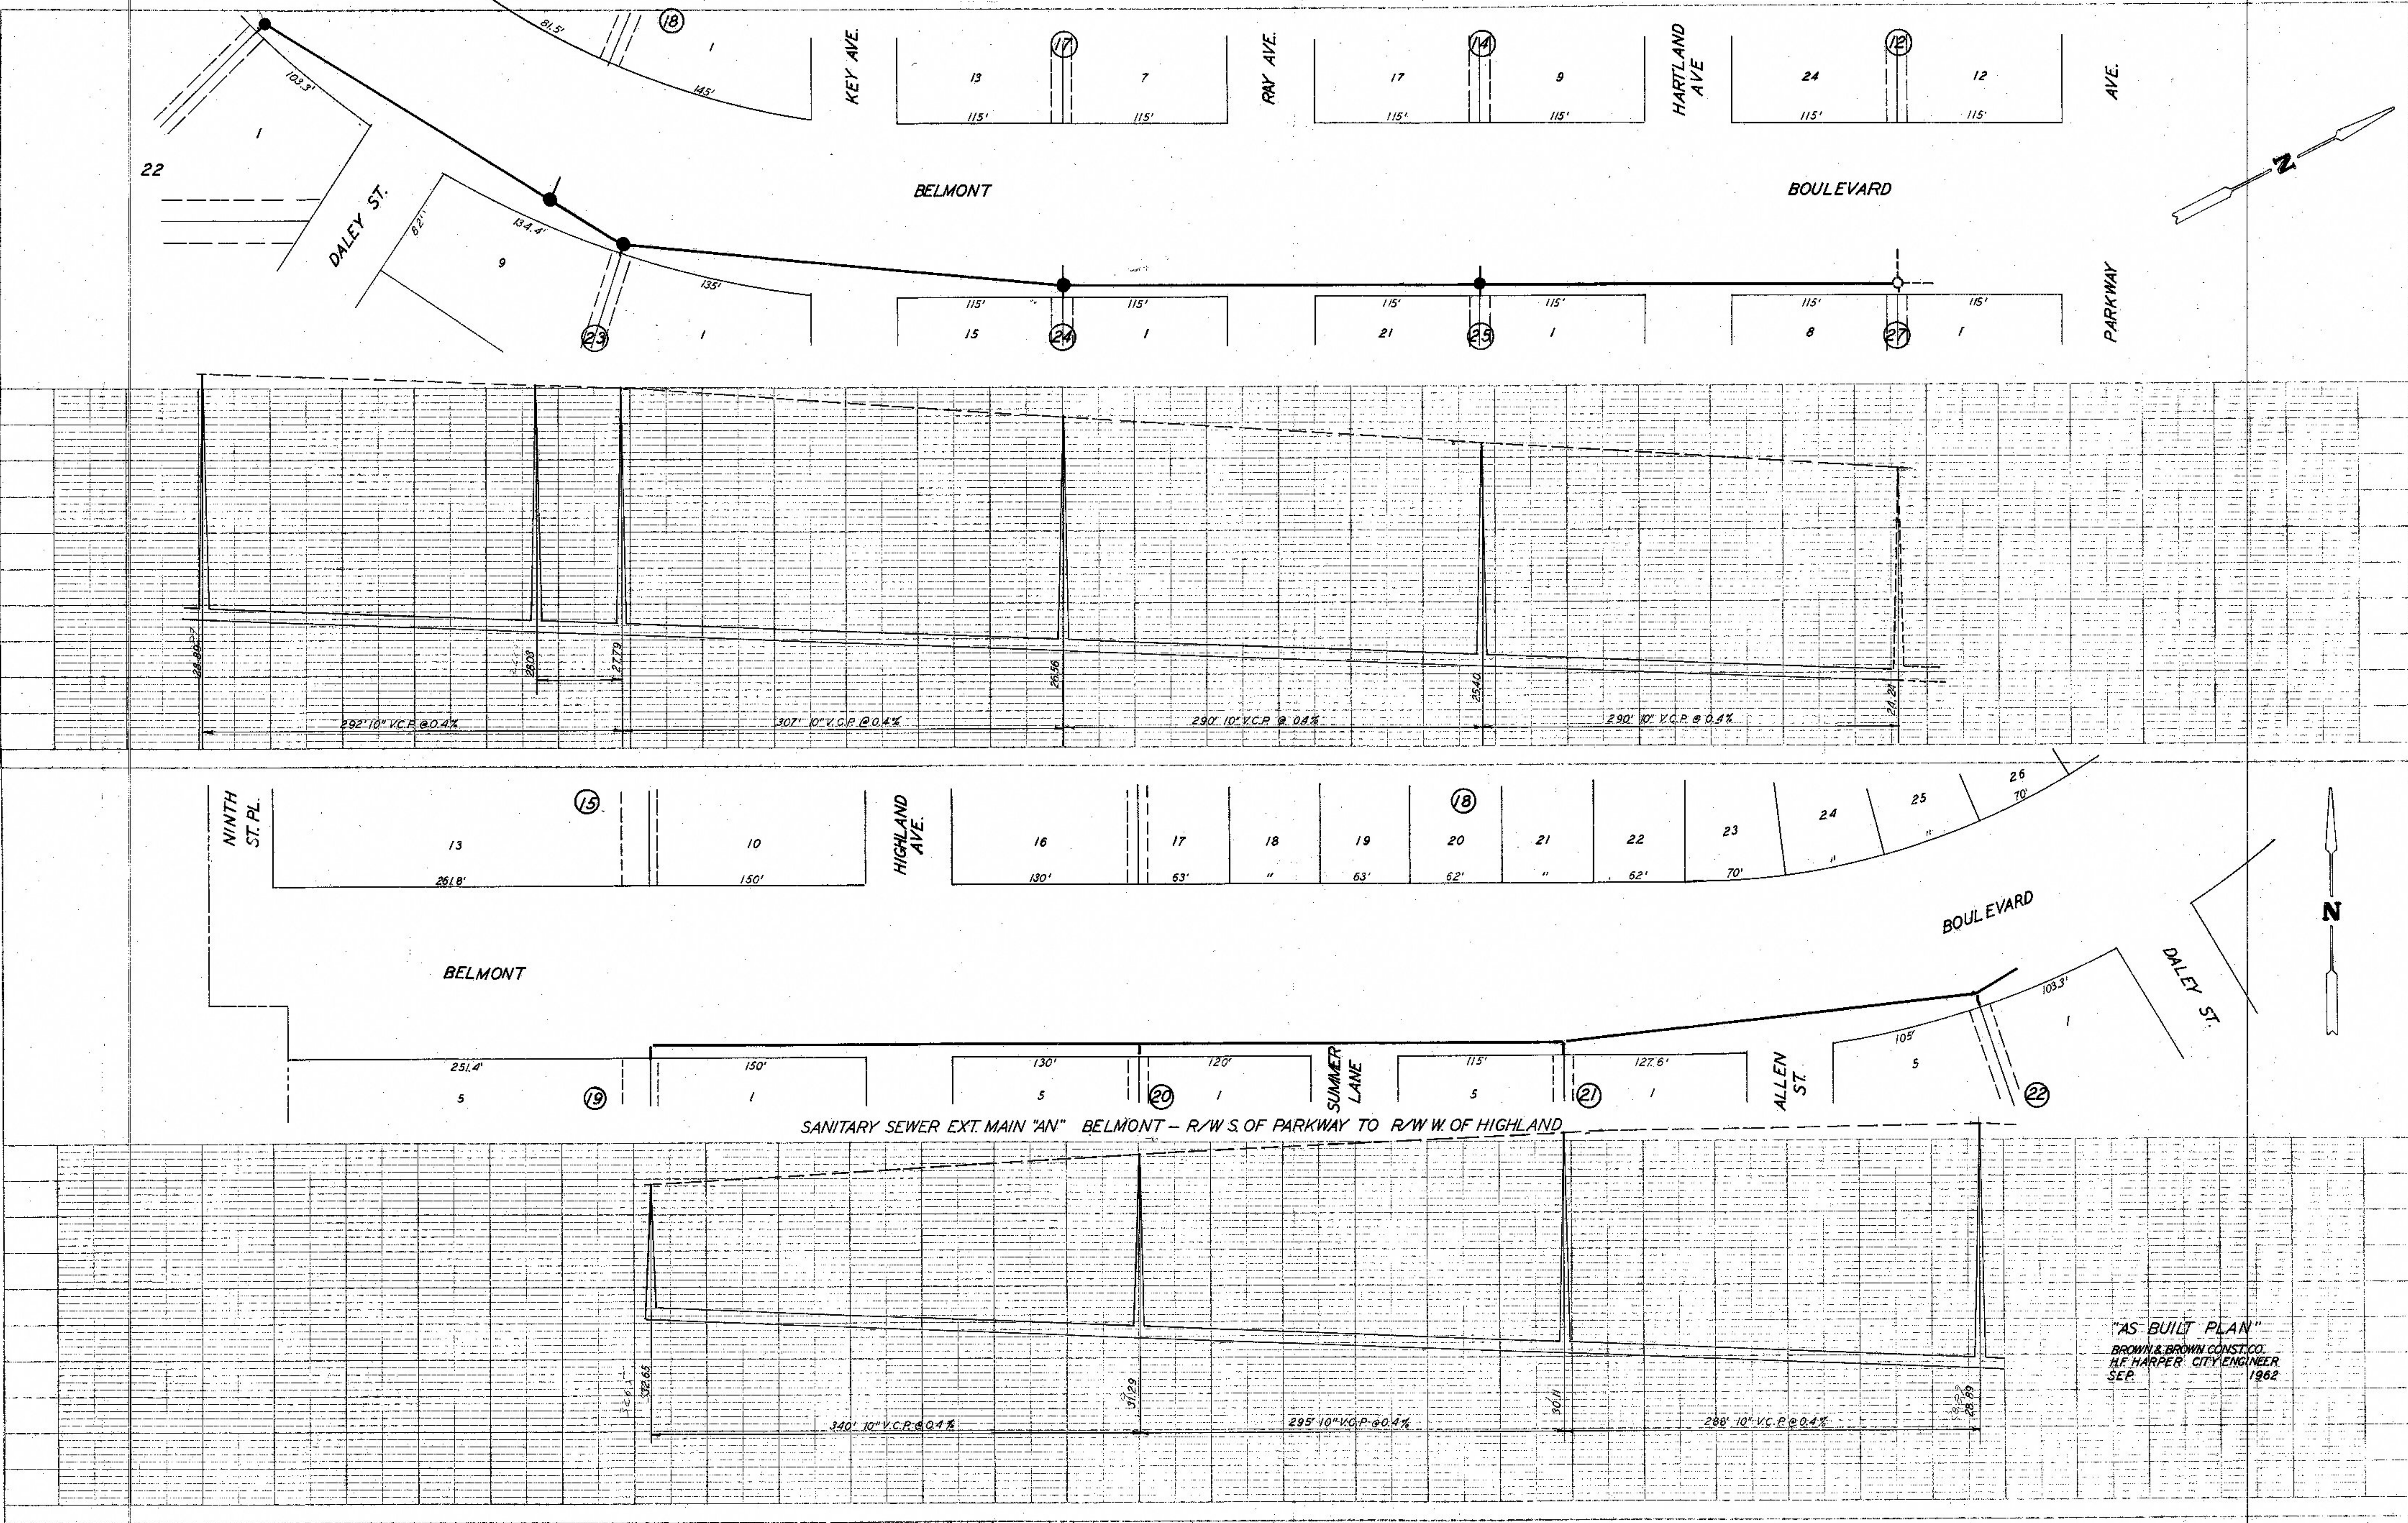

SANITARY SEWER EXT. MAIN "AN" BELMONT - R/W S OF PARKWAY TO R/W W OF HIGHLAND

"AS BUILT PLAN"
 BROWN & BROWN CONST. CO.
 H.F. HARPER, CITY ENGINEER
 SEP. 1962